

Lloyd's Register of British and Foreign Shipping.

(Report on Vessel No. 111/64 Port Glasgow)

"Countess,"

No. 5759 SHIP FORGINGS OR CASTINGS.

The words FORGINGS or CASTINGS, IRON or STEEL, should be struck out as may be required.

I have to report that the undermentioned Iron or Steel Forgings or Castings manufactured by The Irvine Forge Co of Irvine for the Vessel No. 107, being built by Messrs Mackie & Thomson of Glasgow have been inspected by me as set forth below, and found to be, so far as can be seen, Sound & efficient


Mark on Forgings.

Lloyd's
No. 5759
WH.

William Hamilton
Glasgow
21/3/96

	STERN FRAME.	RUDDER FRAME.	STEM.
Material* ...		<u>Scrap iron</u>	
How made ...		<u>Forged</u>	
Dimensions ...		<u>4 5/8 to 3 1/2 + 2 7/8</u>	
Progress on Inspection		<u>Forging & smithing</u>	
Date when Inspected		<u>21/2/96 to 19/3/96</u>	

SKETCHES OF FRAMES SHOWING POSITION AND DESCRIPTION OF WELDS OF FORGINGS, OR PARTICULARS OF TESTS APPLIED TO CASTINGS.

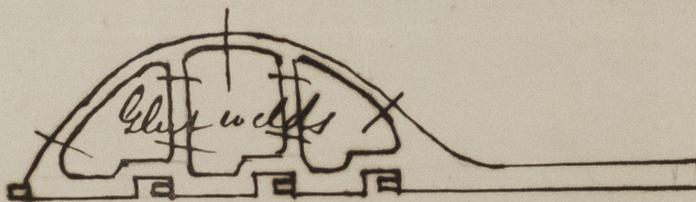

Fee (if any chargeable) £ : :

To be paid at



© 2021

Lloyd's Register
Foundation

No 107

Rudder frame

1828
MM

2122

[Faint handwritten notes, possibly describing dimensions or materials]

[Faint handwritten note]

[Faint handwritten note]

[Faint handwritten notes, possibly describing dimensions or materials]



© 2021

Lloyd's Register
Foundation