



- STEEL SCREW STEAMER TO CLASS + 100 A.1.

— AT LLOYDS.

— 178'-0" B.P.  $\times$  26'-10" MLD  $\times$  13'-0" MLD TO MAIN DK.

SCALE  $\frac{1}{2}$  INCH = ONE FOOT.

25. 11. 95

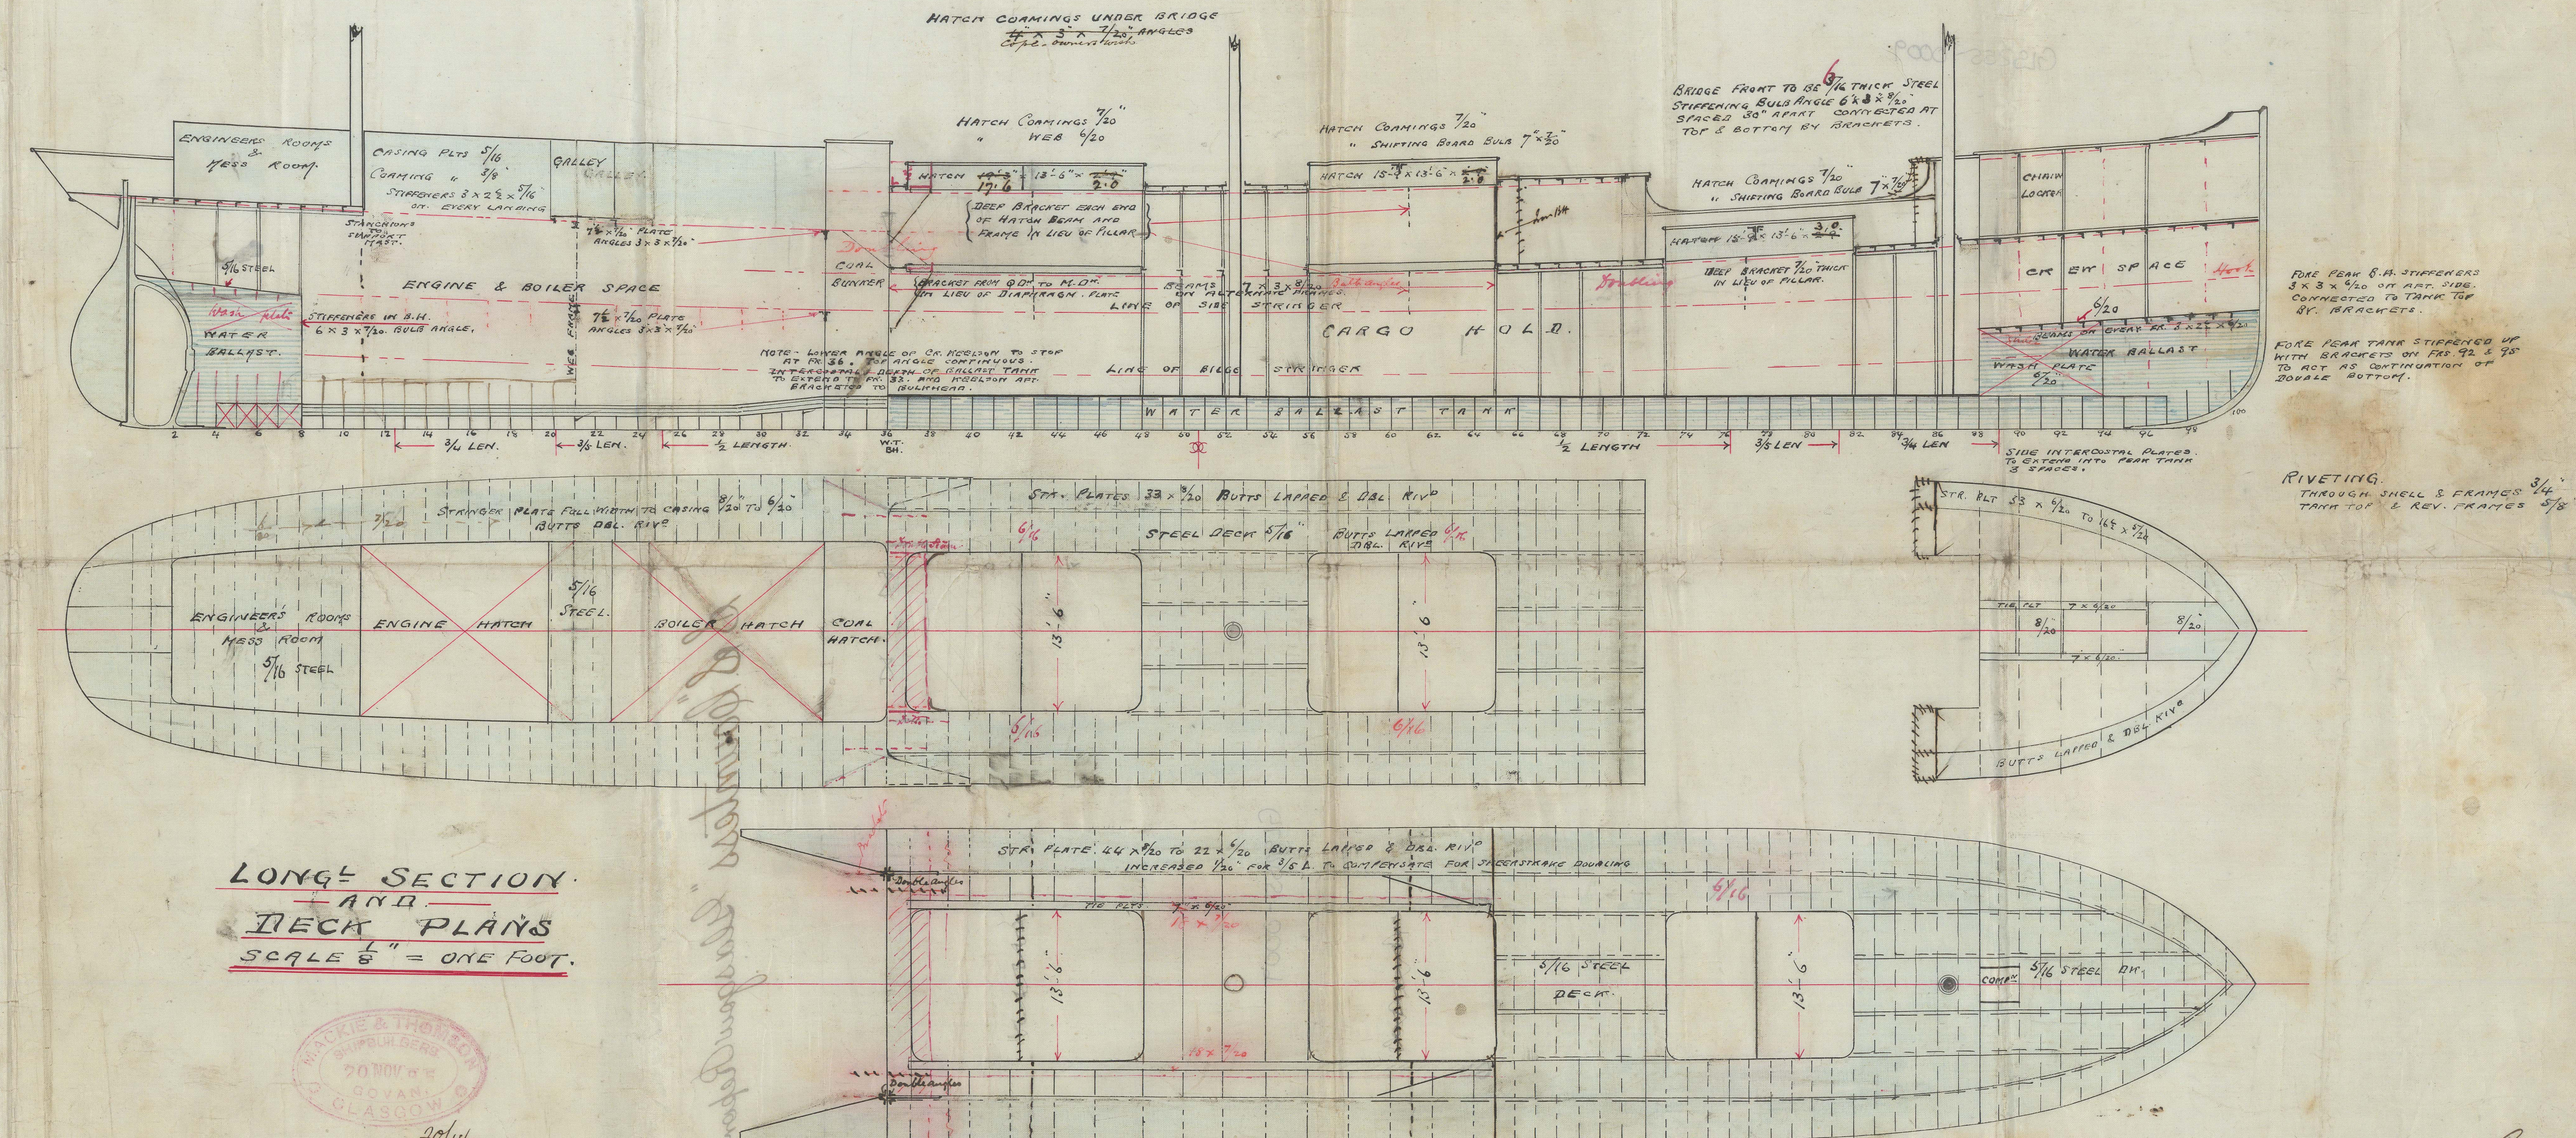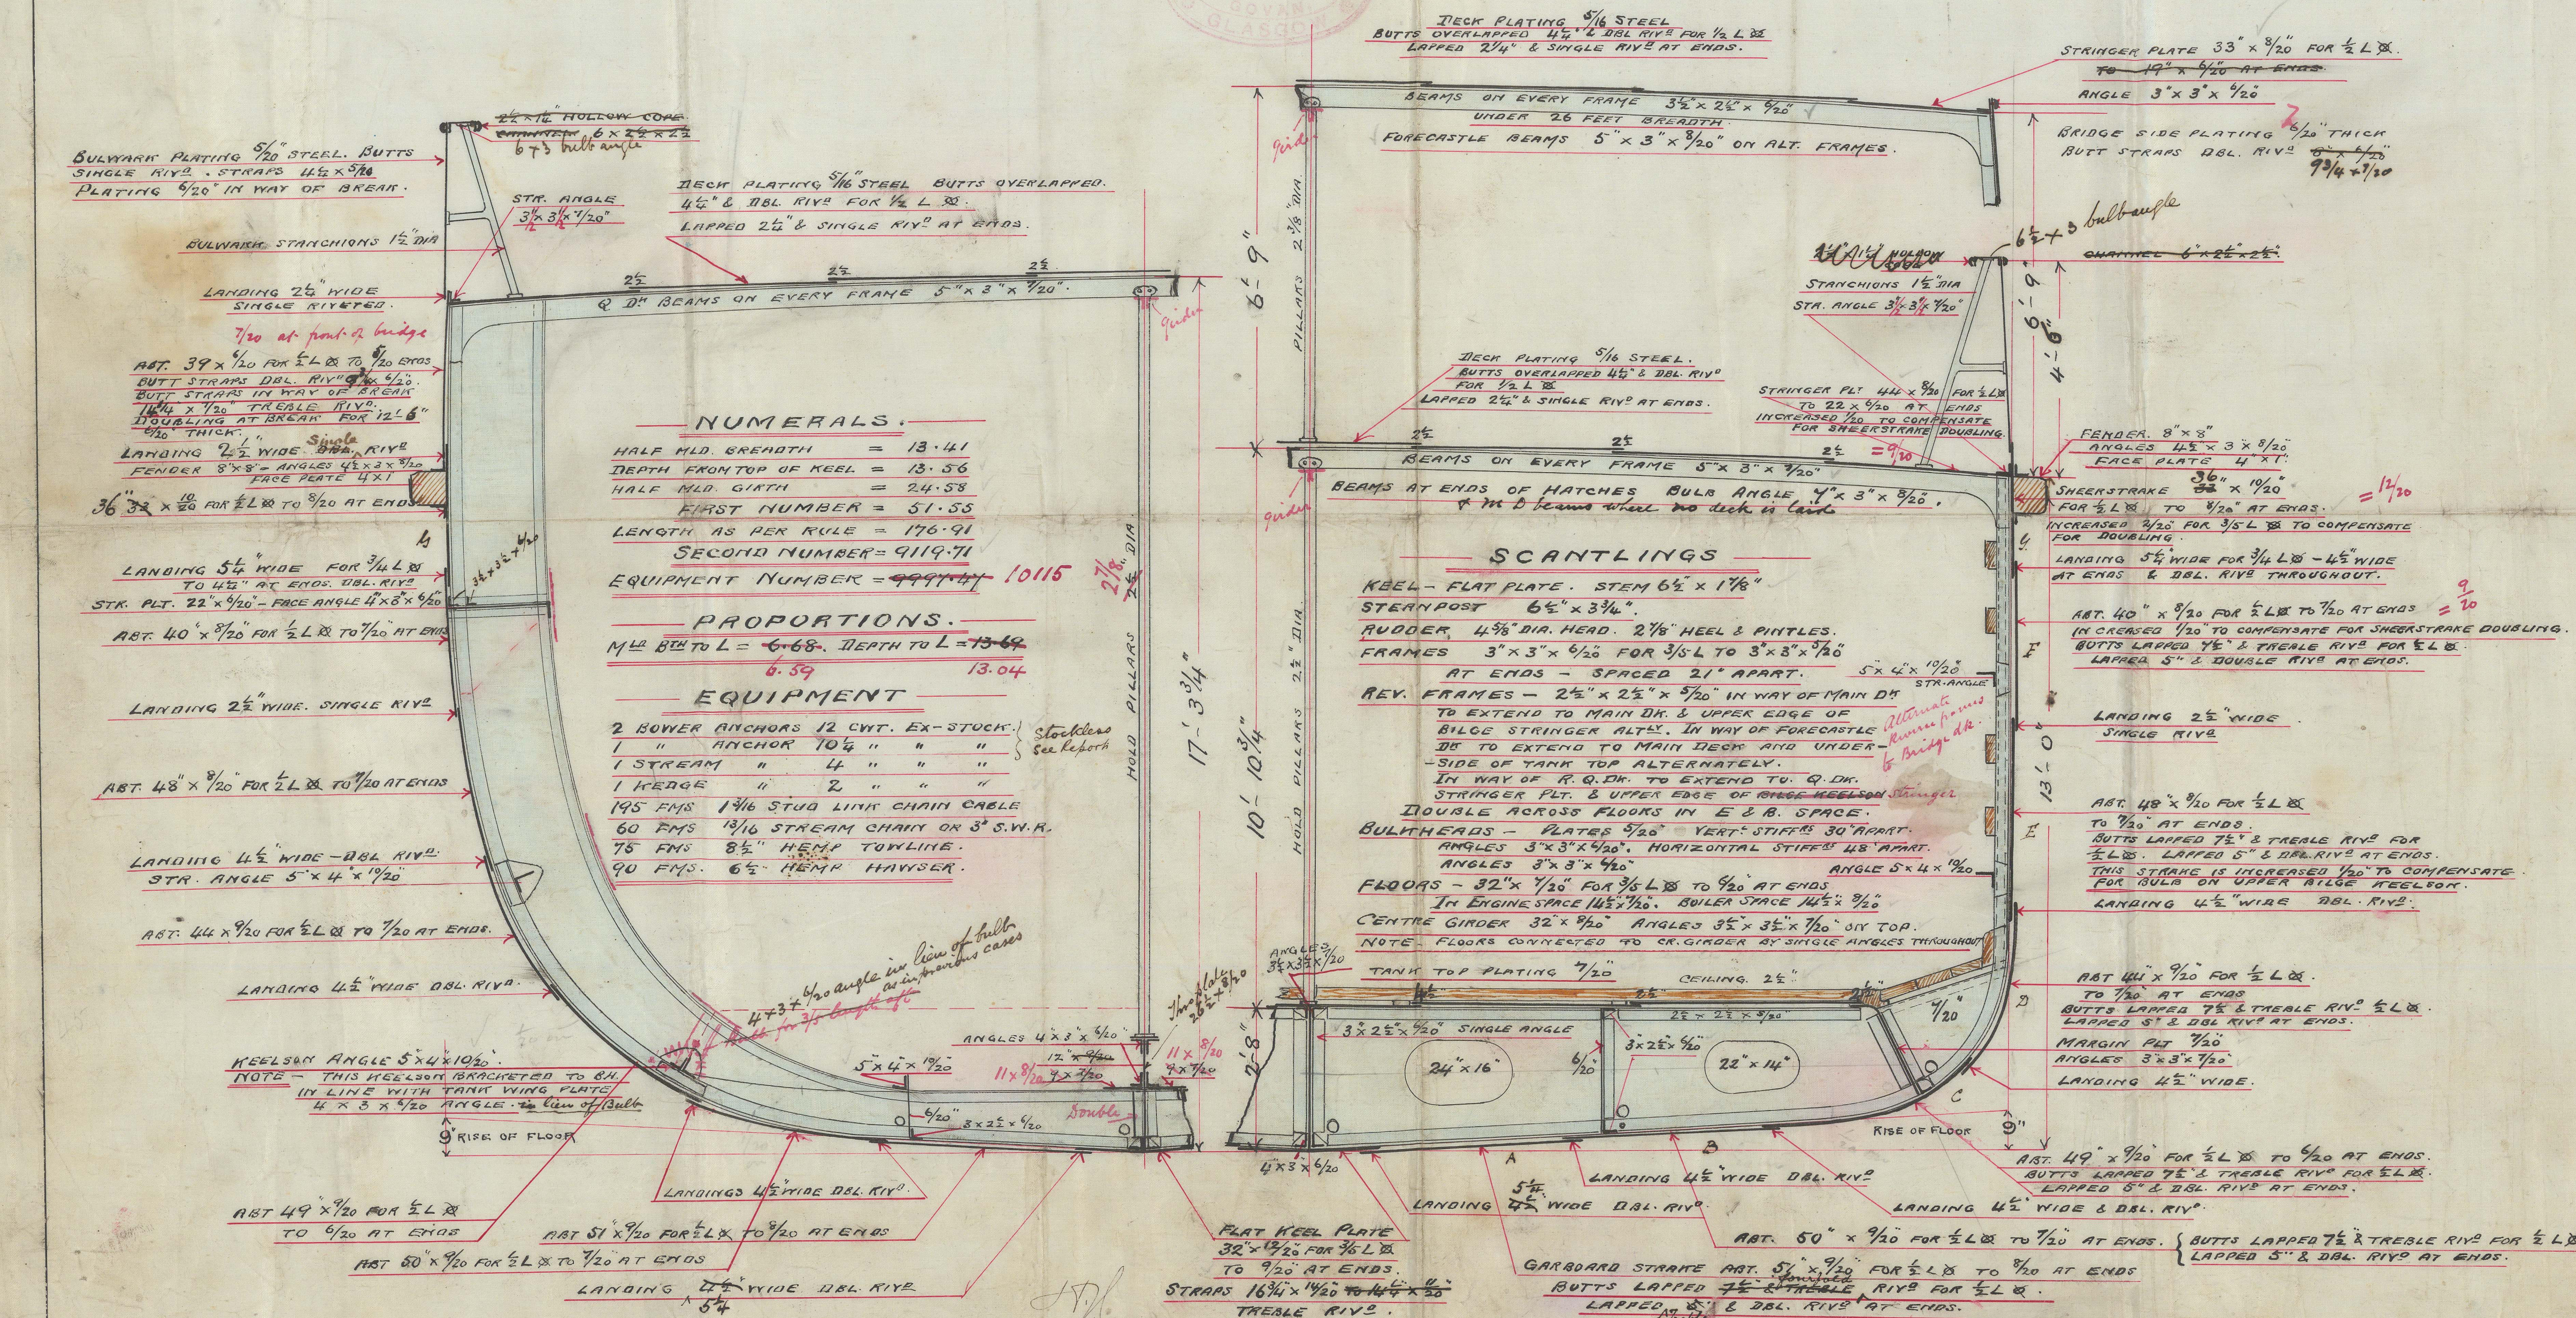


LONG<sup>E</sup> SECTION  
— AND —  
DECK PLANS  
SCALE  $\frac{1}{8}$ " = ONE FOOT

Wal  
86. 20/11/95




20017 8" = ONE FOOT.  
 DECK PLANS  
 LONG SECTION

S.S. "Countess" Glasgow Report No. 14467

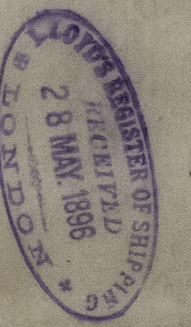

GLS255-0009

GLS255-0009

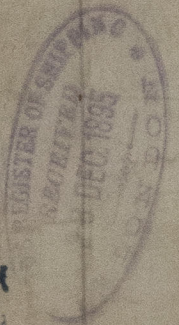

5. N° 107.

MIDSHIP SECTION

STEEL SCREW STEAMER

AT LLOYD

115-1 8 P. 10-0 INCH X 12

SECTION 1/2 INCH

SECTION 1/2 INCH

© 2021

Lloyd's Register Foundation