


27448.
No 4-4-9-50-1

Dimensions of Masts.
Scale. - 1/16" = 1 foot.

21.1.96

R. NAPIER & SONS, Limited.
G. Napier
Director.
14/1/96

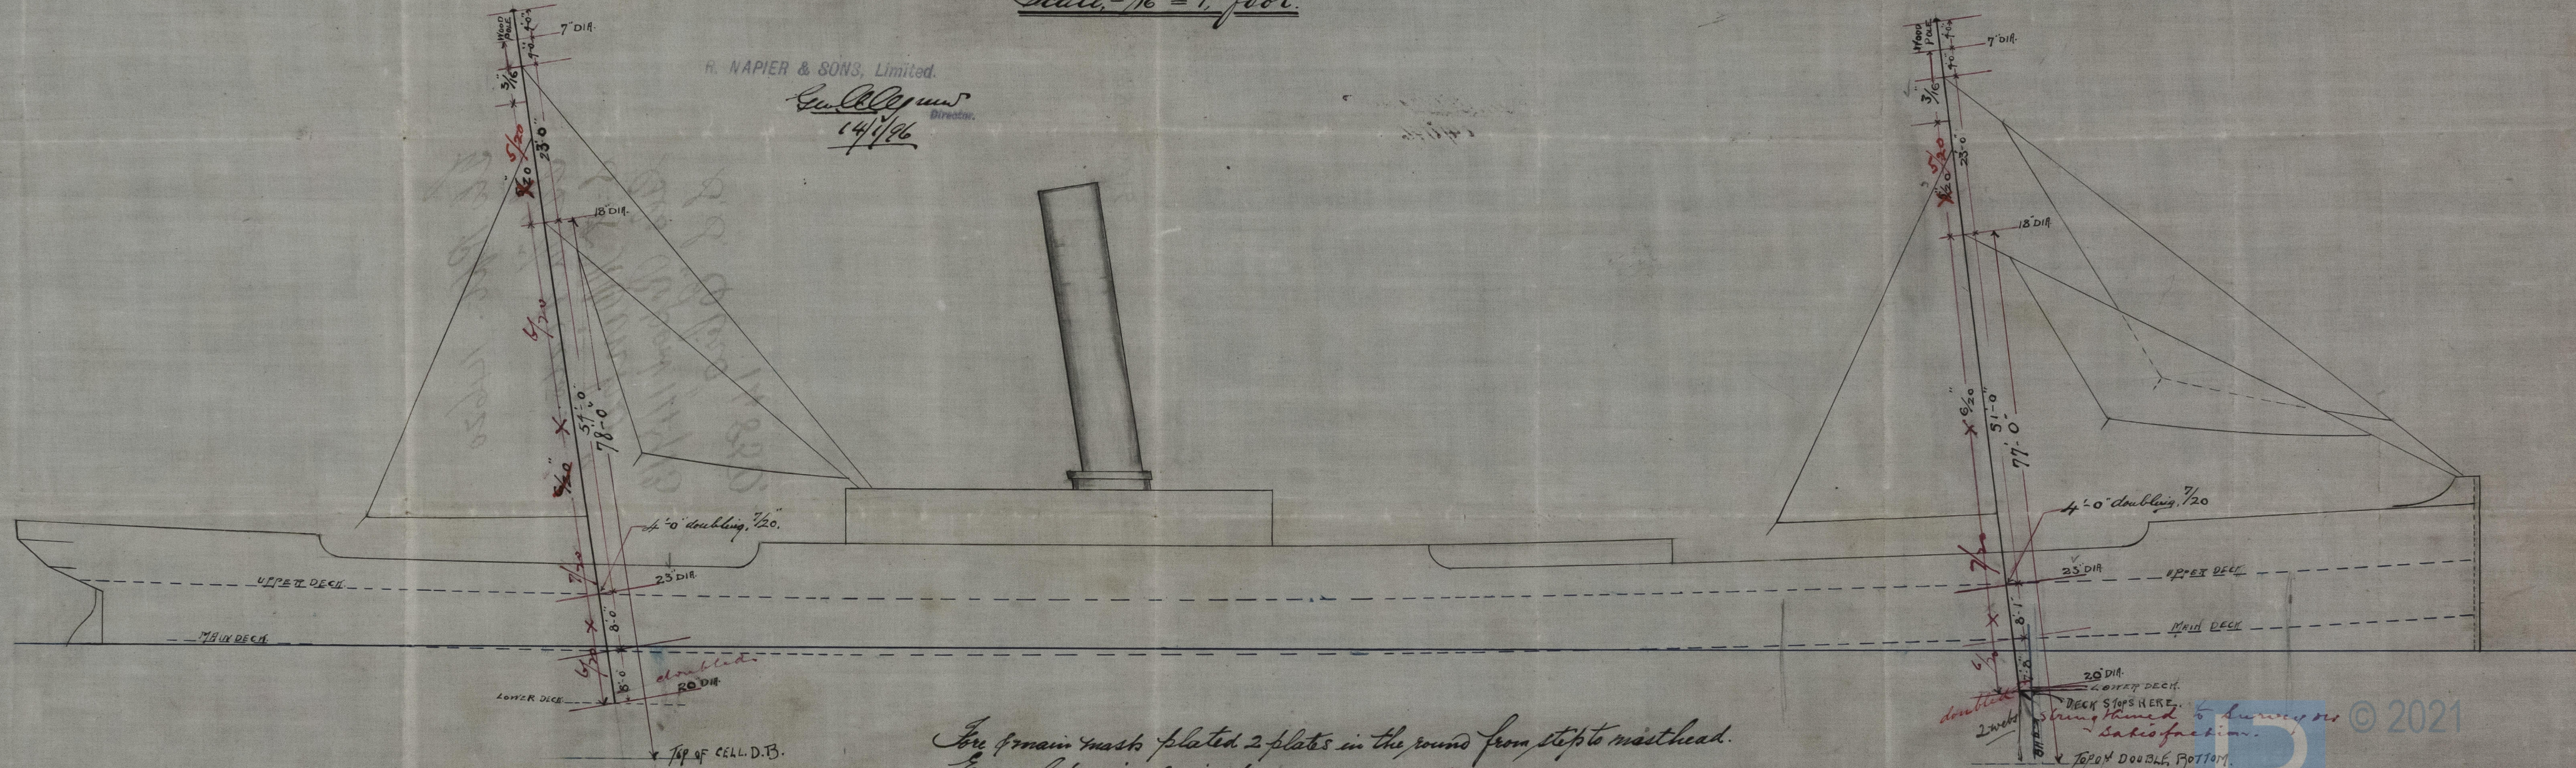

For main mast plated 2 plates in the round from steps to masthead.
Edge laps single riveted. *those below*
Butt laps *double* riveted *except in way of wedging at*
Upper deck double.

S.F.
21/1/96

Gl's Rpt. 14620

St. J. Plata

S. S. "Minho"

Gl's Report 14713

S. S. "Elbro"

14850.


14713

14713



© 2021

Lloyd's Register
Foundation

GLS256 - 0046