

2. Hyphen

27326.

No 4-4-9-50-1

Lloyds.



LLOYD'S REGISTER OF SHIPPING

11.12.95


4/12/95

PLAN OF RUDDER.

SCALE 1 INCH = 1 FOOT.

PINTLES 4 1/2" DIA^R.

38'-0" APPROXIMATE LENGTH
EXACT LENGTH WILL SUBSEQUENTLY BE GIVEN.

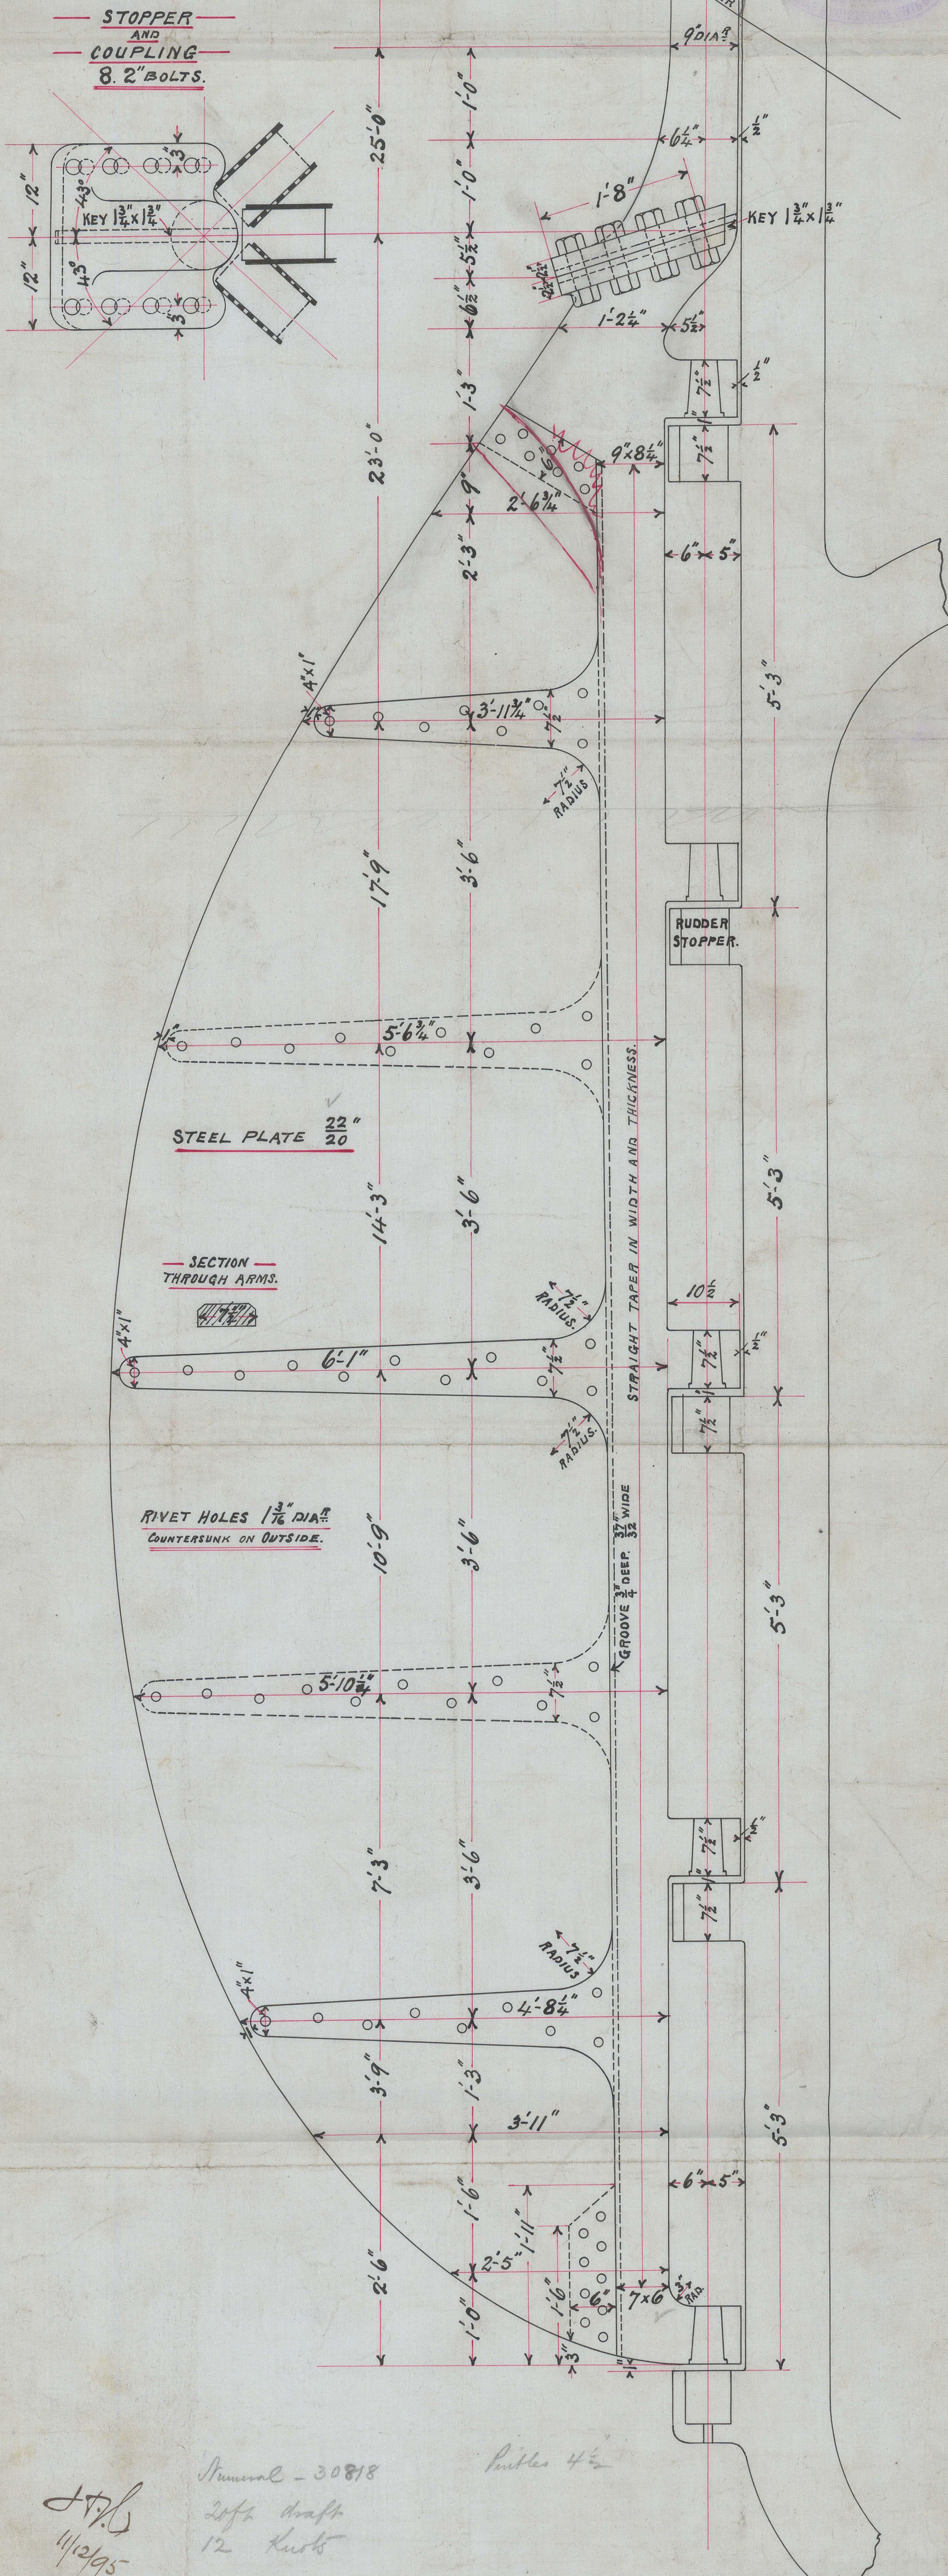

11/12/95

Skinner - 30818

20ft draft


12 knots

Pintles 4 1/2"

PLAN.



Lloyd's Register Foundation

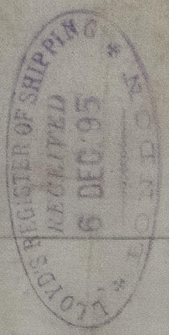

LINE OF CENTER

REPORTS

EXACT LENGTH WILL SUBSEQUENTLY BE GIVEN
38'-0" APPROXIMATE LENGTH

GLSZ 56-0051

LENGTH 43' DIA 6"

SCALE 1 INCH = 1 FOOT

PLAN OF RUDDER

POOP DECK

5' DIA

12/5/95



© 2021
Lloyd's Register
Foundation

Gl's. Report 14620
La Plata
S.S. Meinho
Gl's Report 14713.
S.S. "Ebro"
14830.

1-002-6-1-1-001

25674