


№ 44-9-50-1

approx. M D. Tons = 2730

SECTION AT BULKHEADS SHEWING
METHOD OF DRAINING BOTH WINGS
TO ONE PUMP

~~Not approved~~

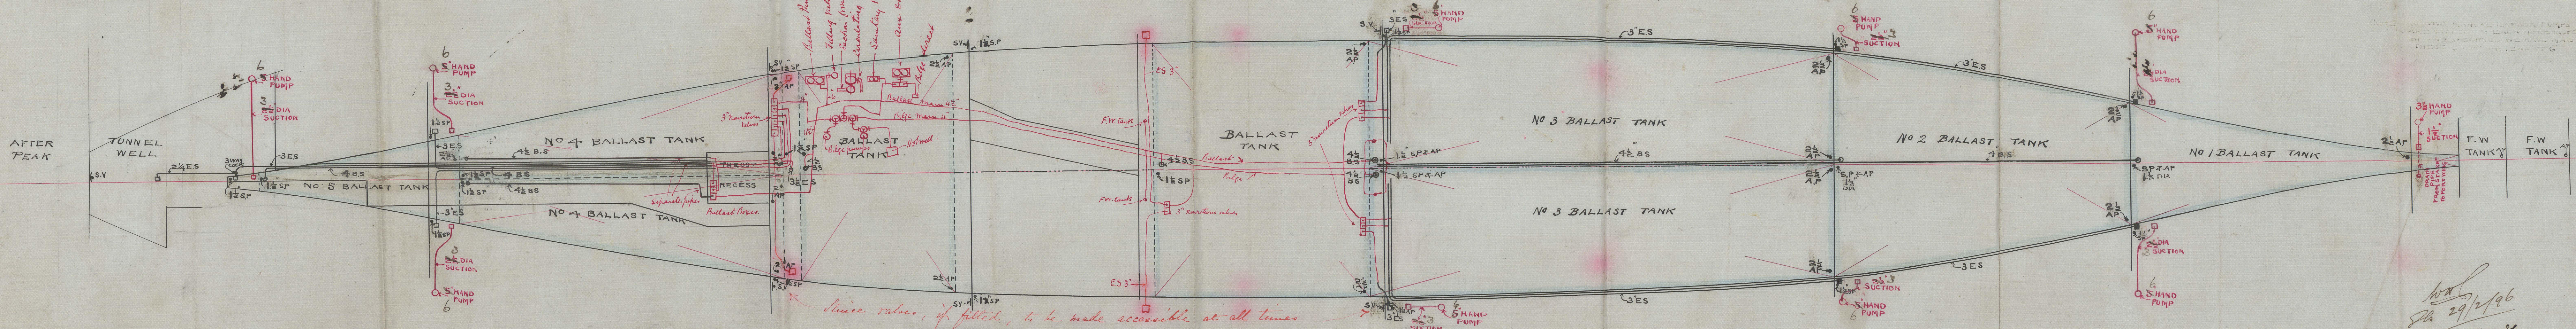

Since values, if fitted, to be made accessible at all times

WAL
\$26 29/2/96
C.W.S. 3. 96

Gls. Rpt. 14620

La Plata :



"Meinher"

Summing arrangement

Glasgow Report 14413

S. S. Cleve"

14850.

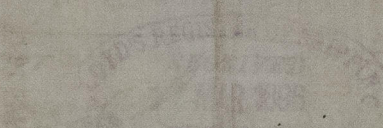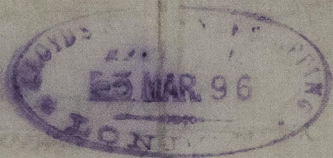

©2021

GL5256-0053

Lloyd's Register
Foundation