


№ 27168


Am. B. C. C. C.
21/10/25.

— N^o 449-50-51. —

Scale $\frac{1}{8}$ inch = 1 Foot.

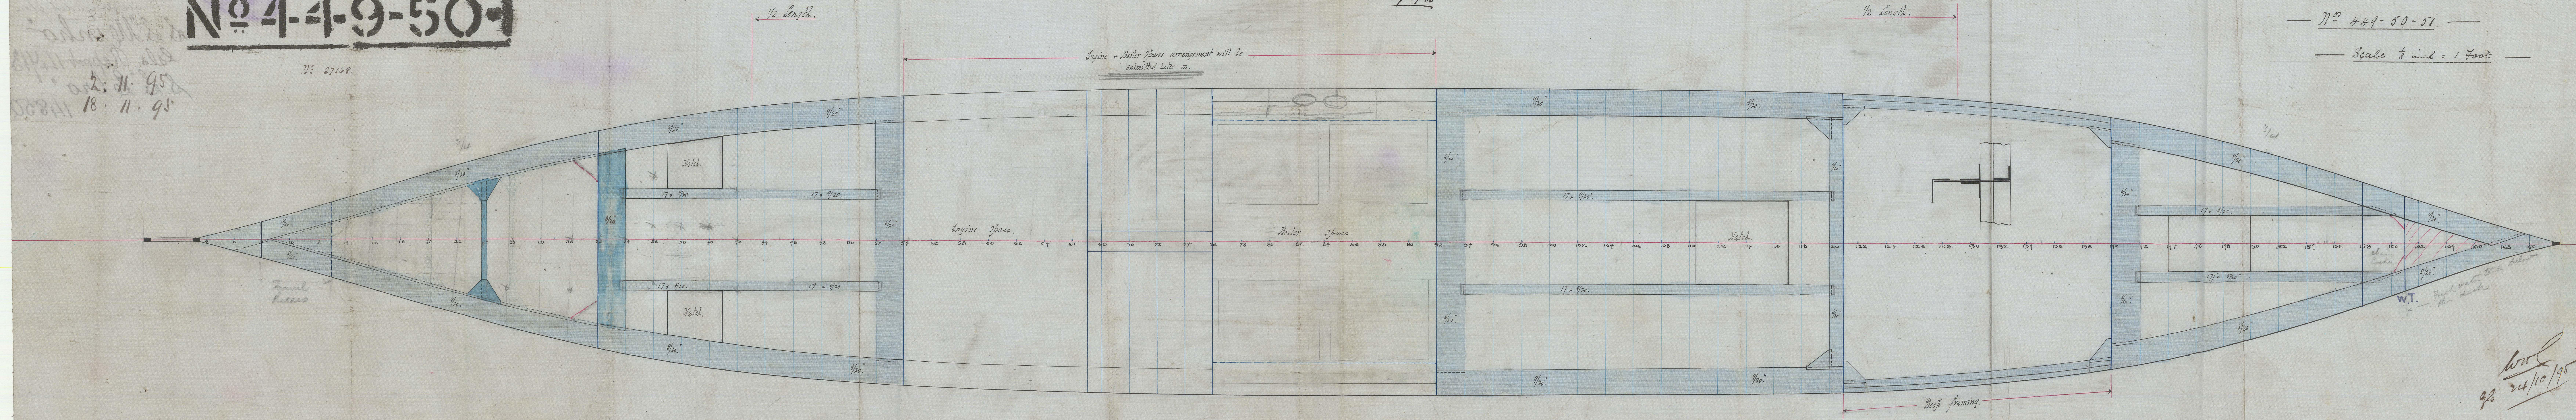

Wm L
24/10/95

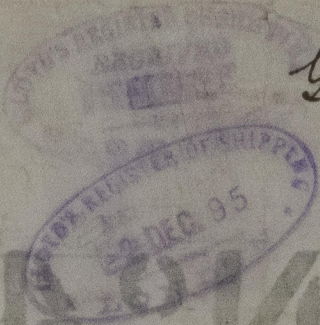

Yes. Rpt. 14620
"La Plata"


See amended plan

S. S. "Minho"

Yes. Report 14413

S. S. "Elbro"

14850.

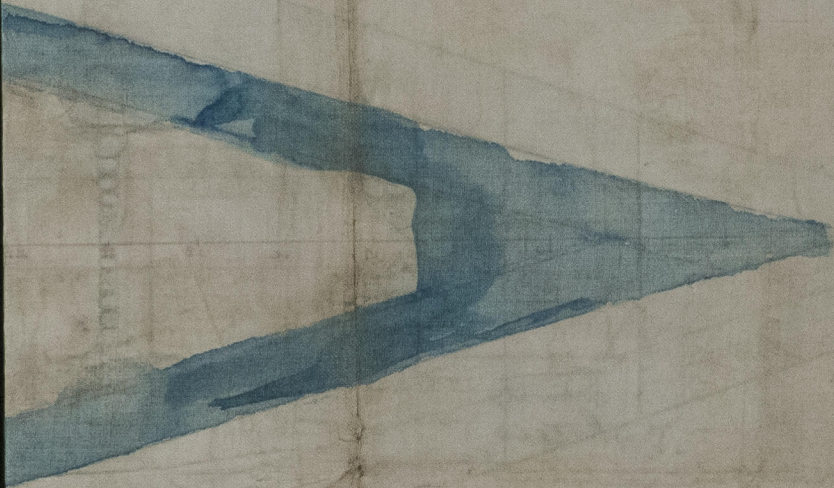

© 2021

GLS256-0034
Lloyd's Register
Foundation