


27855.
No 4-4-9-50-1

Amended
LOWER DECK
 SCALE - $\frac{1}{8}'' = 1 \text{ FOOT.}$

— as Built —


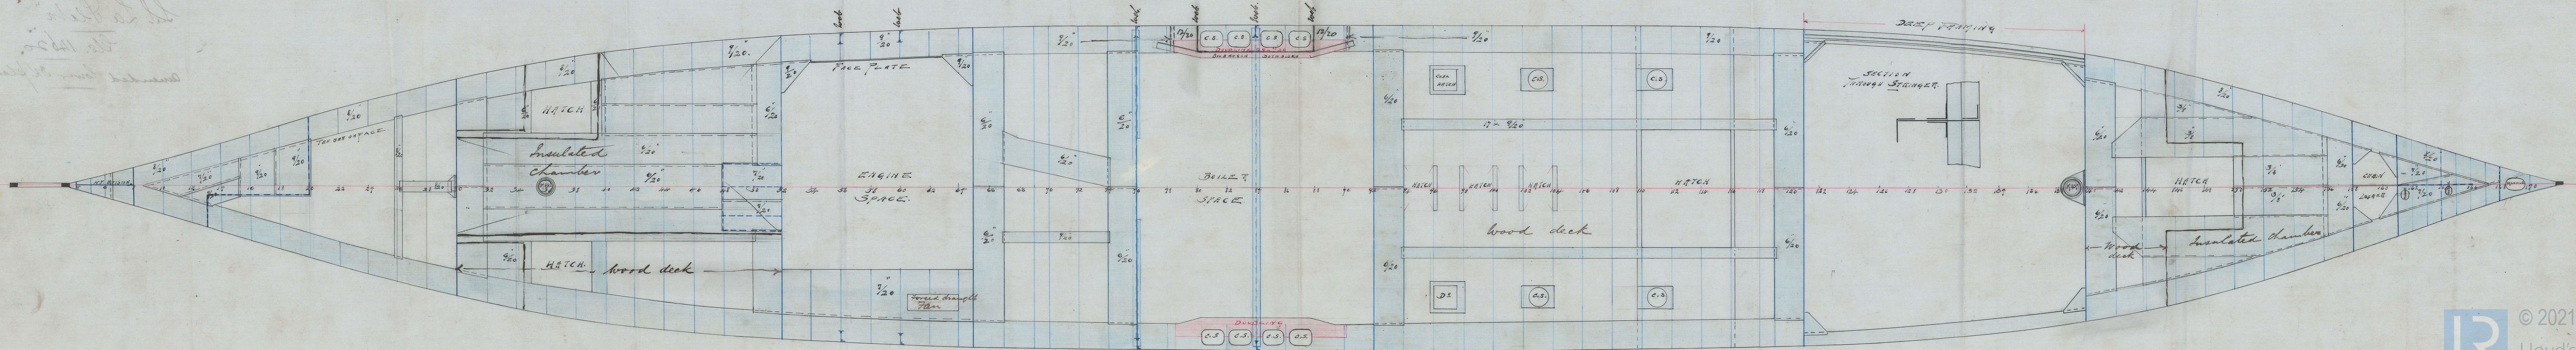


1-02-9-1-101

San La Plata

Elev. 14620.

amended lower OK plan

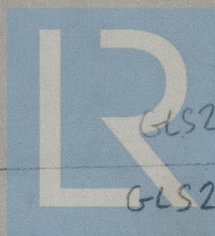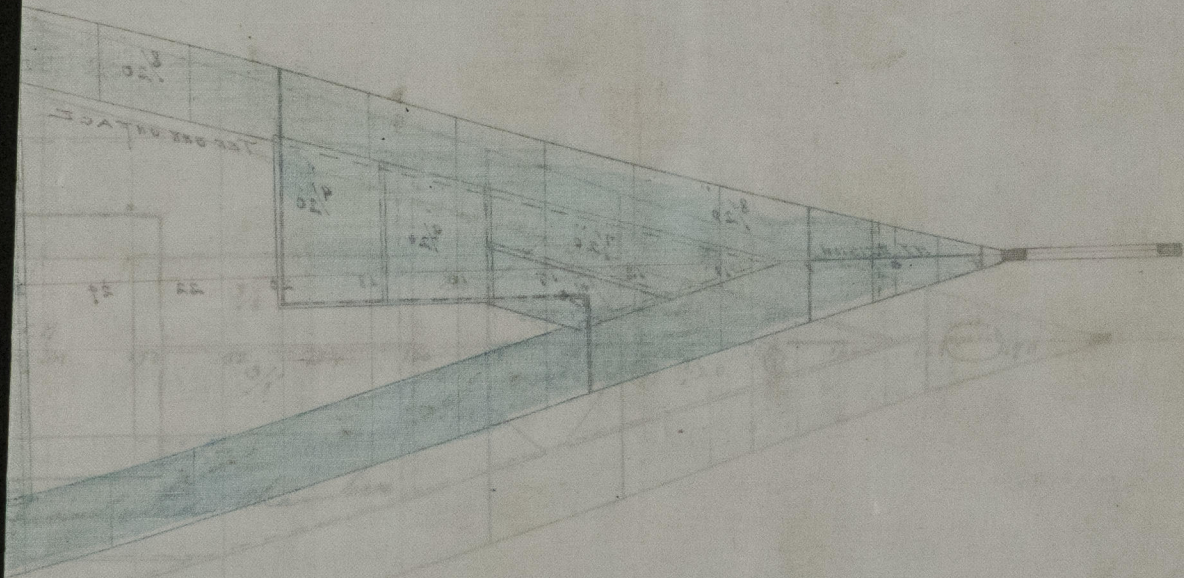

© 2021

GLS256-0055

GLS256-0055

Lloyd's Register
Foundation