

Nº 449-50-I


MIDSHIP SECTION
OF A
STEEL SINGLE SCREW STEAMER
TO CLASS 100 A THREE DECK AT LLOYDS
SPECIAL SURVEY
BUILDERS DIMENSIONS 345 x 43-9/4 x 1

SCALE $\frac{1}{2}$ IN = ONE FT

27'-2 $\frac{3}{4}$ " amidships

Dr. Clemons
24/10/95

SECTION
SHEWING DEEP FRAMING
IN LIEU OF HOLD BEAMS
IN No 2 HOLD

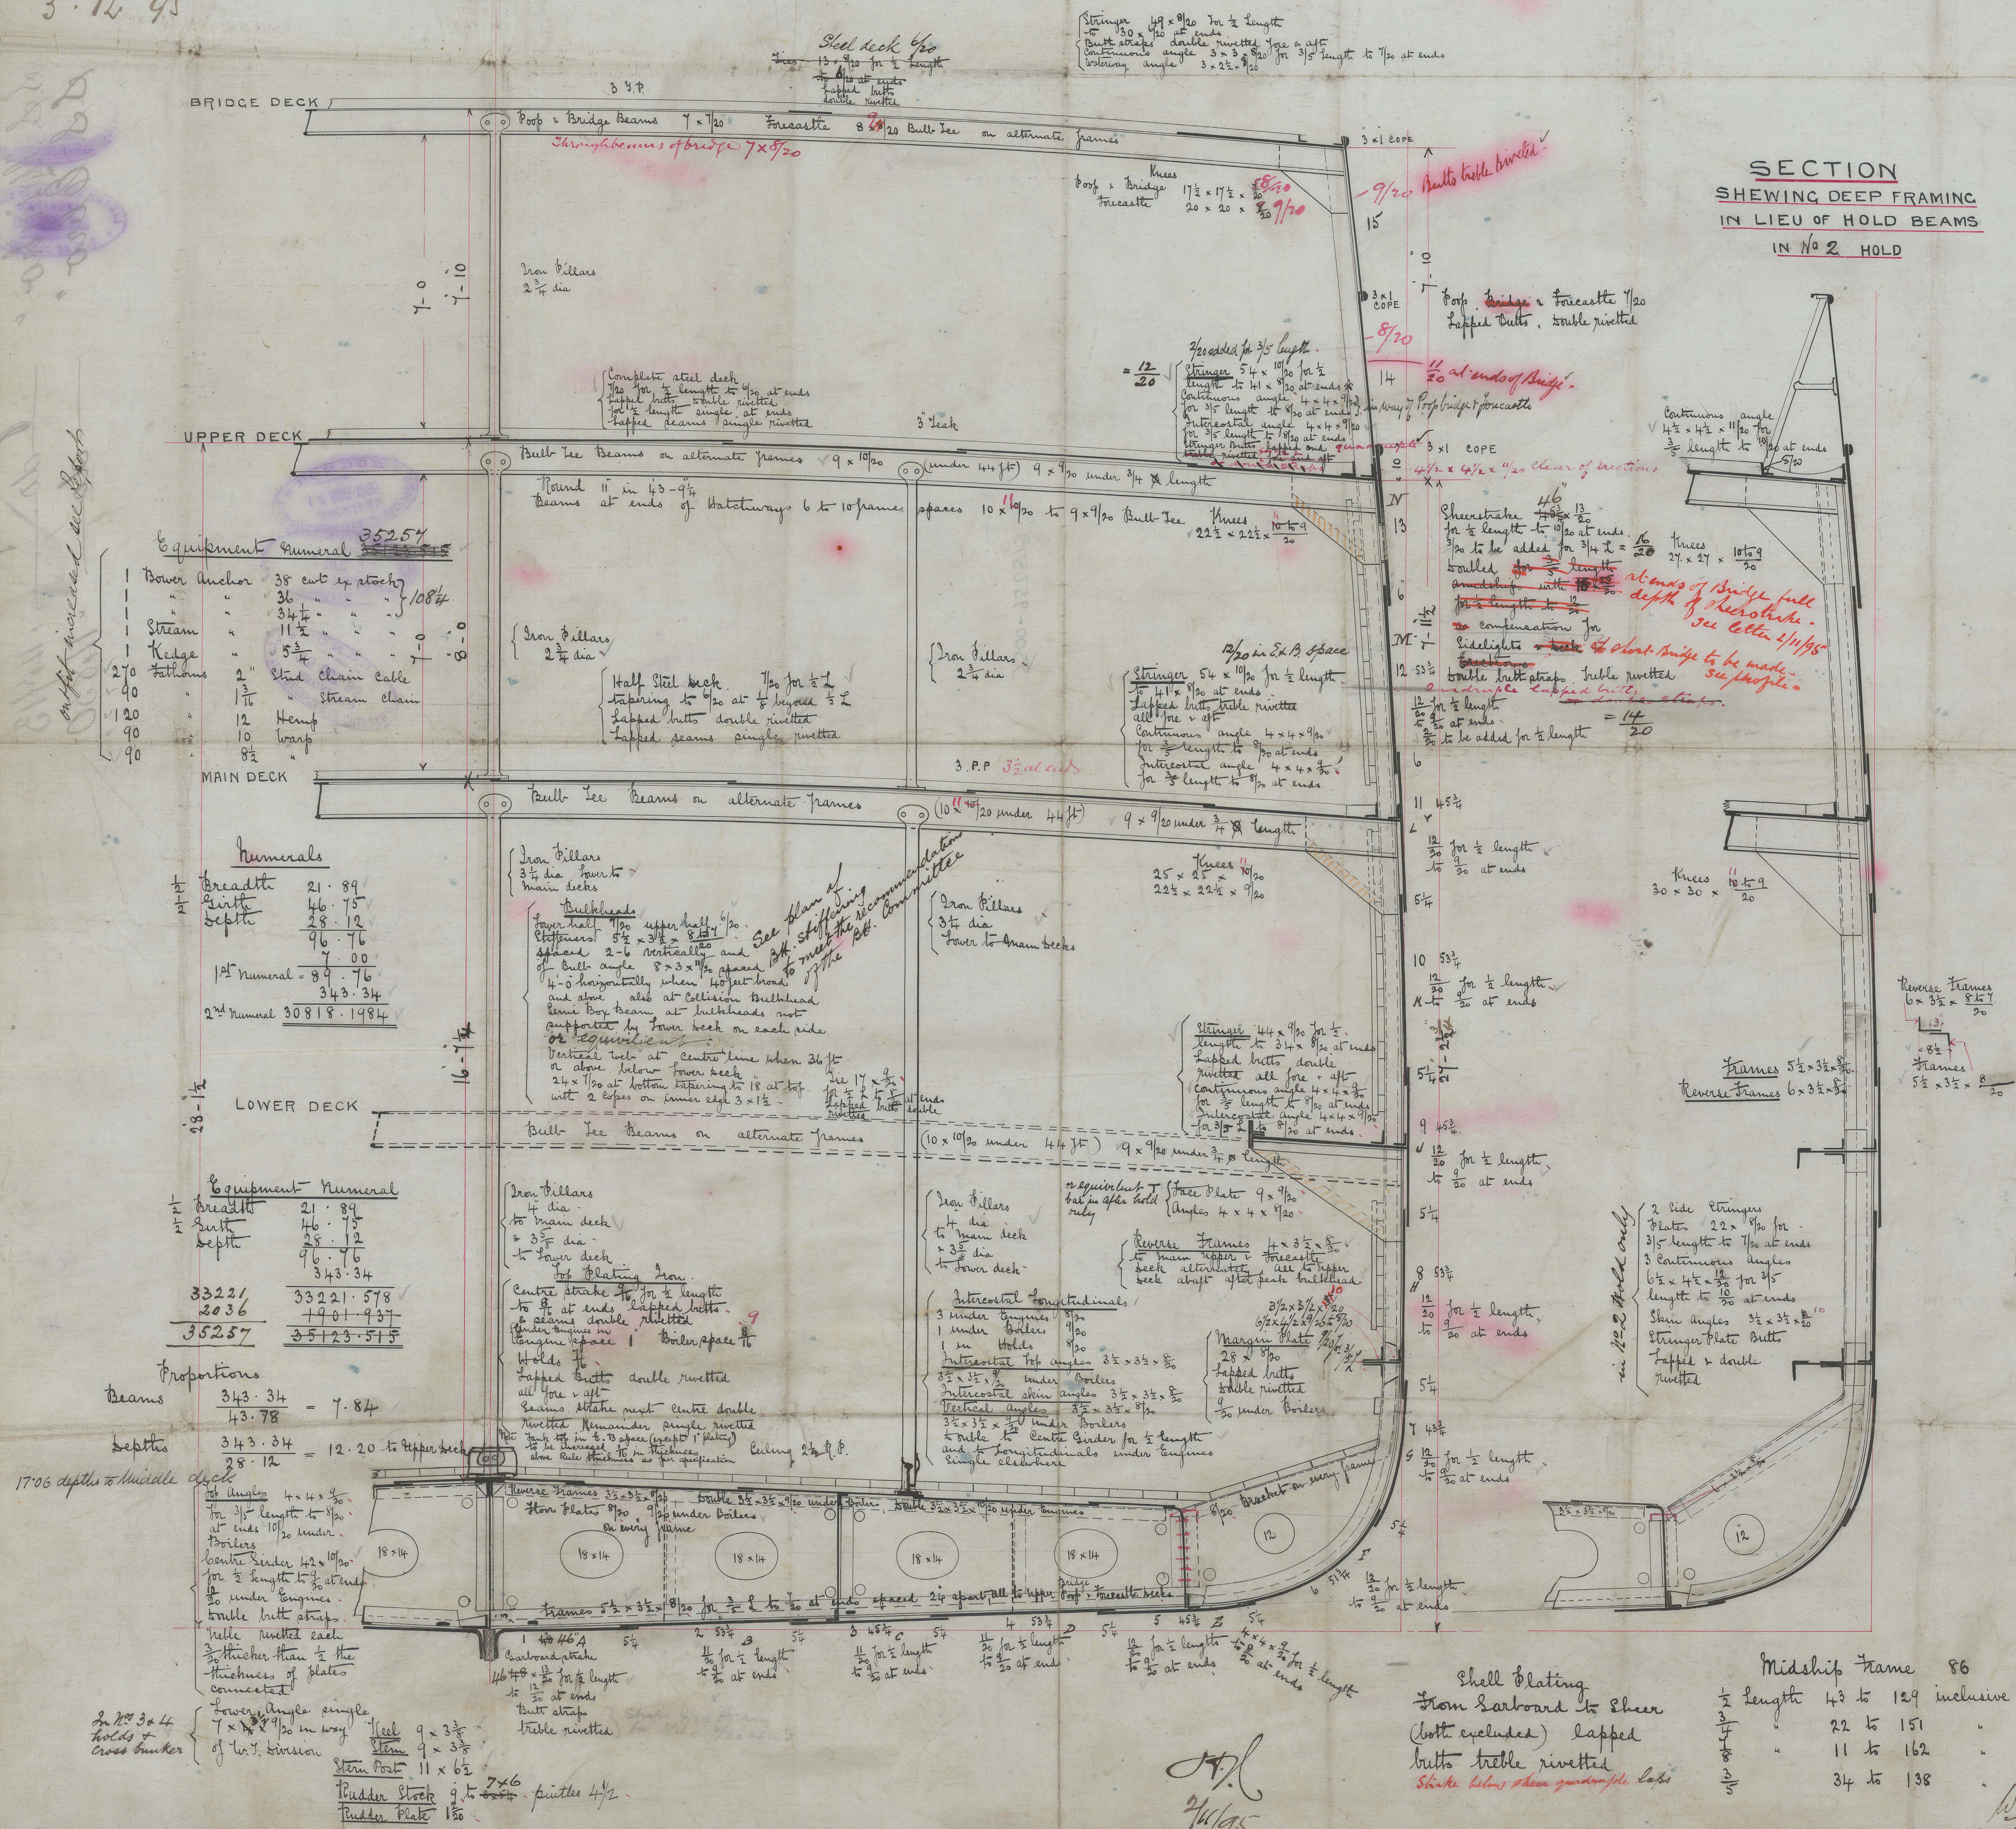

GLS256-0056