

## Lloyd's Register of British and Foreign Shipping.

(Report on Vessel No. *14620*, Port *Glasgow*)*Glasgow*No. *3166.a*

## SHIP FORGINGS OR CASTINGS.

I have to report that the undermentioned Iron or Steel Forgings or Castings,  
 manufactured by *The Darlington Forge Co*  
 of *Darlington* for the Vessel No. *449*, being built  
 by *Messrs R Napier & Sons* of *Glasgow*  
 have been inspected by me as set forth below, and found to be, so far as can be seen,  
*sound*

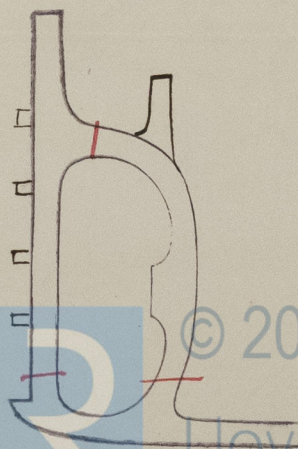
Mark on Forgings.

Lloyd's

No. *3166.a**R.C.**Wugh Cameron**Sunderland**9-6-96*

	STERN FRAME.	RUDDER FRAME.	STEM.
Material* ...	<i>Scrap iron</i>	<i>Scrap iron</i>	/
How made ...	<i>Forged</i>	<i>Forged</i>	
Dimensions ...	<i>11" x 6 1/2"</i>	<i>as per plan attached</i>	
Progress on Inspection	<i>Forged &amp; smithed</i>	<i>Forged &amp; smithed</i>	
Date when Inspected	<i>Nov 5<sup>th</sup> / 96 to Jan 9 / 96</i>	<i>March 4<sup>th</sup> to May 22 / 96</i>	

SKETCHES OF FRAMES SHOWING POSITION AND DESCRIPTION OF WELDS OF FORGINGS, OR PARTICULARS OF TESTS APPLIED TO CASTINGS.

*Welds*

Fee (if any chargeable) £

:

To be paid at

\* If of Iron, state whether scrap or puddled Iron.



Sternframe +  
Rudder frame

No. 449



© 2021

Lloyd's Register  
Foundation