
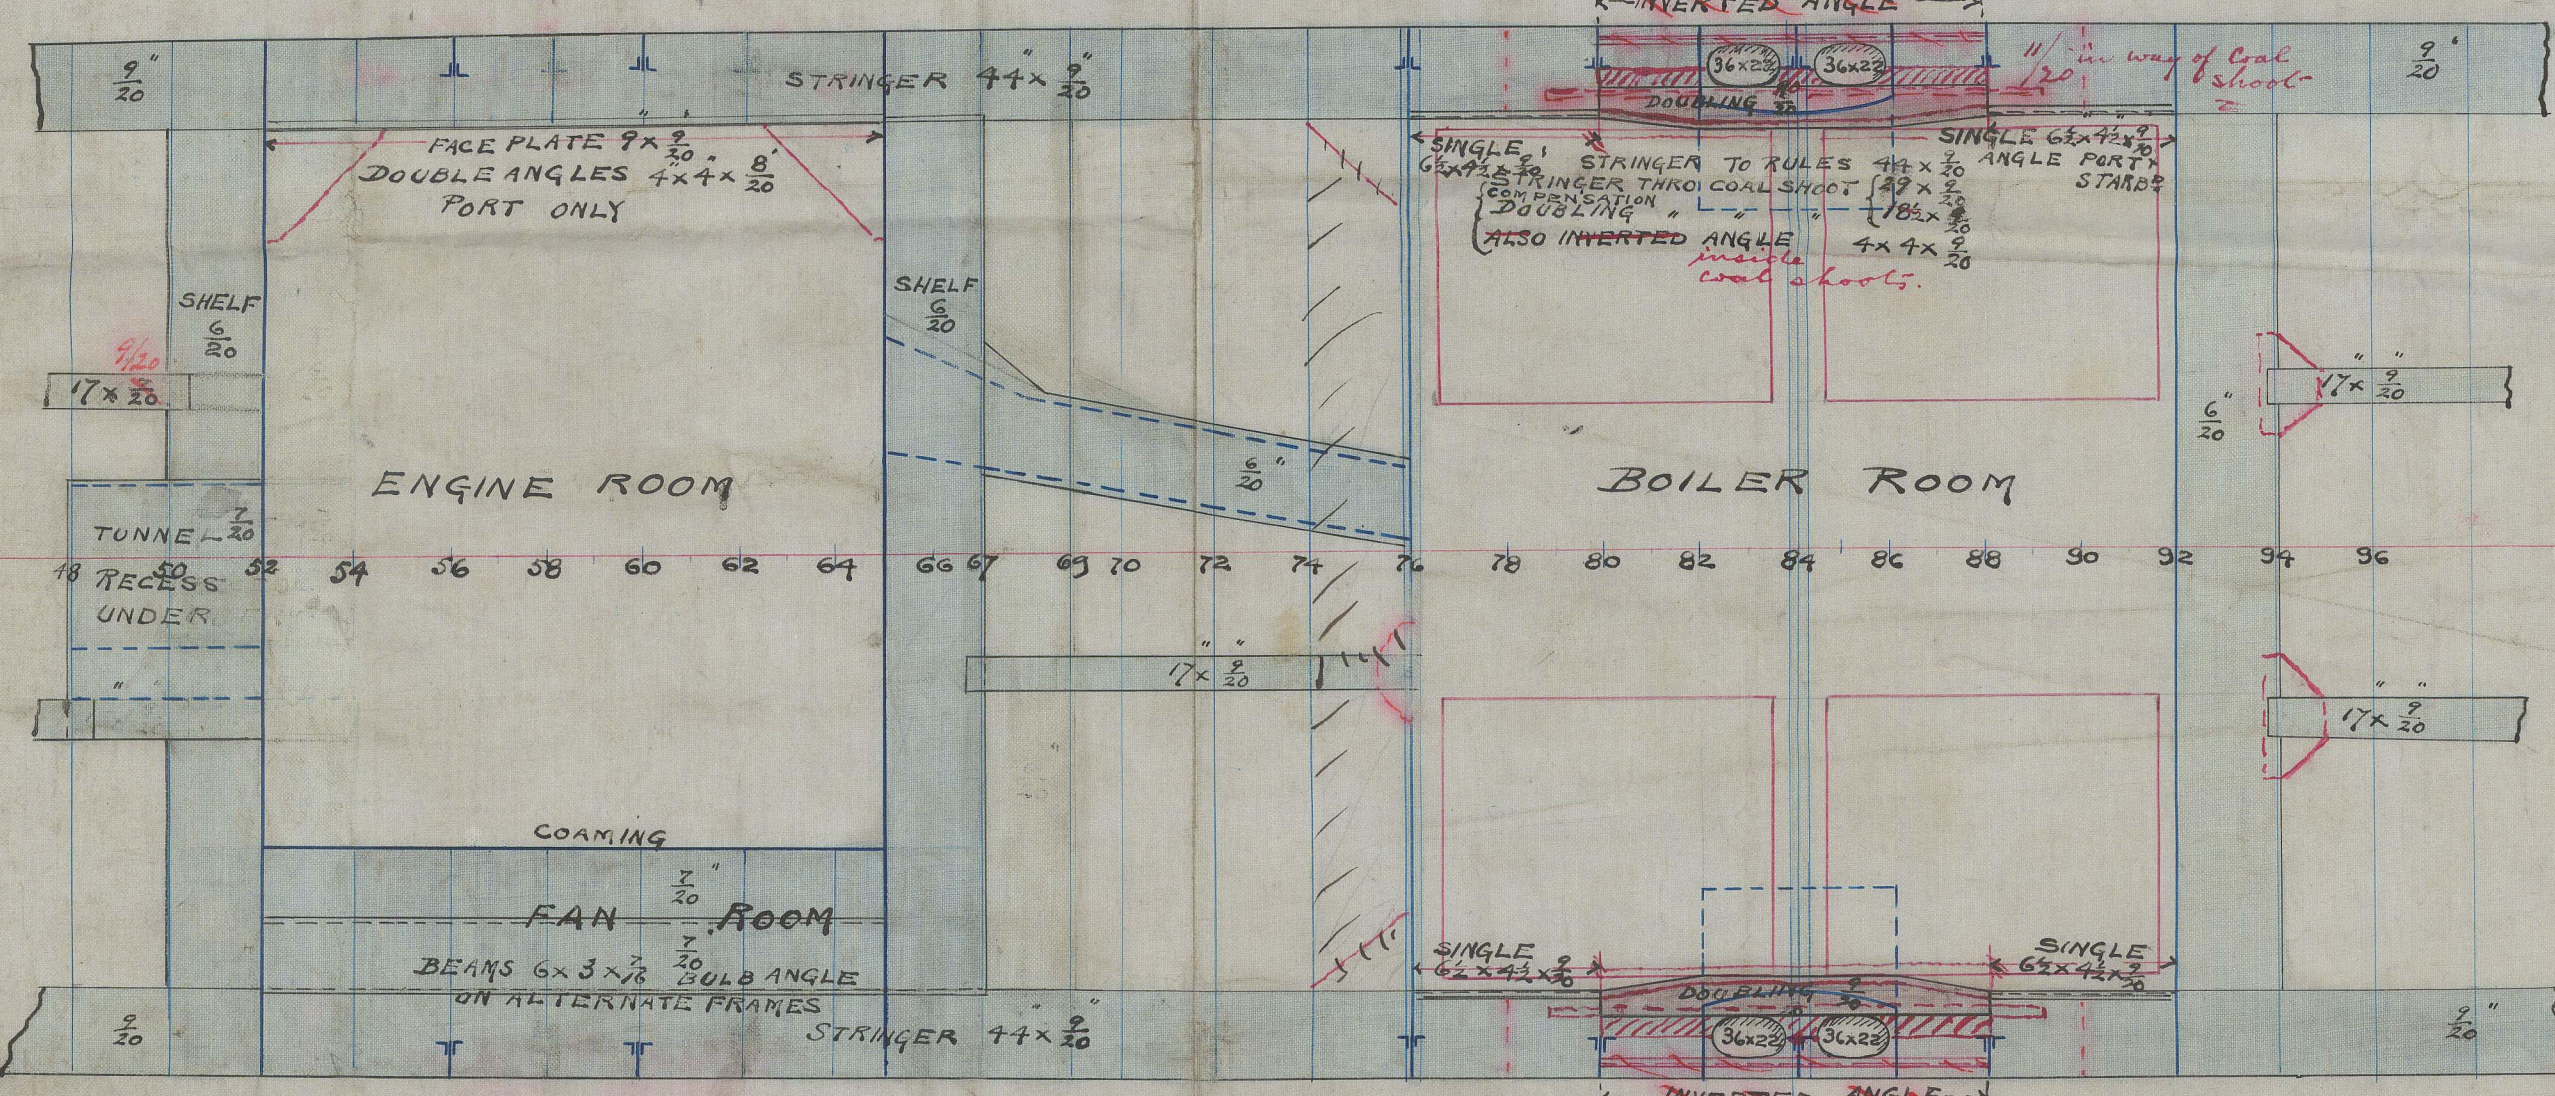
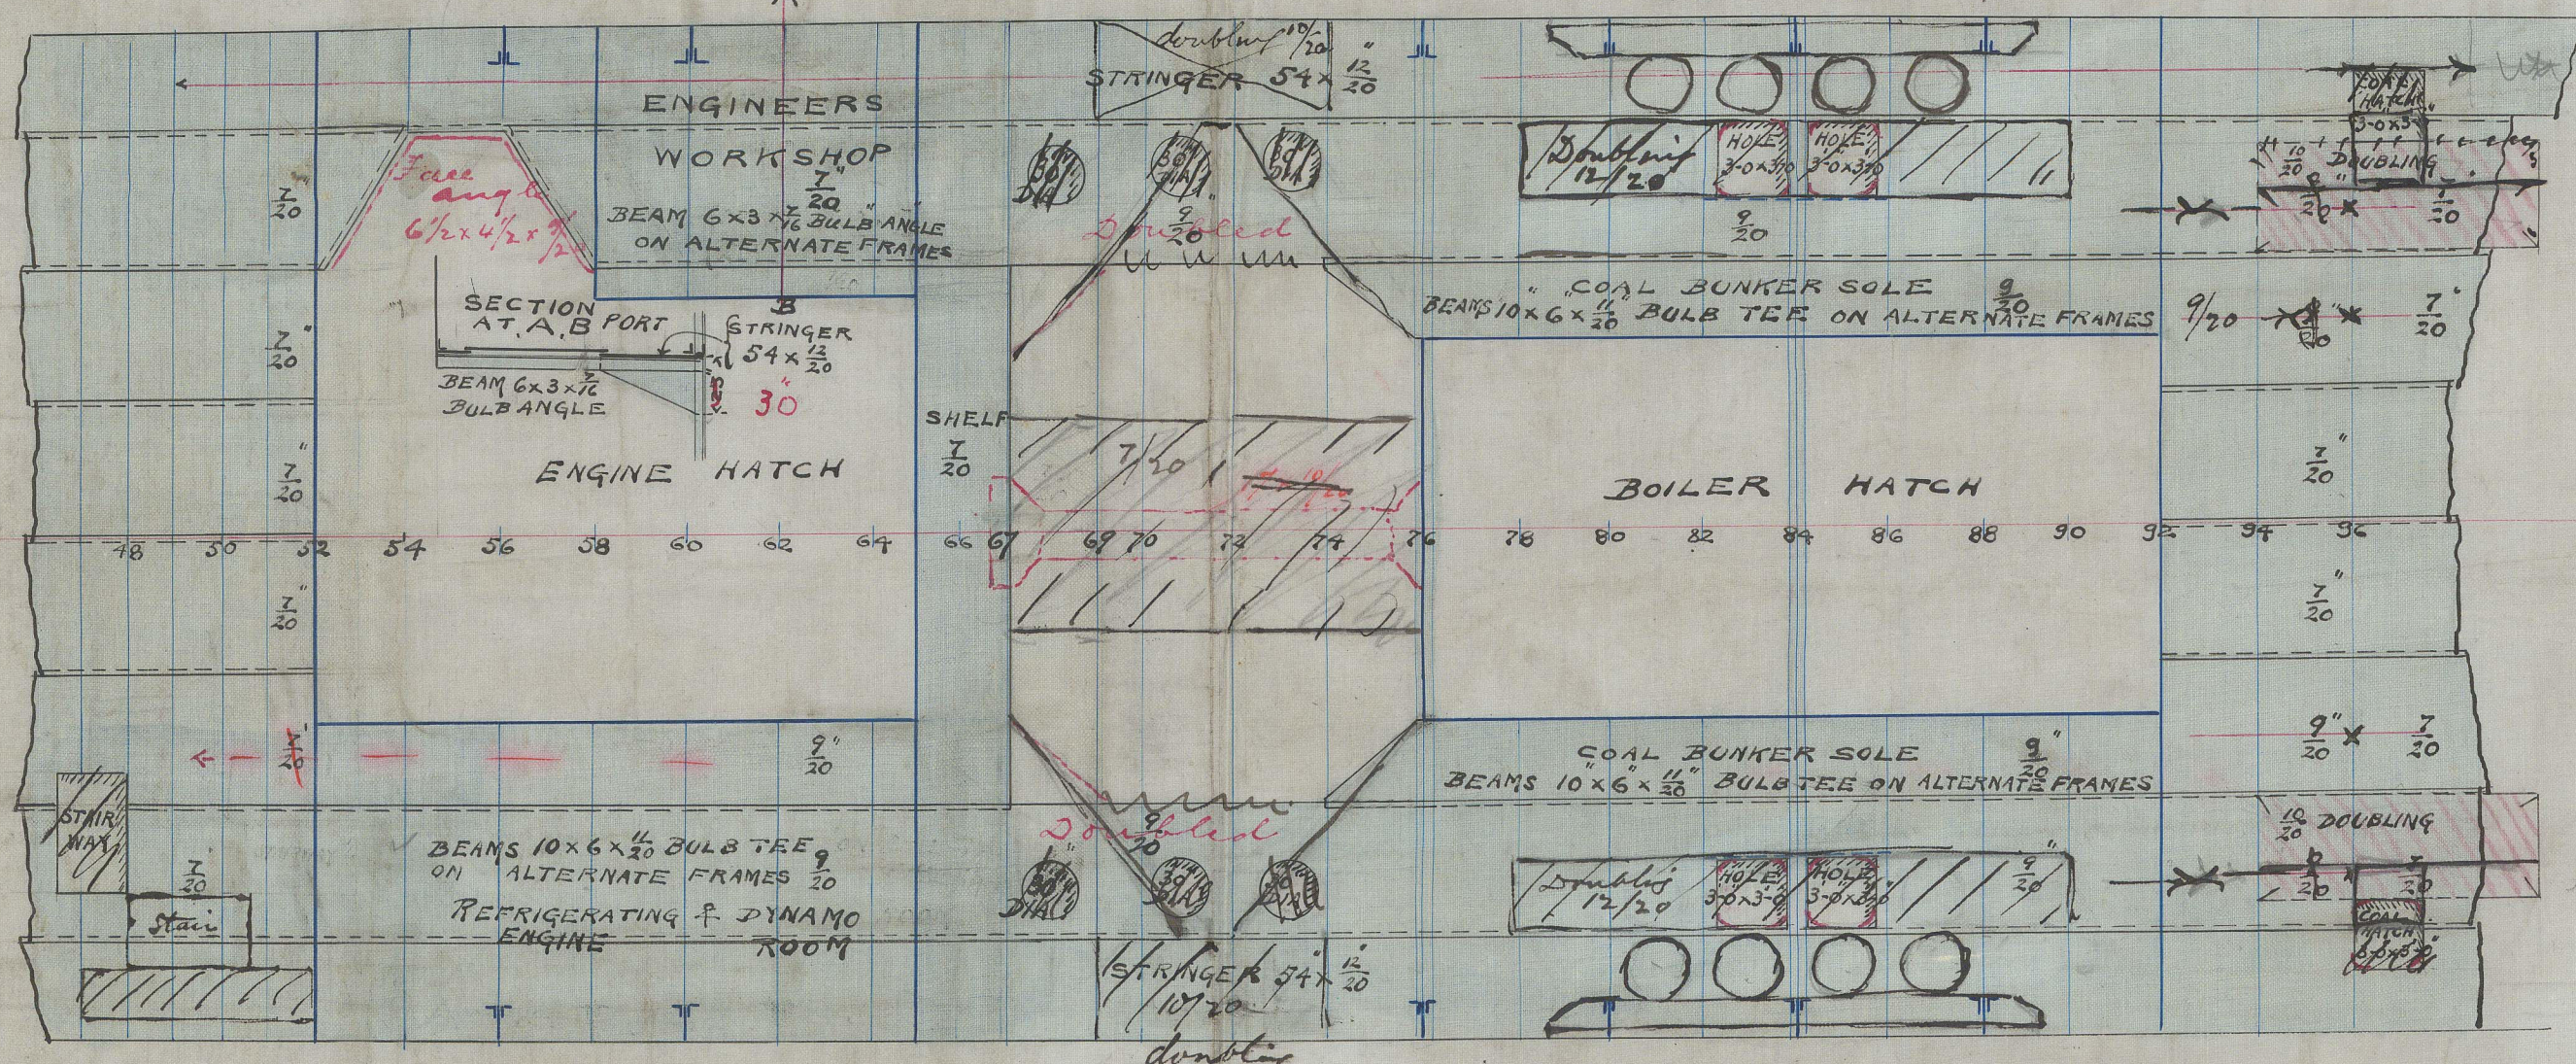
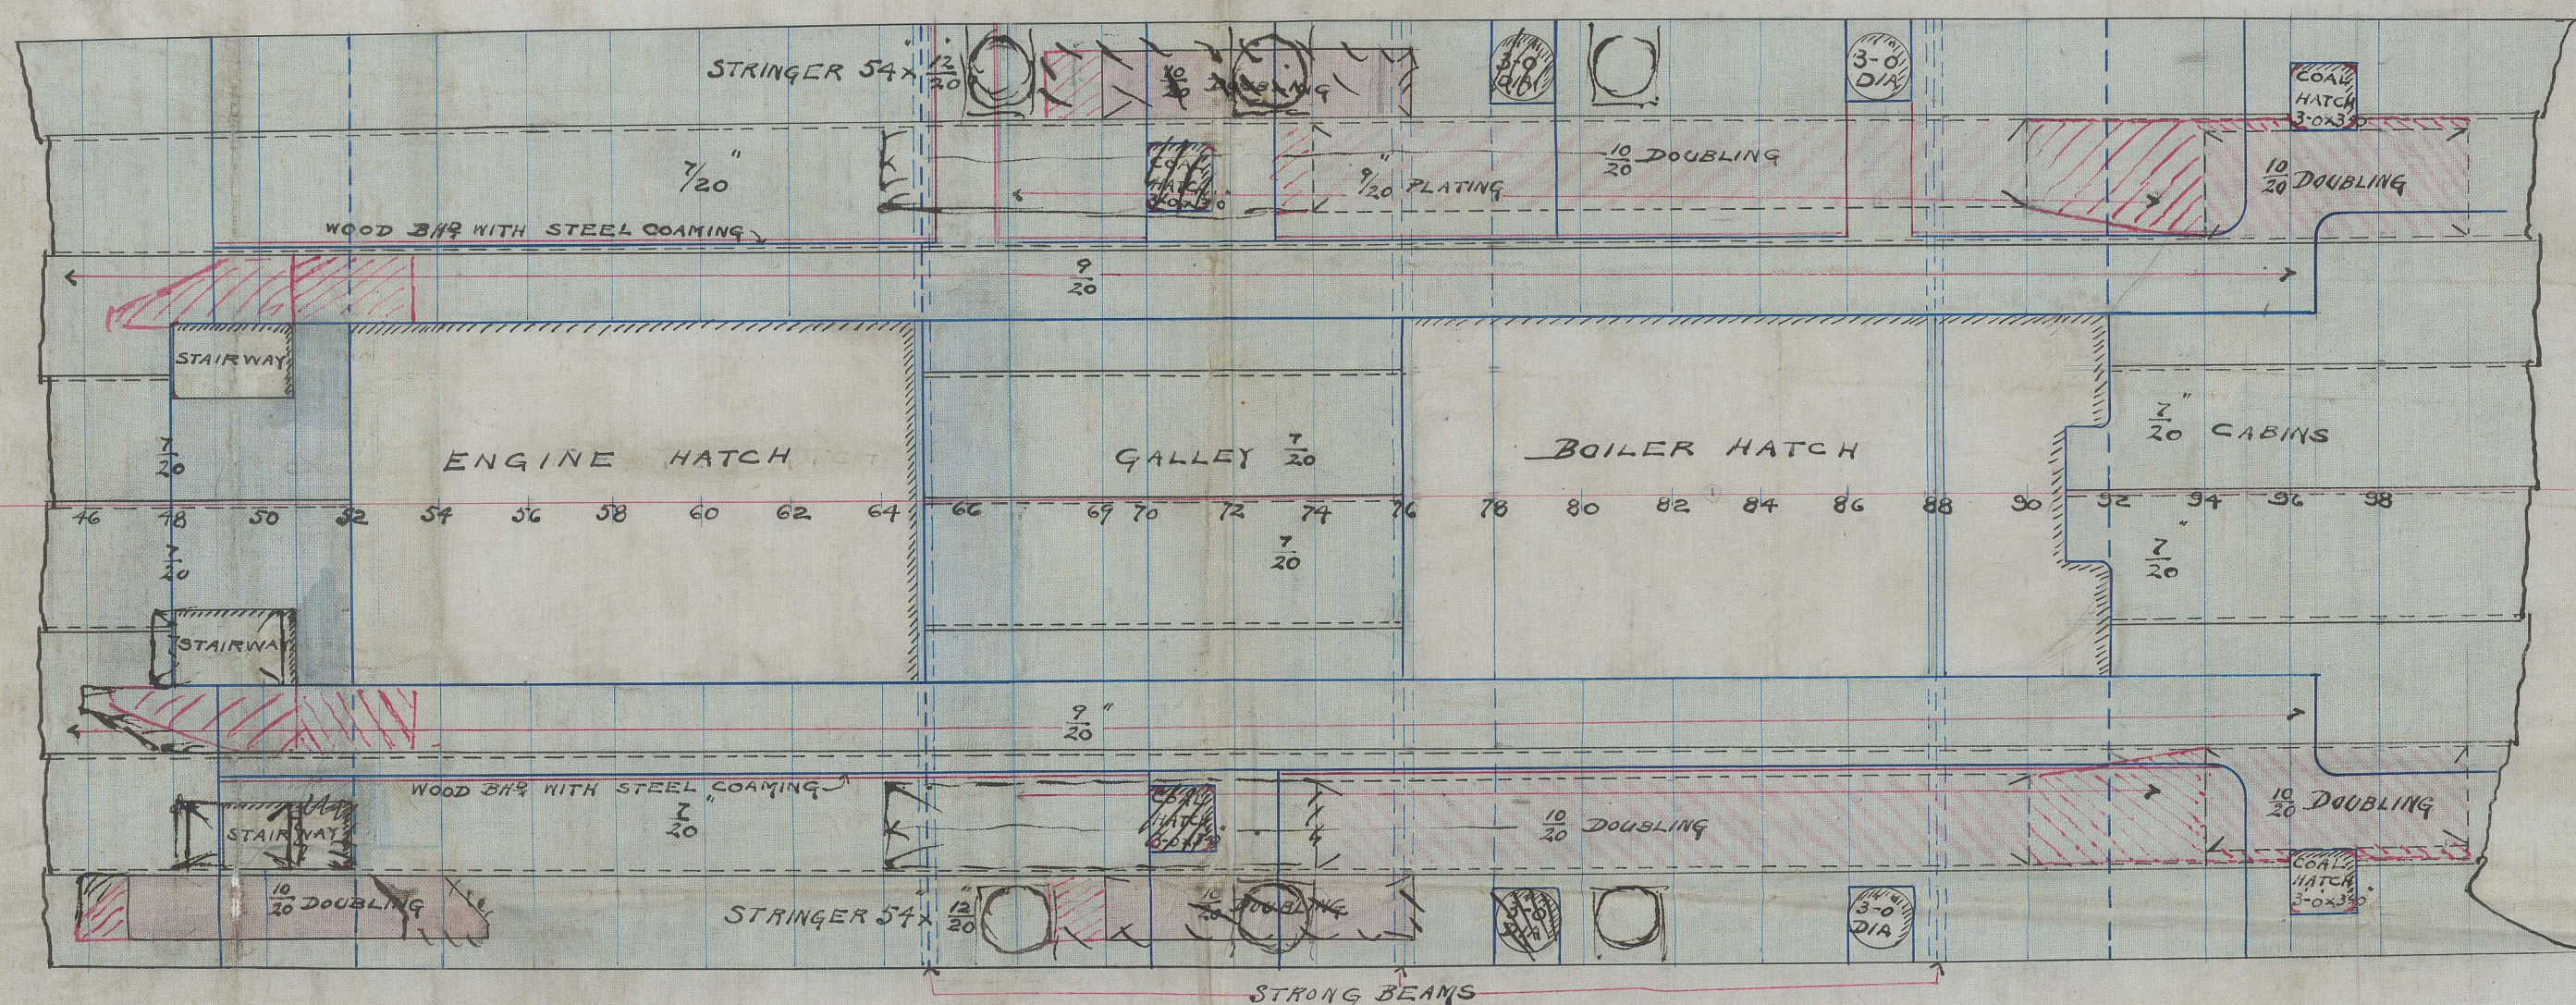
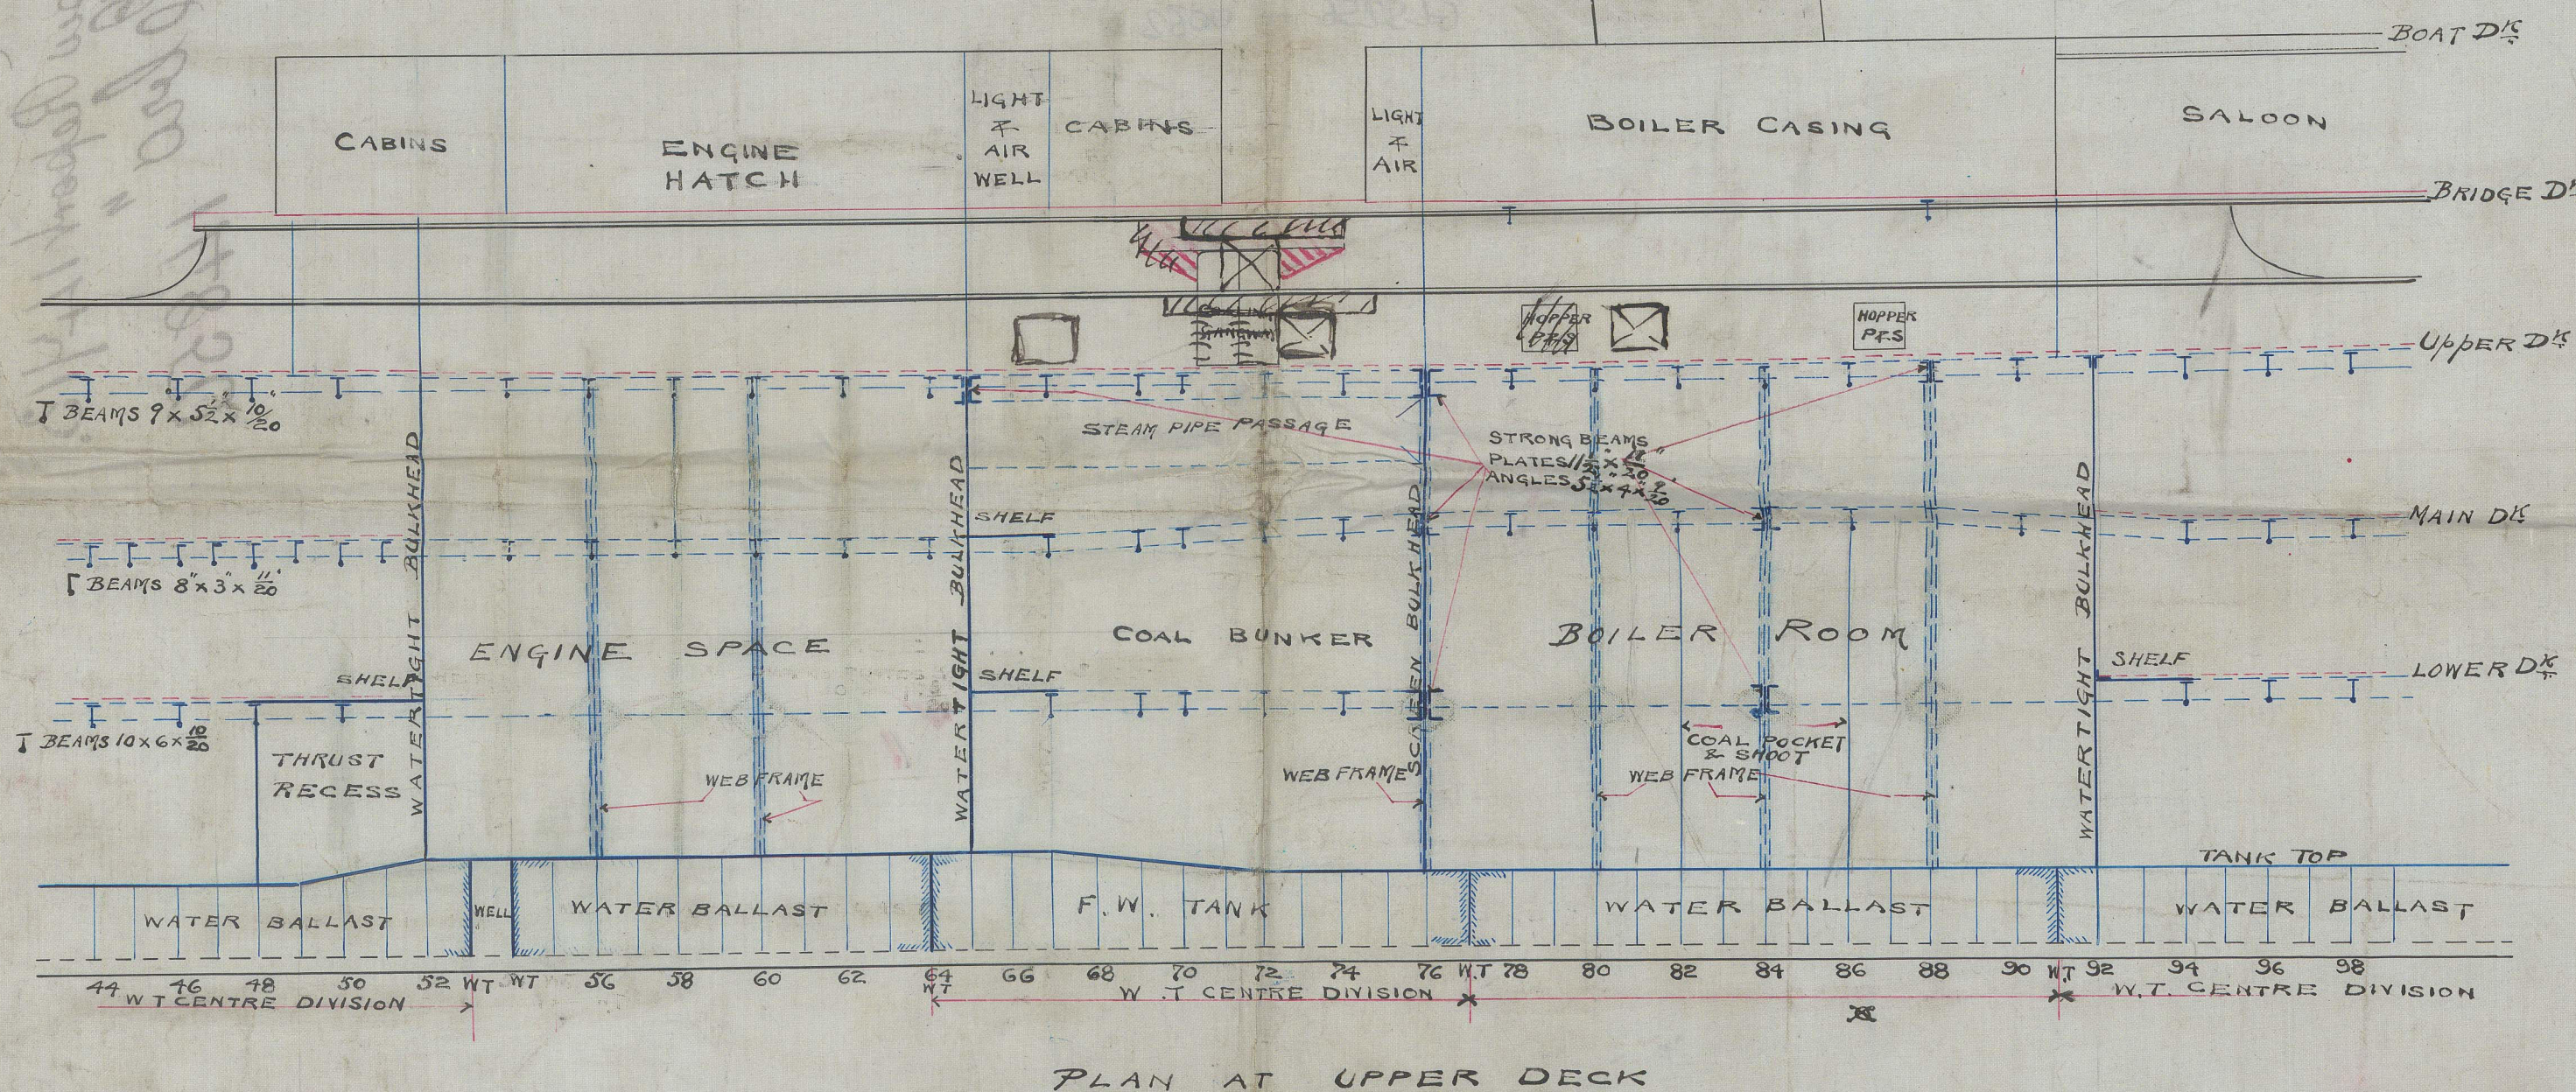


27313
Nº 4-4-9-50-1

AMENDED
 ARRANGEMENT OF MACHINERY SPACE
 SCALE 8 IN = ONE FOOT

H. NAPIER & SONS LTD.
 29/11/95
 PART PROFILE

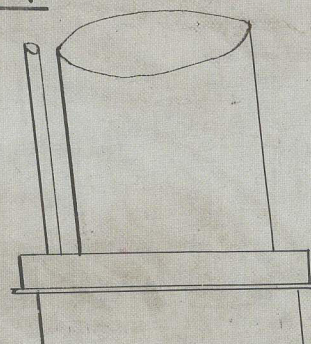

30/11/95

