


27312

No 4-4-9-50-1

3.12.95

Section @ 84 Looking Aft.

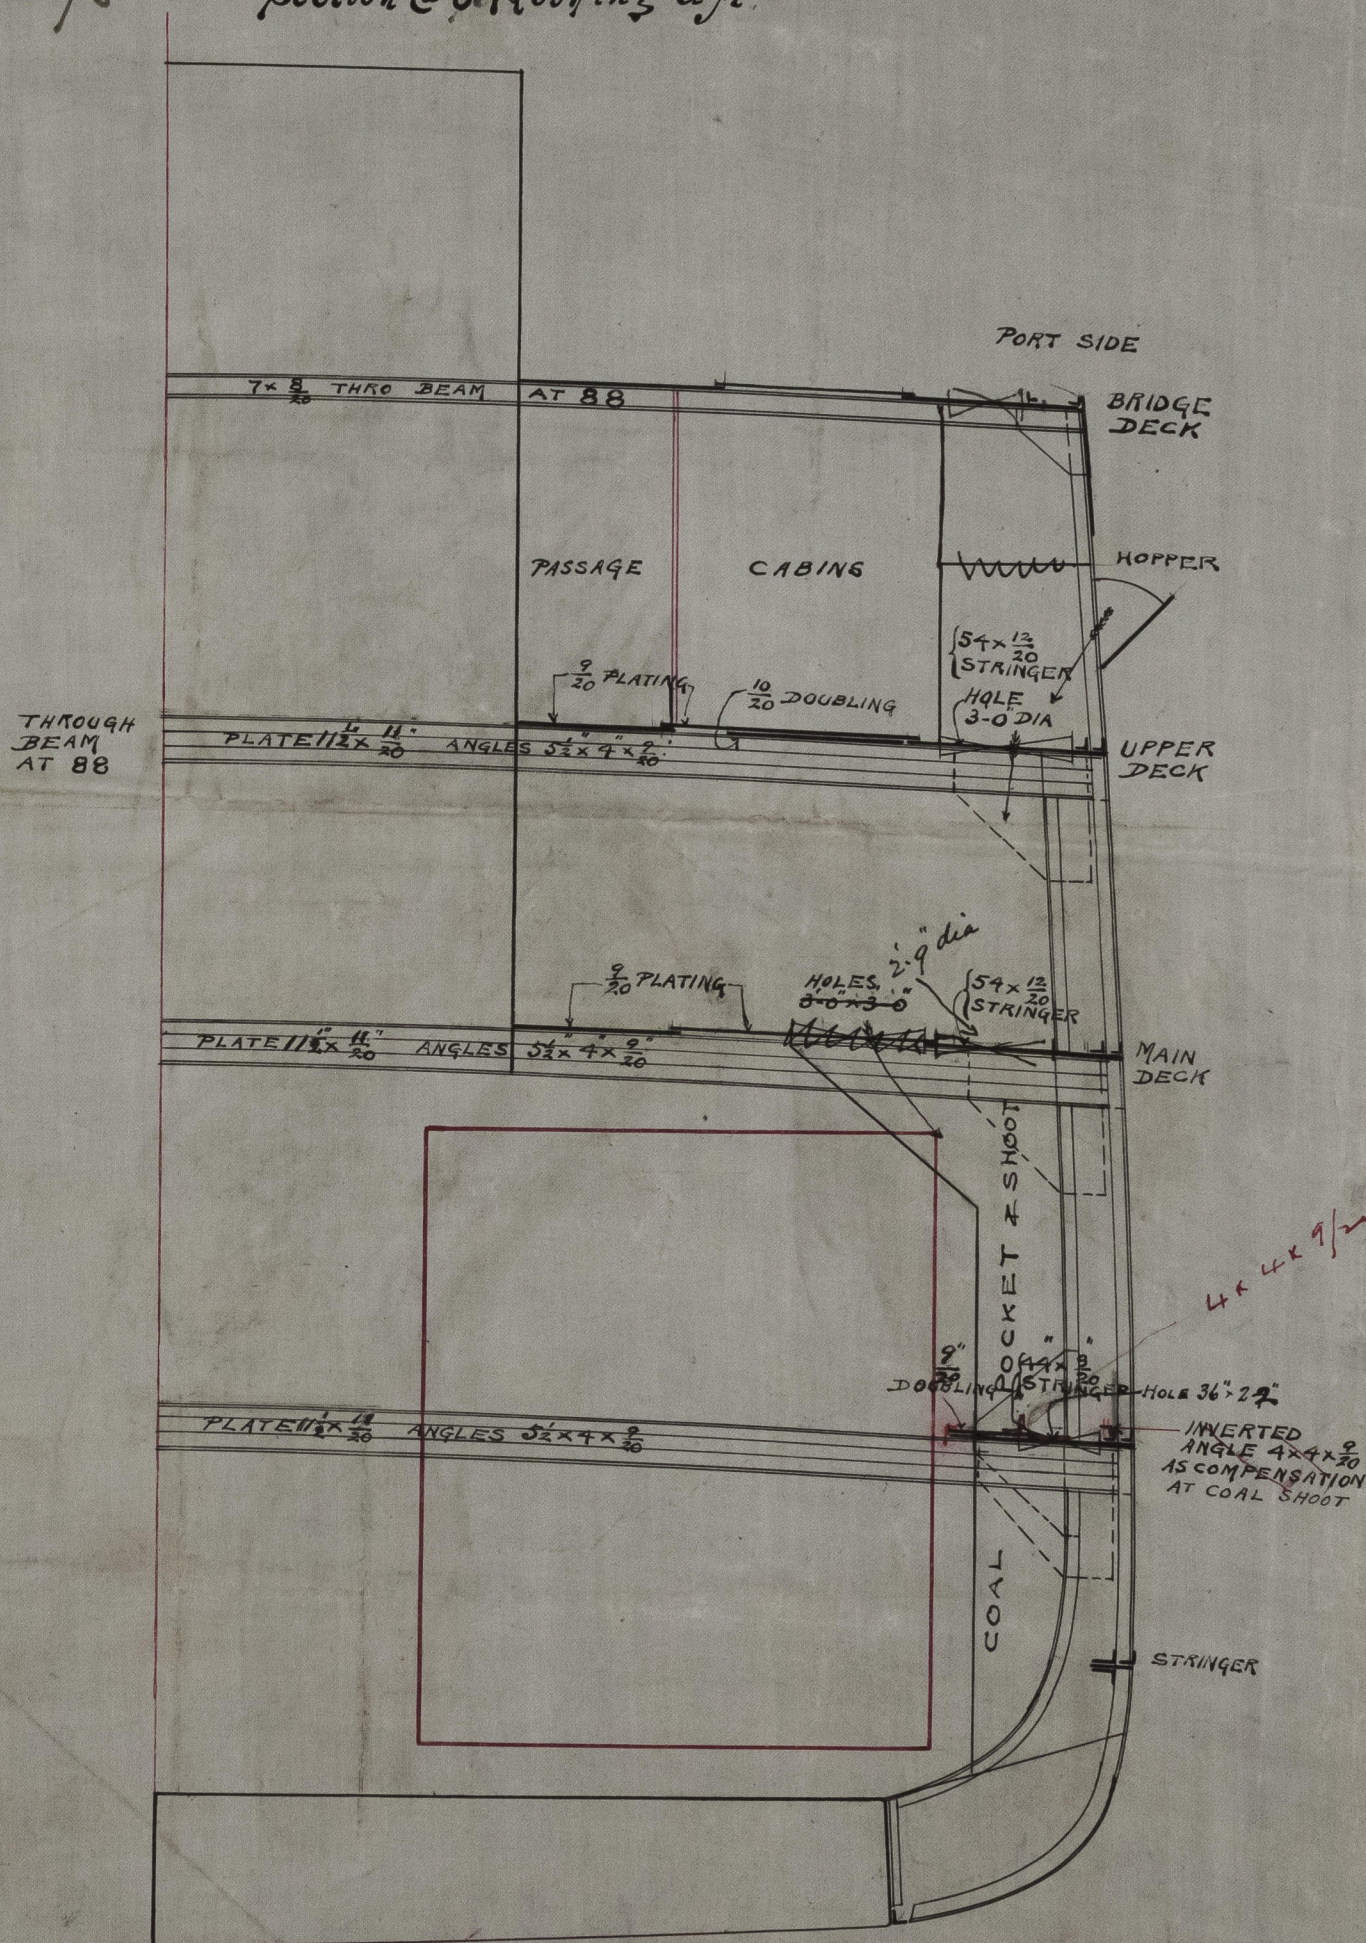

- Amended section -



© 2021

W.A.C.

30/11/96

Lloyd's Register

Foundation

GLS256-0063