

2.5.96  
(119120) 23.5.96



— LONGITUDINAL SECTION & DECK PLANS —

— Nos 114 to 118 —

SCALE  $\frac{1}{4}$  = 1 FOOT

119120

appd. 23/5/96

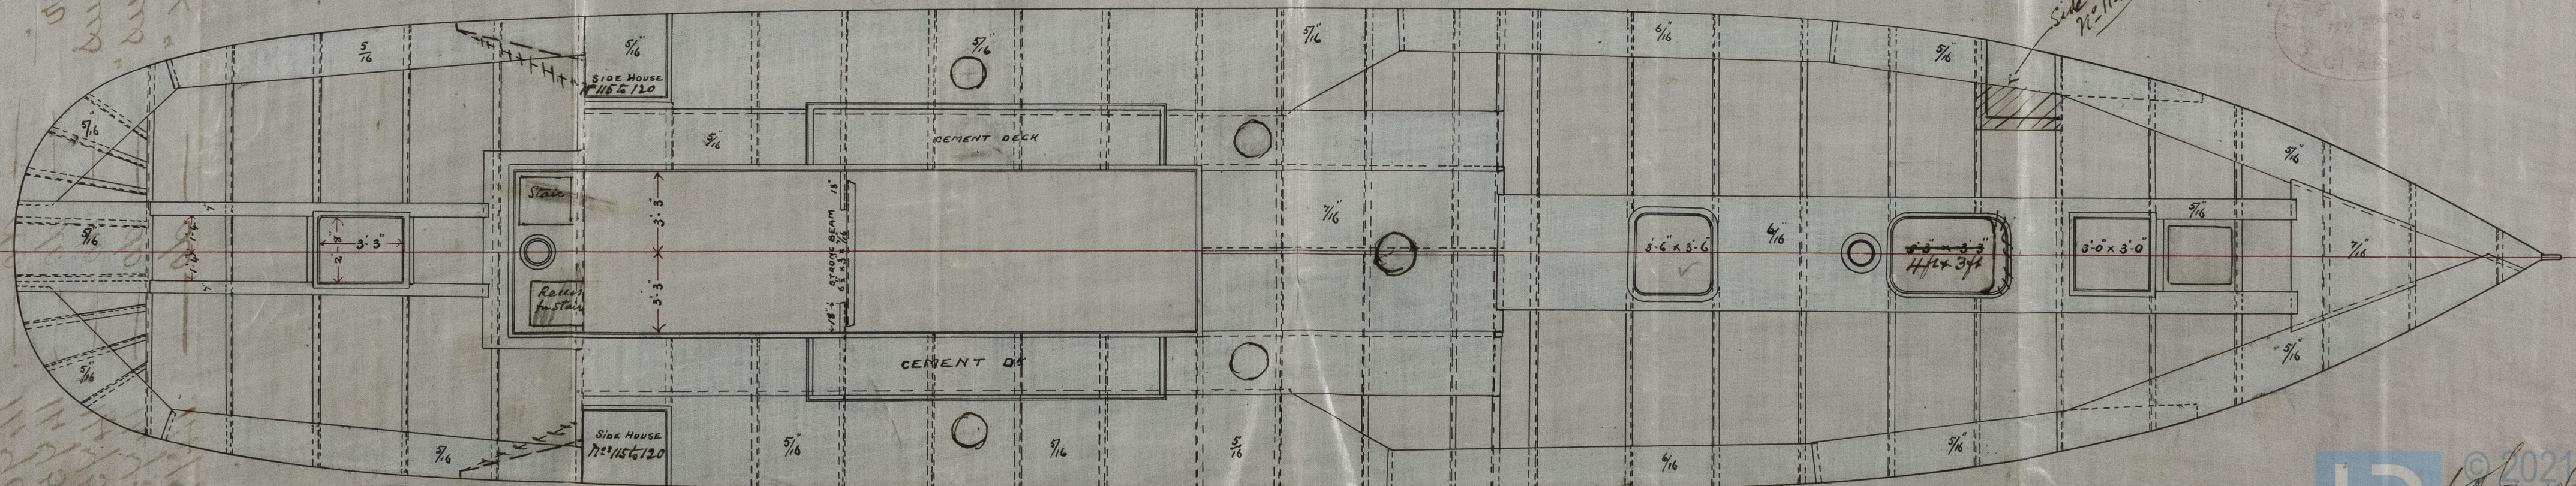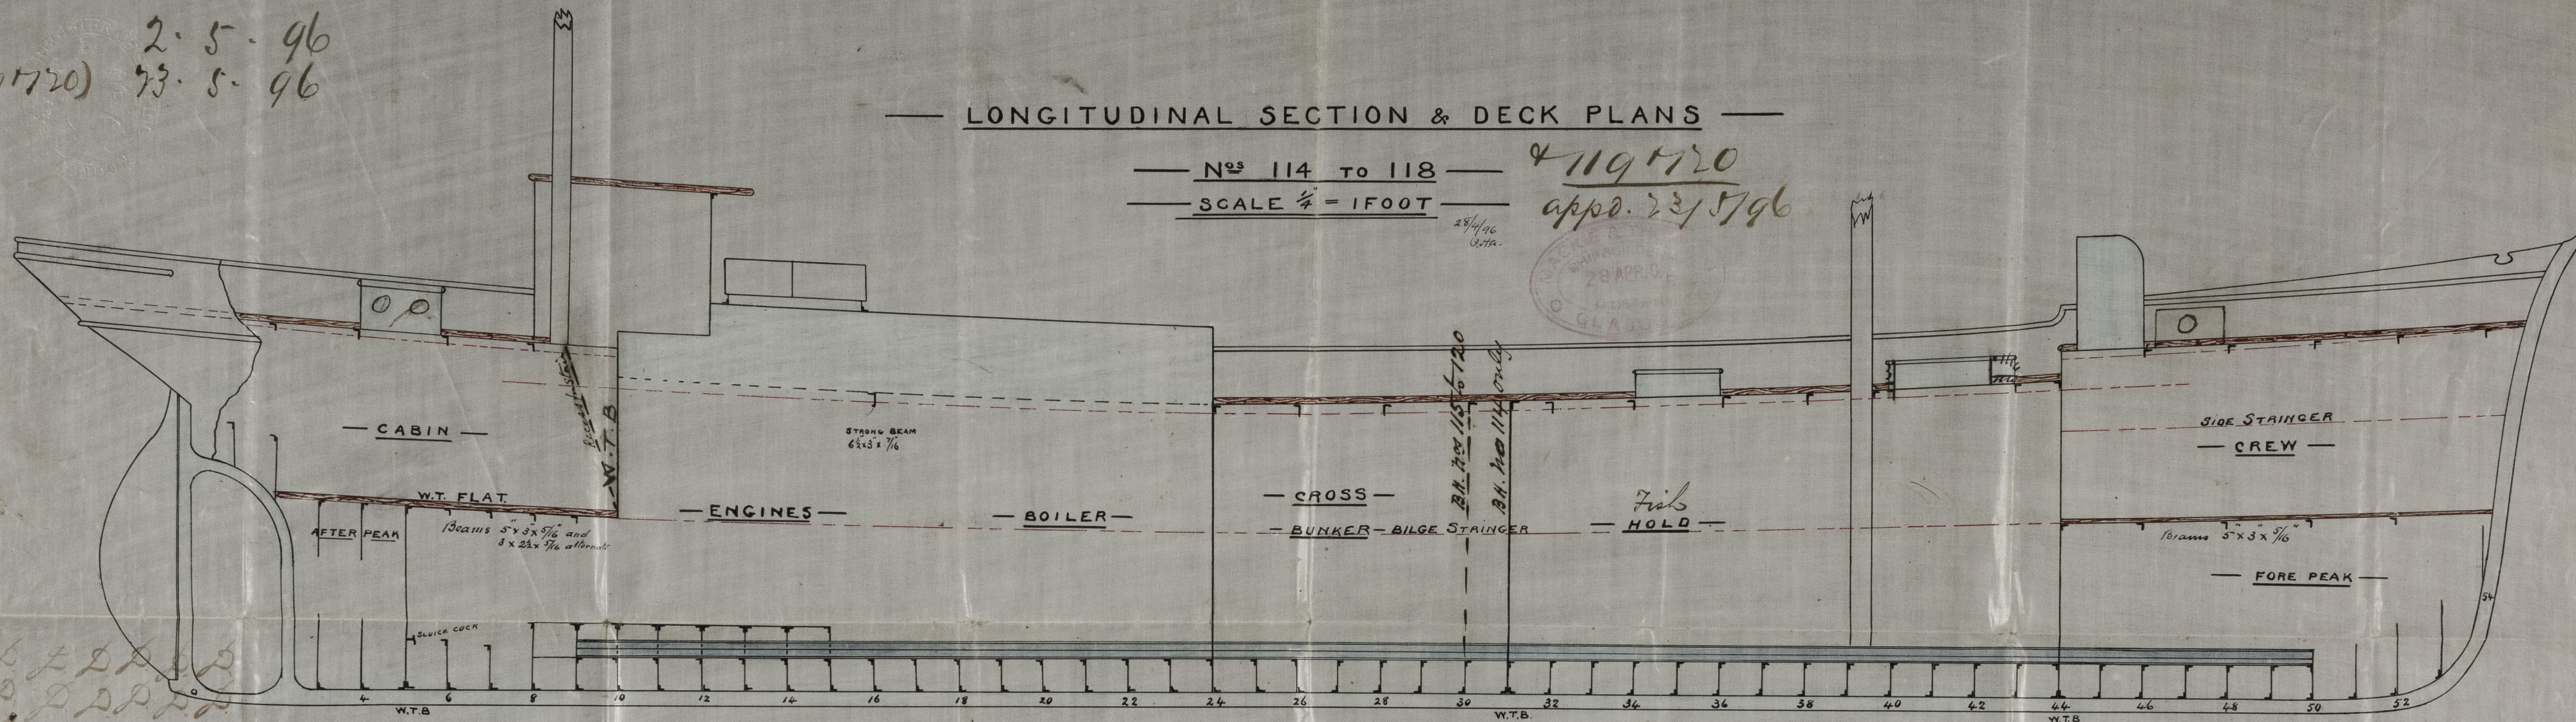

Handwritten notes on the left margin, including '119120' and other illegible text.

23/5/96

GLS257-0002



S.S. Centaur Glasgow Report N<sup>o</sup> 14690  
 S.S. Chameleon — do — 14691  
 S.S. "Crux" — do — 14403.  
 S.S. "Grater" — do — 14450  
 S.S. Cygnus — do — 14451  
 S.S. "Lepus" — do — 14452  
 S.S. Lynx — do — 14448-

GLS251-0002

LONGITUDINAL SECTION & DECK PLANS






© 2021  
 Lloyd's Register  
 Foundation