

Lloyd's Register of British and Foreign Shipping.

(Report on Vessel No. 14690 Port Glasgow  
Centaur)

No. 3276 SHIP FORGINGS ~~OR CASTINGS~~.

The words FORGINGS or CASTINGS, IRON or STEEL, should be struck out as may be required.

I have to report that the undermentioned Iron ~~or Steel~~ Forgings ~~or Castings~~,  
manufactured by Messrs Emerson Walker & Thompson  
of Dunston for the Vessel No. 114, being built  
by Messrs Mackie & Thompson of Glasgow  
have been inspected by me as set forth below, and found to be, so far as can be seen,  
sound

Mark on Forgings.

Lloyd's  
No. 5615B  
JG


*John O'Grady*

Newcastle

8. 9. 96

	STERN FRAME.	RUDDER FRAME.	STEM.
Material* ... ..	<u>Scrap Iron</u>	<u>Scrap Iron</u>	/
How made ... ..	<u>Forged</u>	<u>Forged</u>	
Dimensions ... ..	<u>6 - 2 1/2</u>	<u>3 1/2 - 2 1/4</u>	
Progress on Inspection	<u>Forged &amp; Smitted</u>	<u>Forged &amp; Smitted</u>	
Date when Inspected	<u>May 22 to June 12/96</u>	<u>August 1 to 18/96</u>	

SKETCHES OF FRAMES SHOWING POSITION AND DESCRIPTION OF WELDS OF FORGINGS, OR PARTICULARS OF TESTS APPLIED TO CASTINGS.

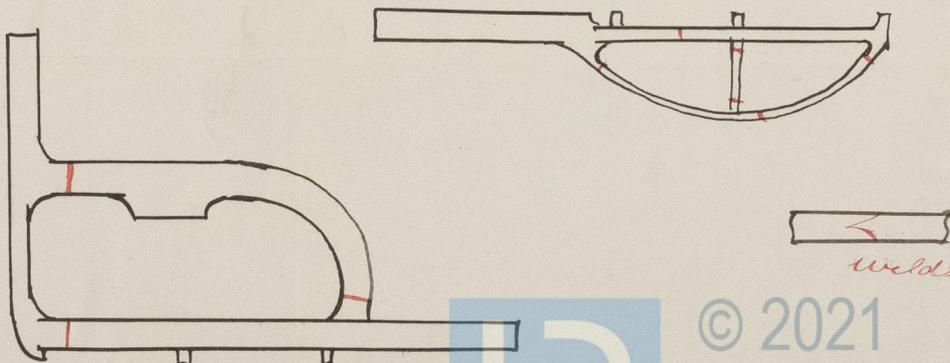

Fee (if any chargeable) £ : :

To be paid at

© 2021  
Lloyd's Register  
Foundation

No 114

Stern frame

+  
Rudder frame



© 2021

Lloyd's Register  
Foundation