



Riveting 12 Frames and Edges of Shell T.S.S. Nos 394 and 5.

4 396 <sup>17</sup> appo. 6/8/96.

4 398 " 3/9/96.

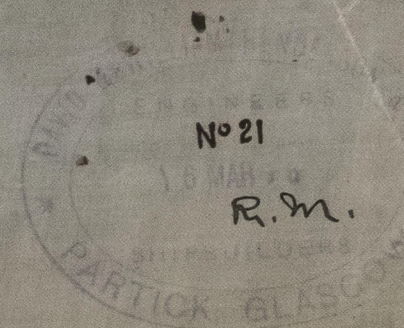

19. 3. 96  
 28. 3. 96  
 6. 8. 96 (396 <sup>17</sup>)  
 3. 9. 96 (398.)

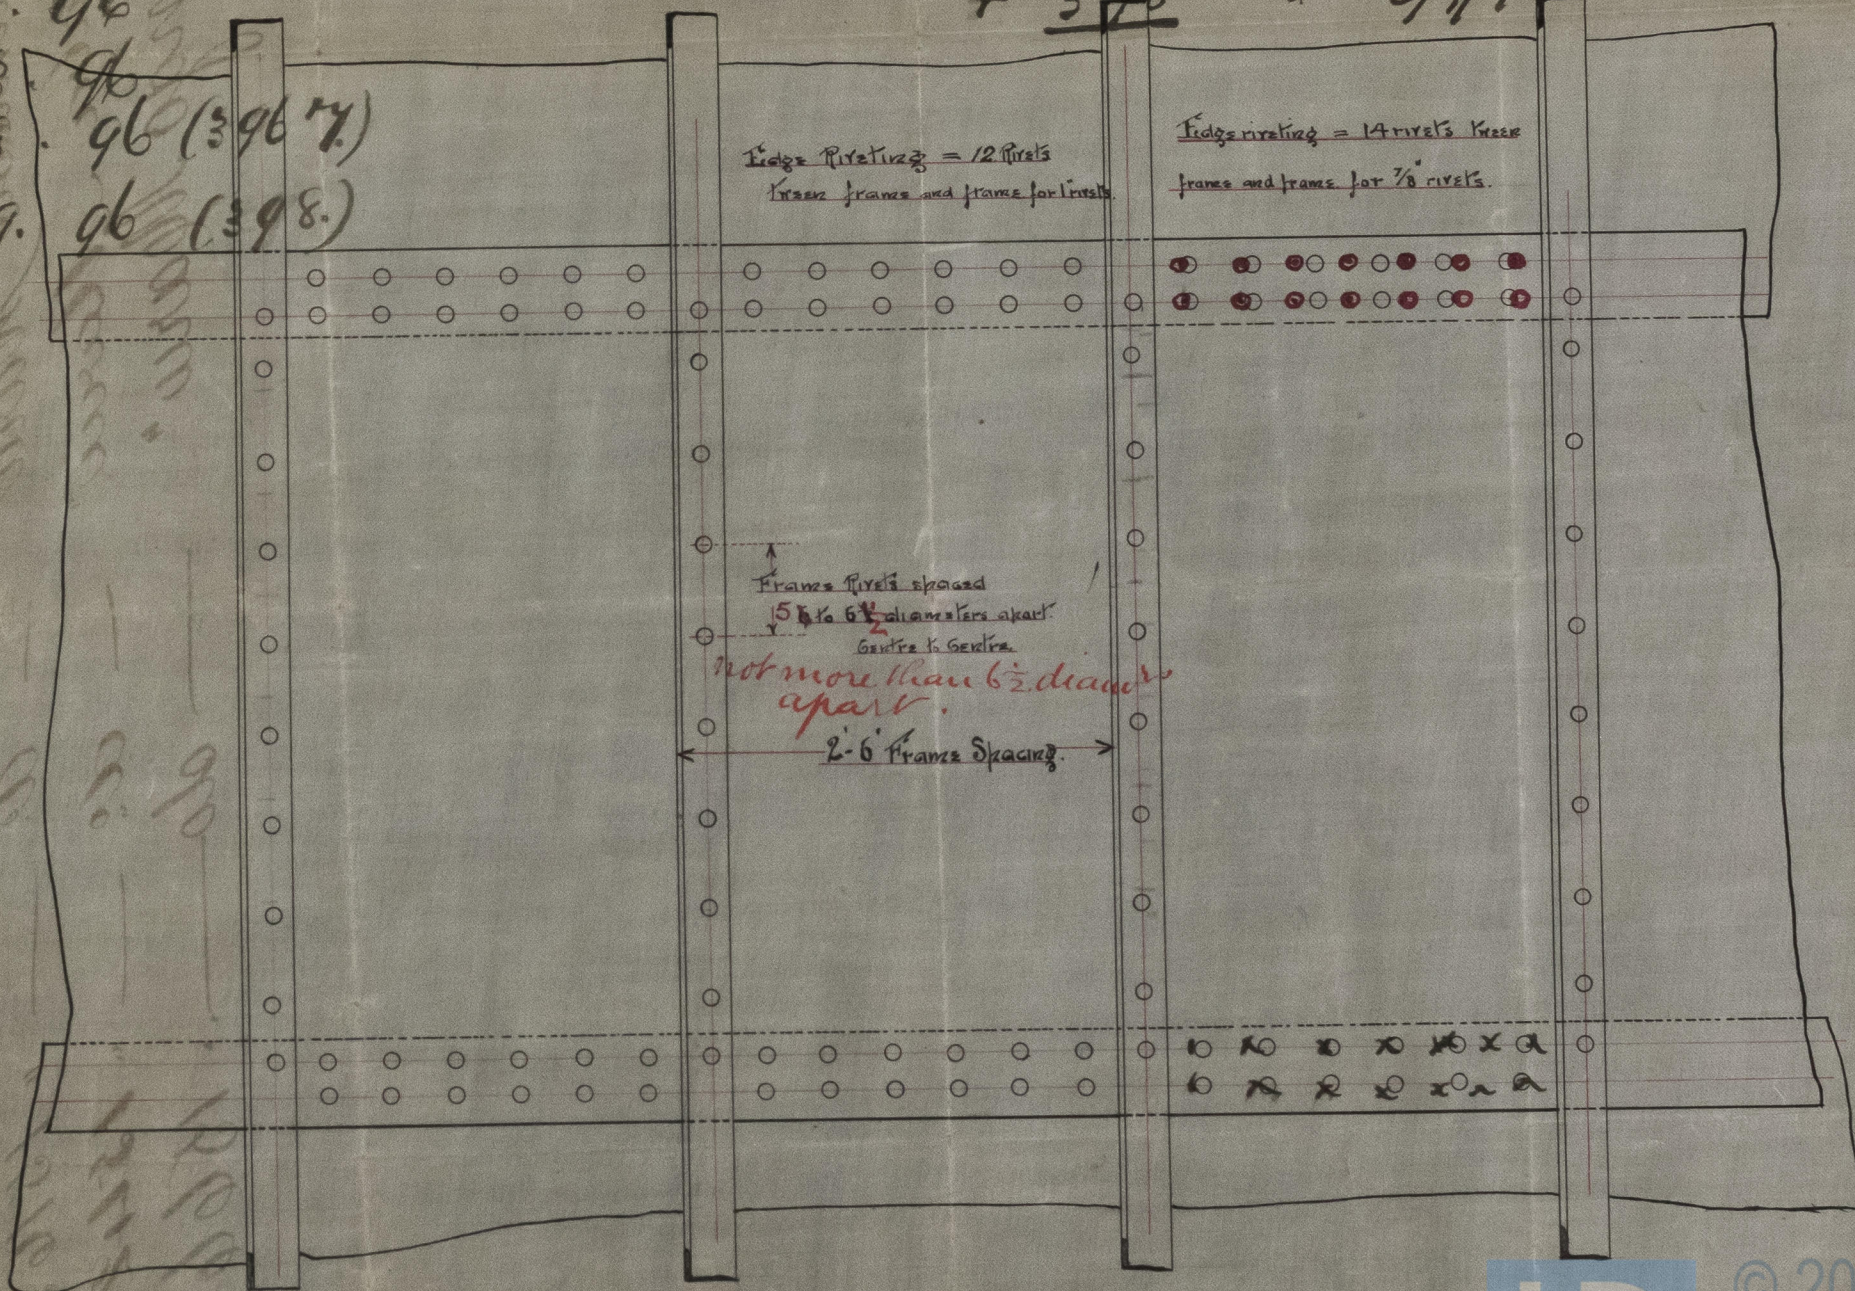

27/1  
 19/3/96  
 28/3/96



© 2021

Lloyd's Register  
 Foundation



