


6.3.96  
12.3.96  
15.3.96  
28.3.96  
19.6.96

 

Longitudinal Section  
Twin Screw Steamer 42394. 65  
Scale 1/4" = 1 Foot.  
Dimensions 445'-0" x 49'-2" x 33'-6" Moulded.

The beams of all decks to be as indicated on sketch of midship section



19/6

19/6


30 spacing x 25 spacing




S. S. Kanagawa Maru Glasgow Report 14840.  
S. S. Hakata Maru do 15019.

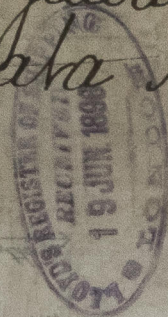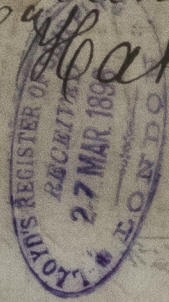

Henderson  
394

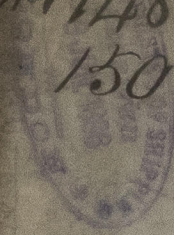

30.00000 x 32.00000

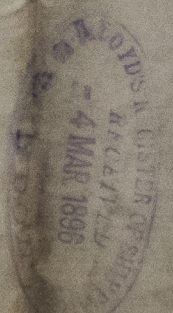

GLS258 - 0087



Lloyd's Register  
Foundation