



25.9.96  
25.9.96

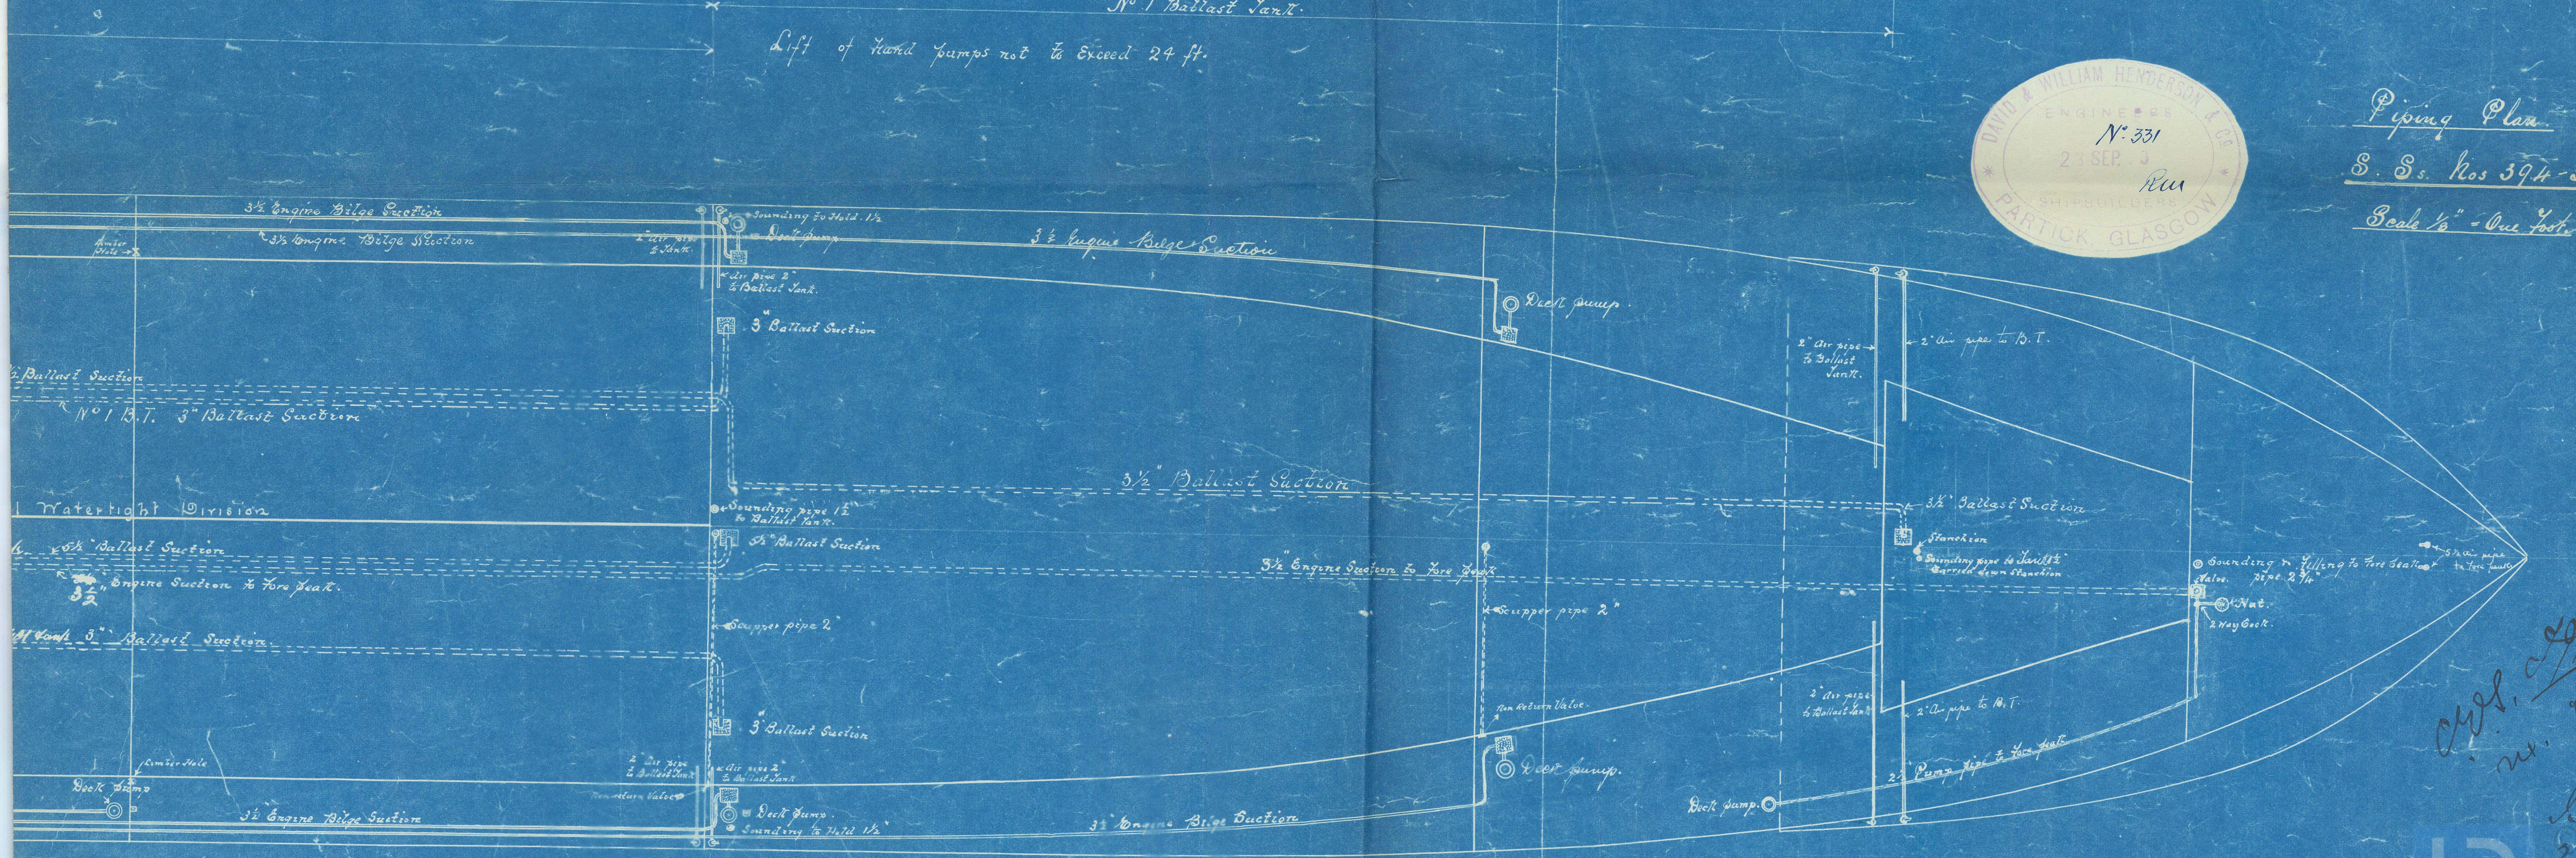

Piping Plan  
S. S. Nos 394-5  
Scale 1/2" = One Foot

Appd. 25/9/96  
Mr. 1

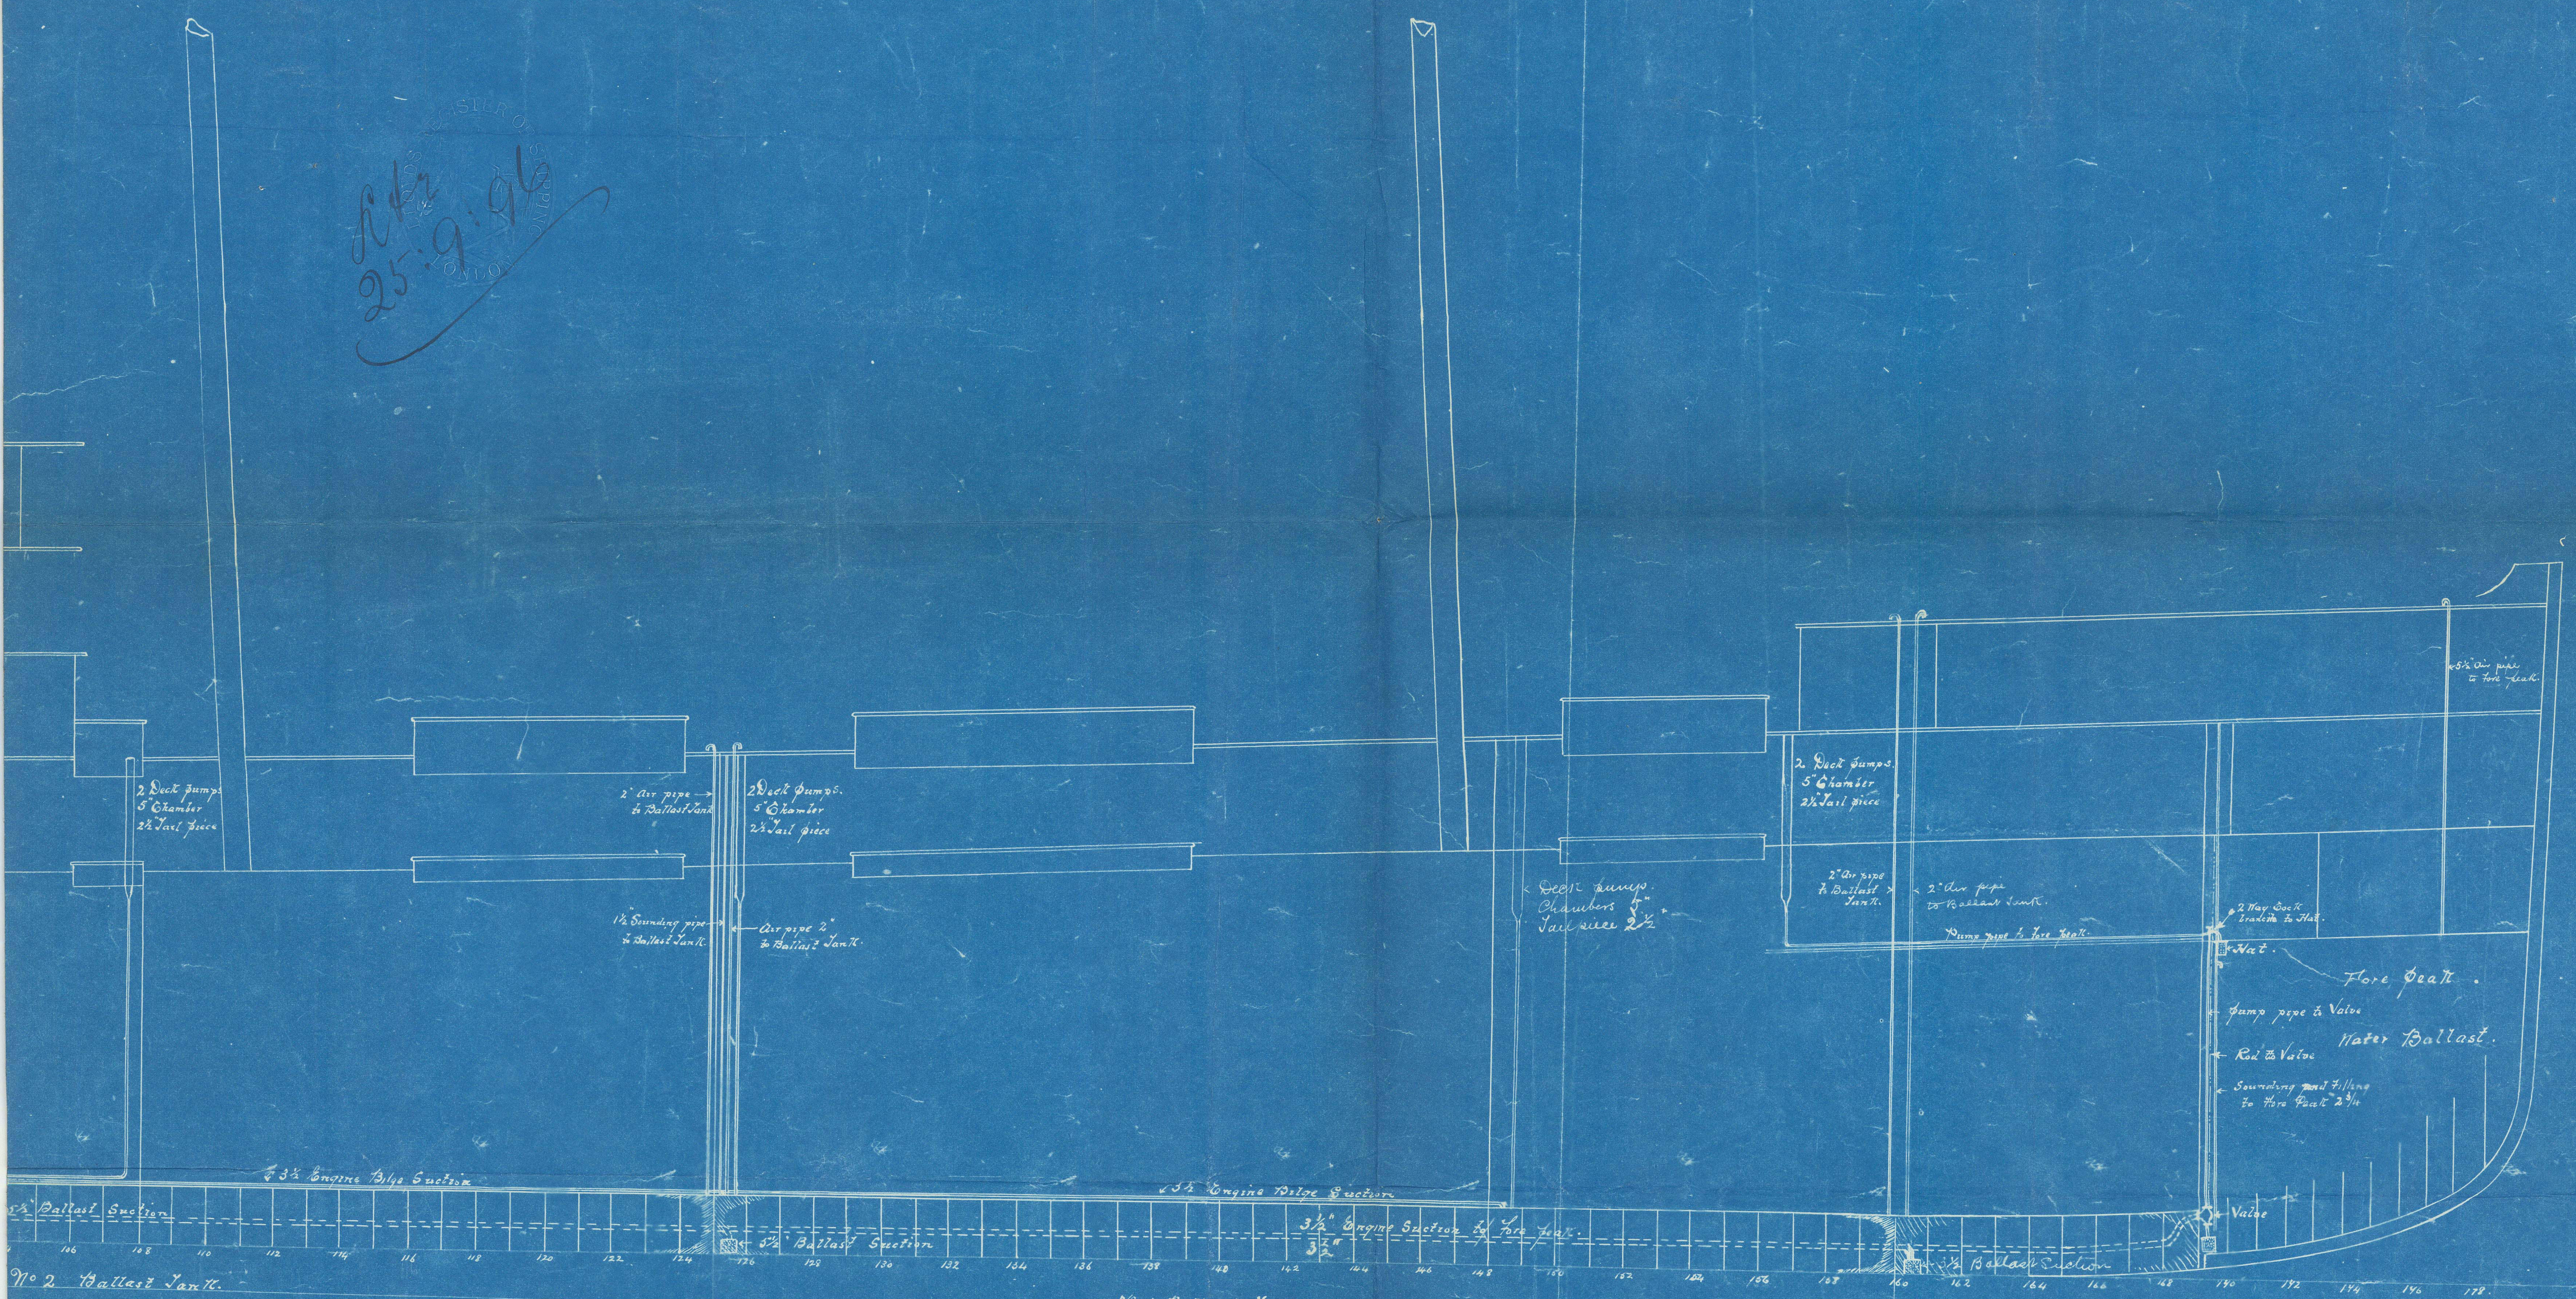



S. S. "Kanagawa Maru" Glasgow Report No. 14840.—  
S. S. "Hakata Maru" do " 15019.—  
Pumping at bow



No. 394 + 395  
only



