



S.S. "SEVERN"  
 SKETCH OF ALTERATIONS AFT  
 SCALE 1/4" INCH = 1 FOOT

S. MCKNIGHT & CO., LIMITED

Alterations shown in Red.

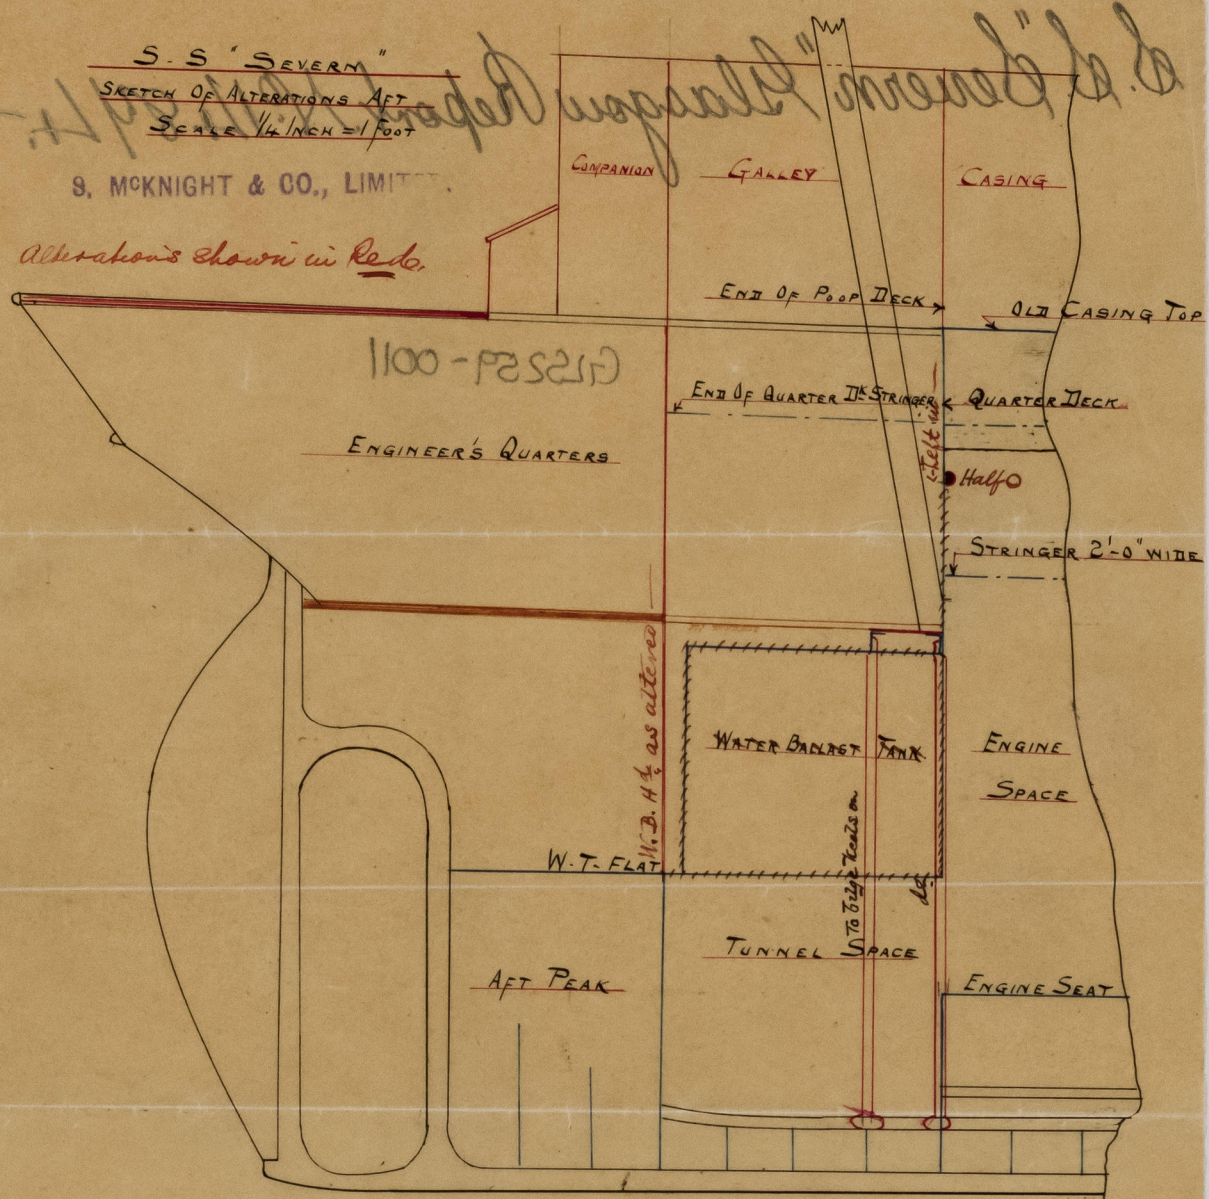

IRON POOP DECK SHEATHED WITH 5x3" PITCHING

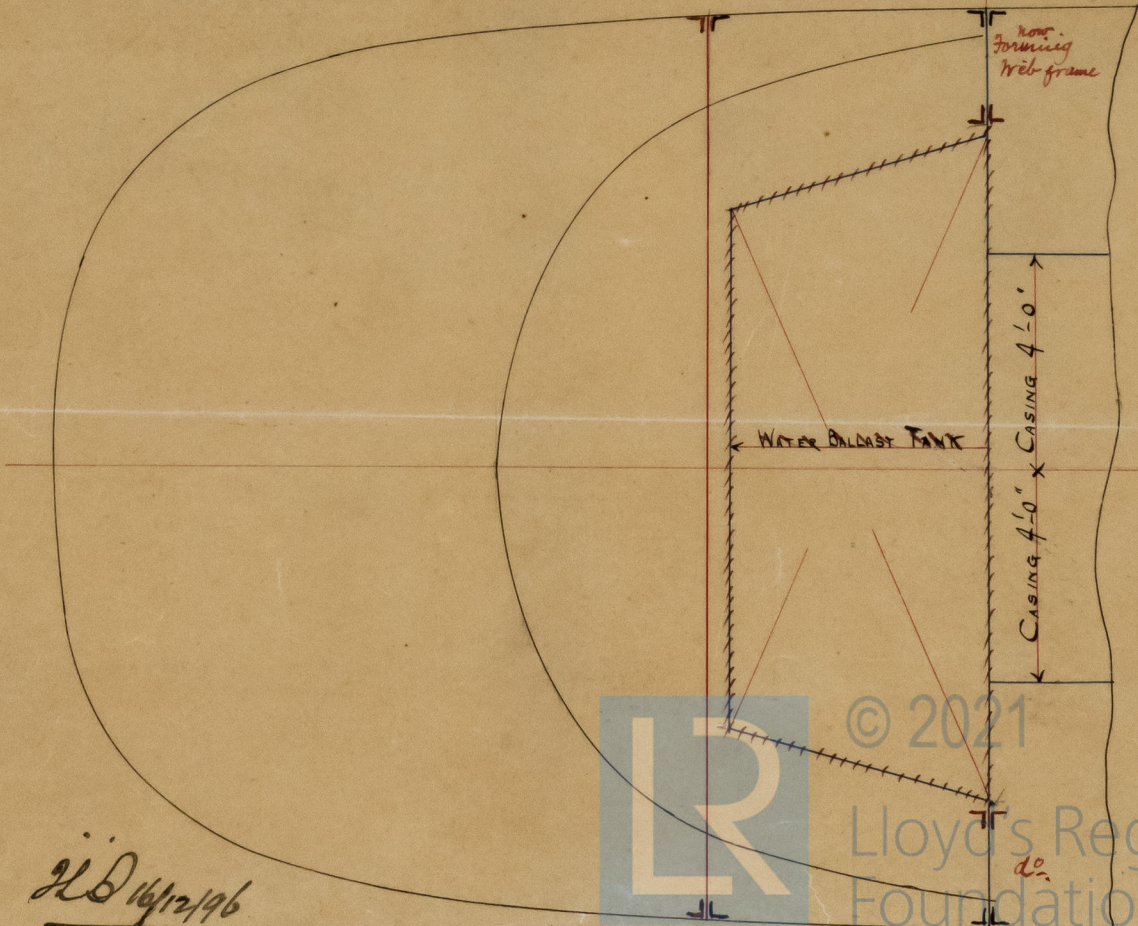


GLS259-0011



S. S. "Severn" Glasgow Report A.P. 14.87/4.



GLS259-0011

ENGINEER'S QUARTERS






© 2021  
Lloyd's Register  
Foundation

GLS259-0011