

Lloyd's Register of British and Foreign Shipping.

(Report on Vessel No. 14892 Port Glasgow
"Nisa")No. 5308 SHIP FORGINGS OR CASTINGS.

I have to report that the undermentioned Iron or Steel Forgings or Castings,
 manufactured by Messrs Robt Kerr & Sons
 of Irvine for the Vessel No. 369, being built
 by Messrs Alex & Stephen Sloan of Glasgow
 have been inspected by me as set forth below, and found to be, so far as can be seen,
Sound & efficient

Mark on Forgings.

Lloyd's

No. 5308

WH


William Hamilton

Glasgow

29/8/96

	STERN FRAME.	RUDDER FRAME.	STEM.
Material* ...	Scrap iron		
How made ...	Forged		
Dimensions ...	11 ft 4 1/2		
Progress on Inspection	Forging & finishing		
Date when Inspected	21/4/96 to 21/8/96		

SKETCHES OF FRAMES SHOWING POSITION AND DESCRIPTION OF WELDS OF FORGINGS, OR PARTICULARS OF
 TESTS APPLIED TO CASTINGS.

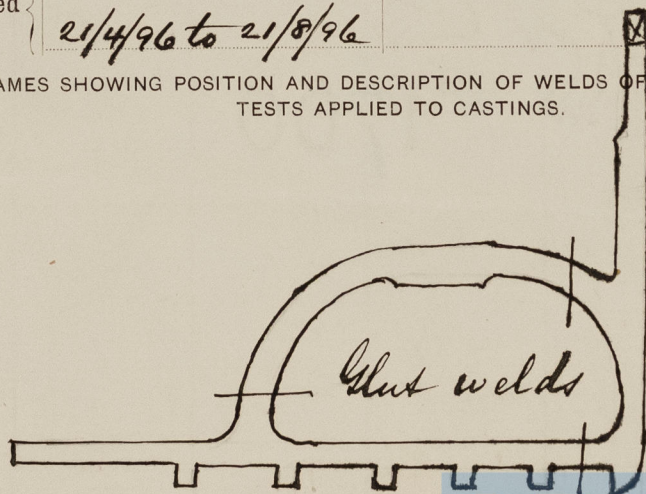

Fee (if any chargeable) £ : :

To be paid at