


26.5.96

PLAN OF RUDDER S.S. N^o 369

Alex^r Stephen & Sons.
SHIPBUILDERS & ENGINEERS
GLASGOW

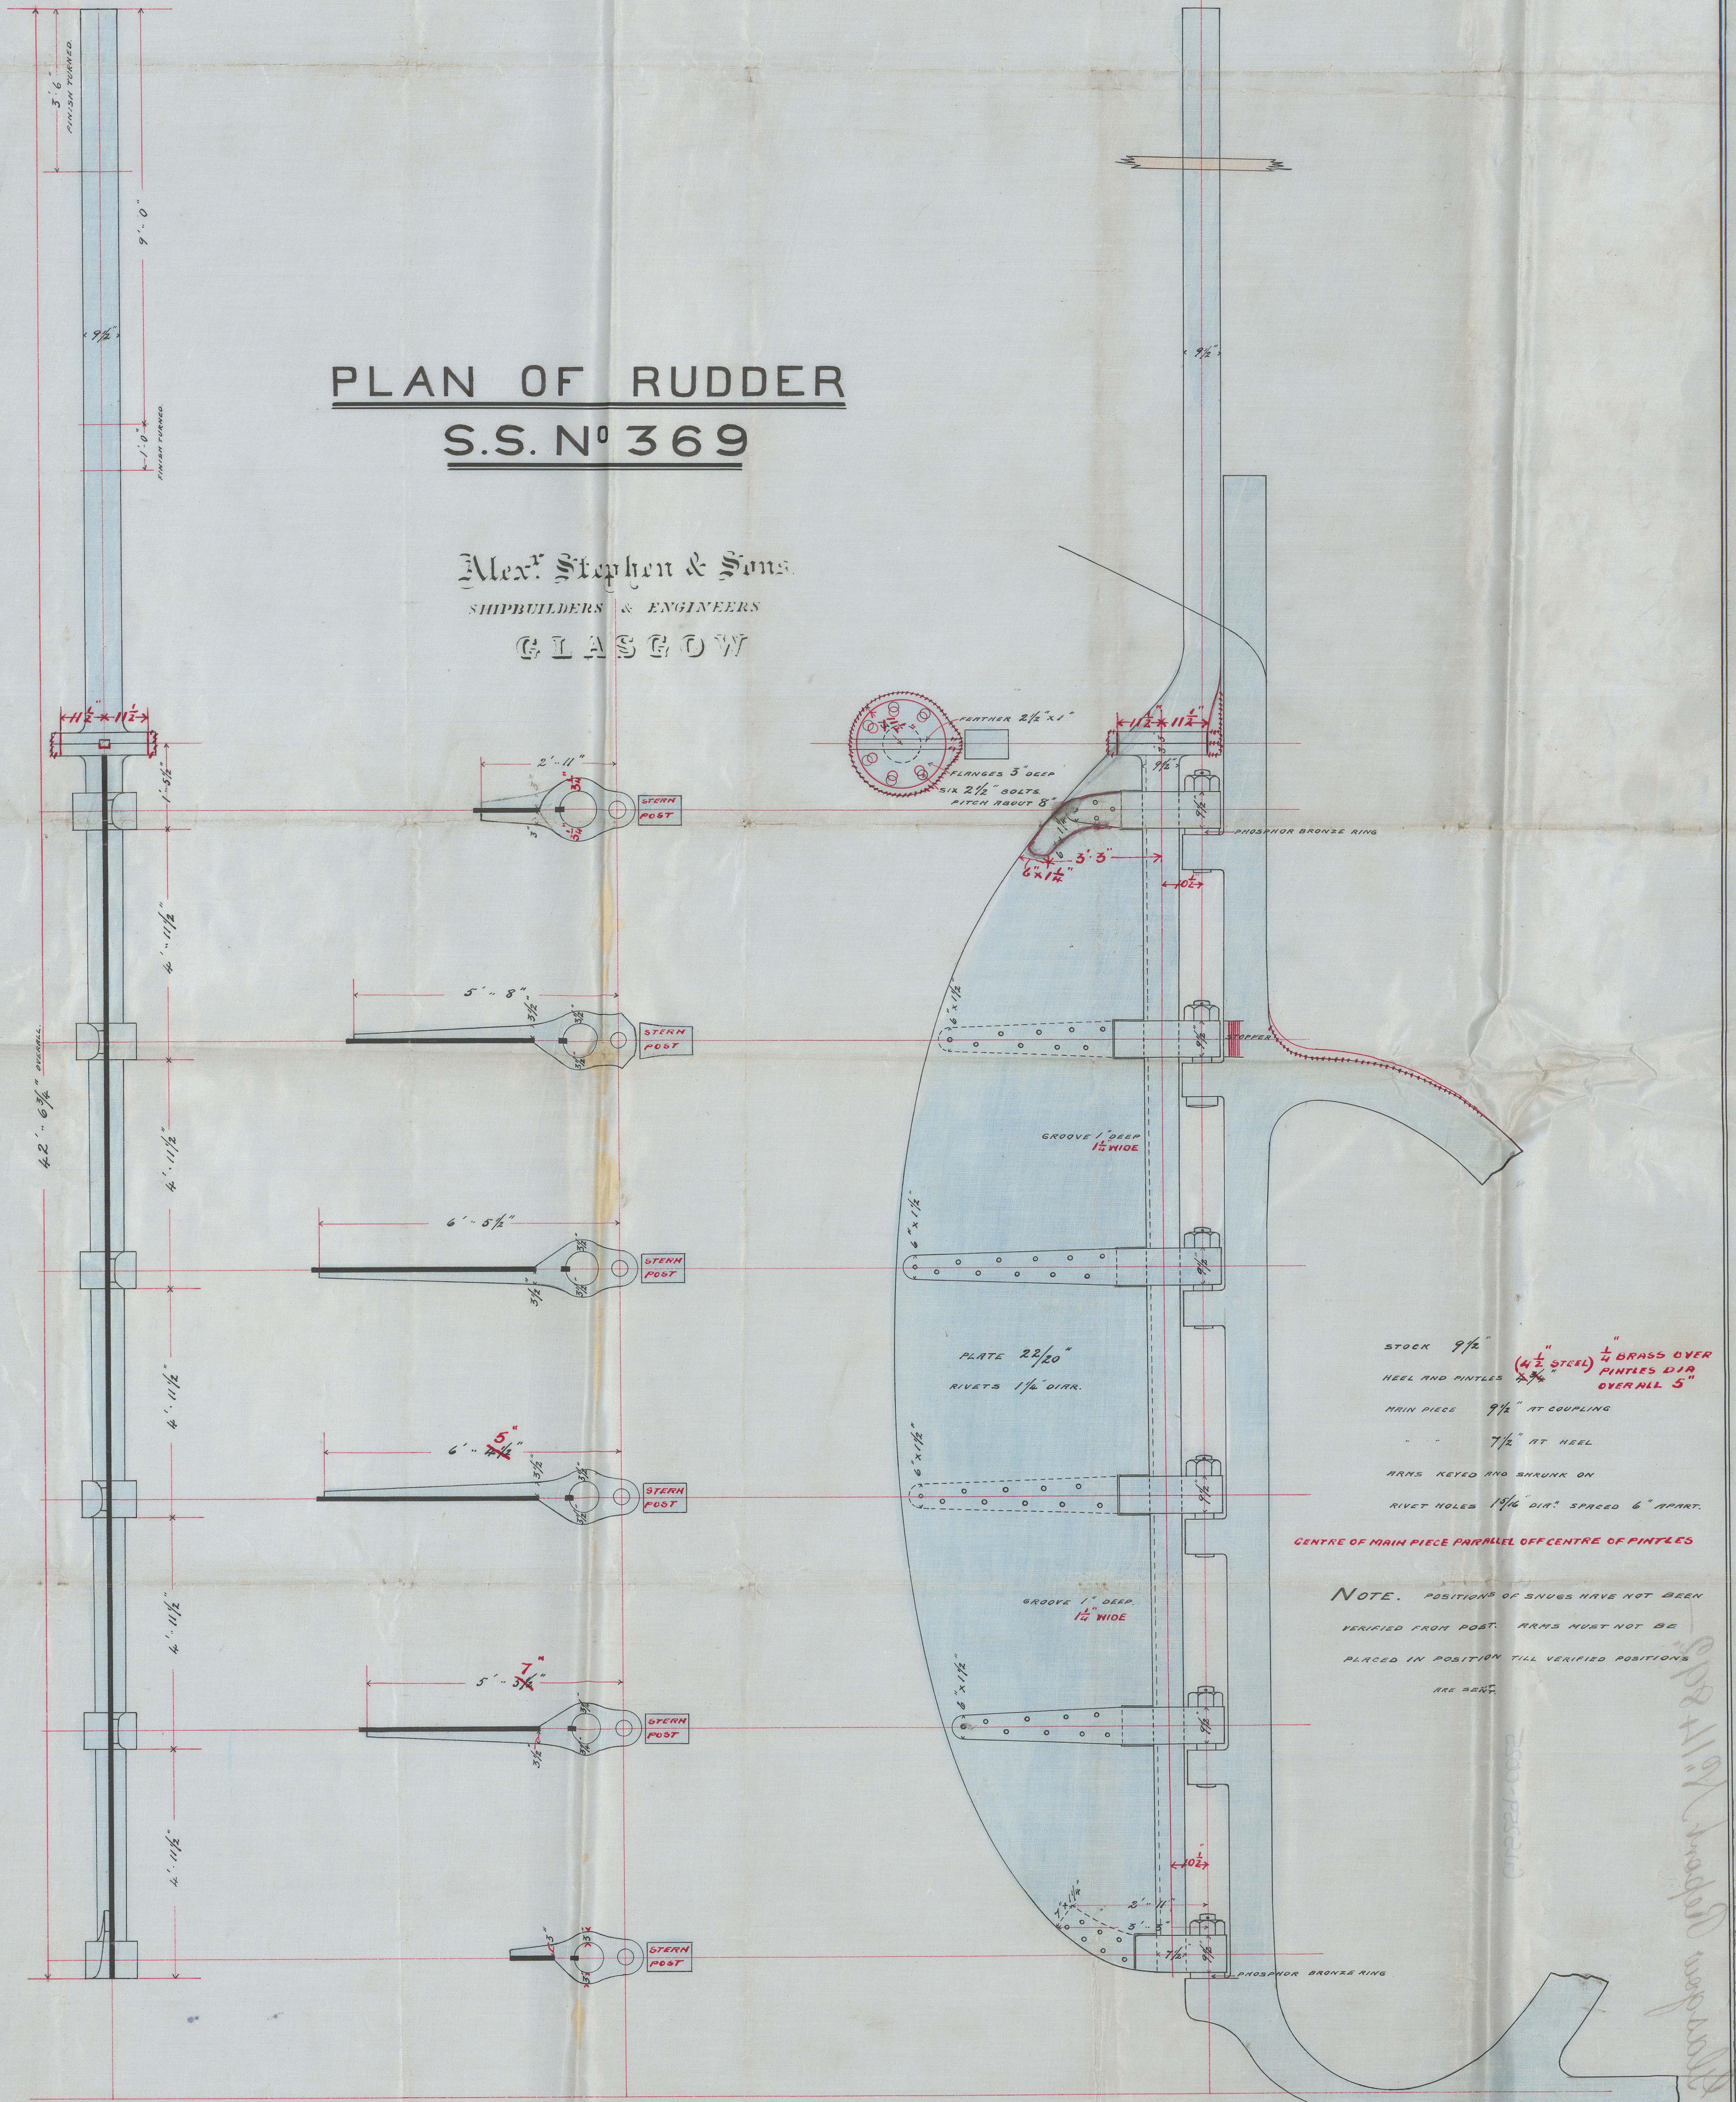

Scale 1/4" INCH TO A FOOT

DRAWING N^o 7765
J. W. 36 23/5/96
26/5/96
22/5/96
W. H. G.

GLS259-0025

A. S. Pisa "Glasgow Report No. 14892."

LOYD'S REGISTER OF SHIPBUILDING
26 MAY 1906

GLS259-0025

© 2021

Lloyd's Register
Foundation

