

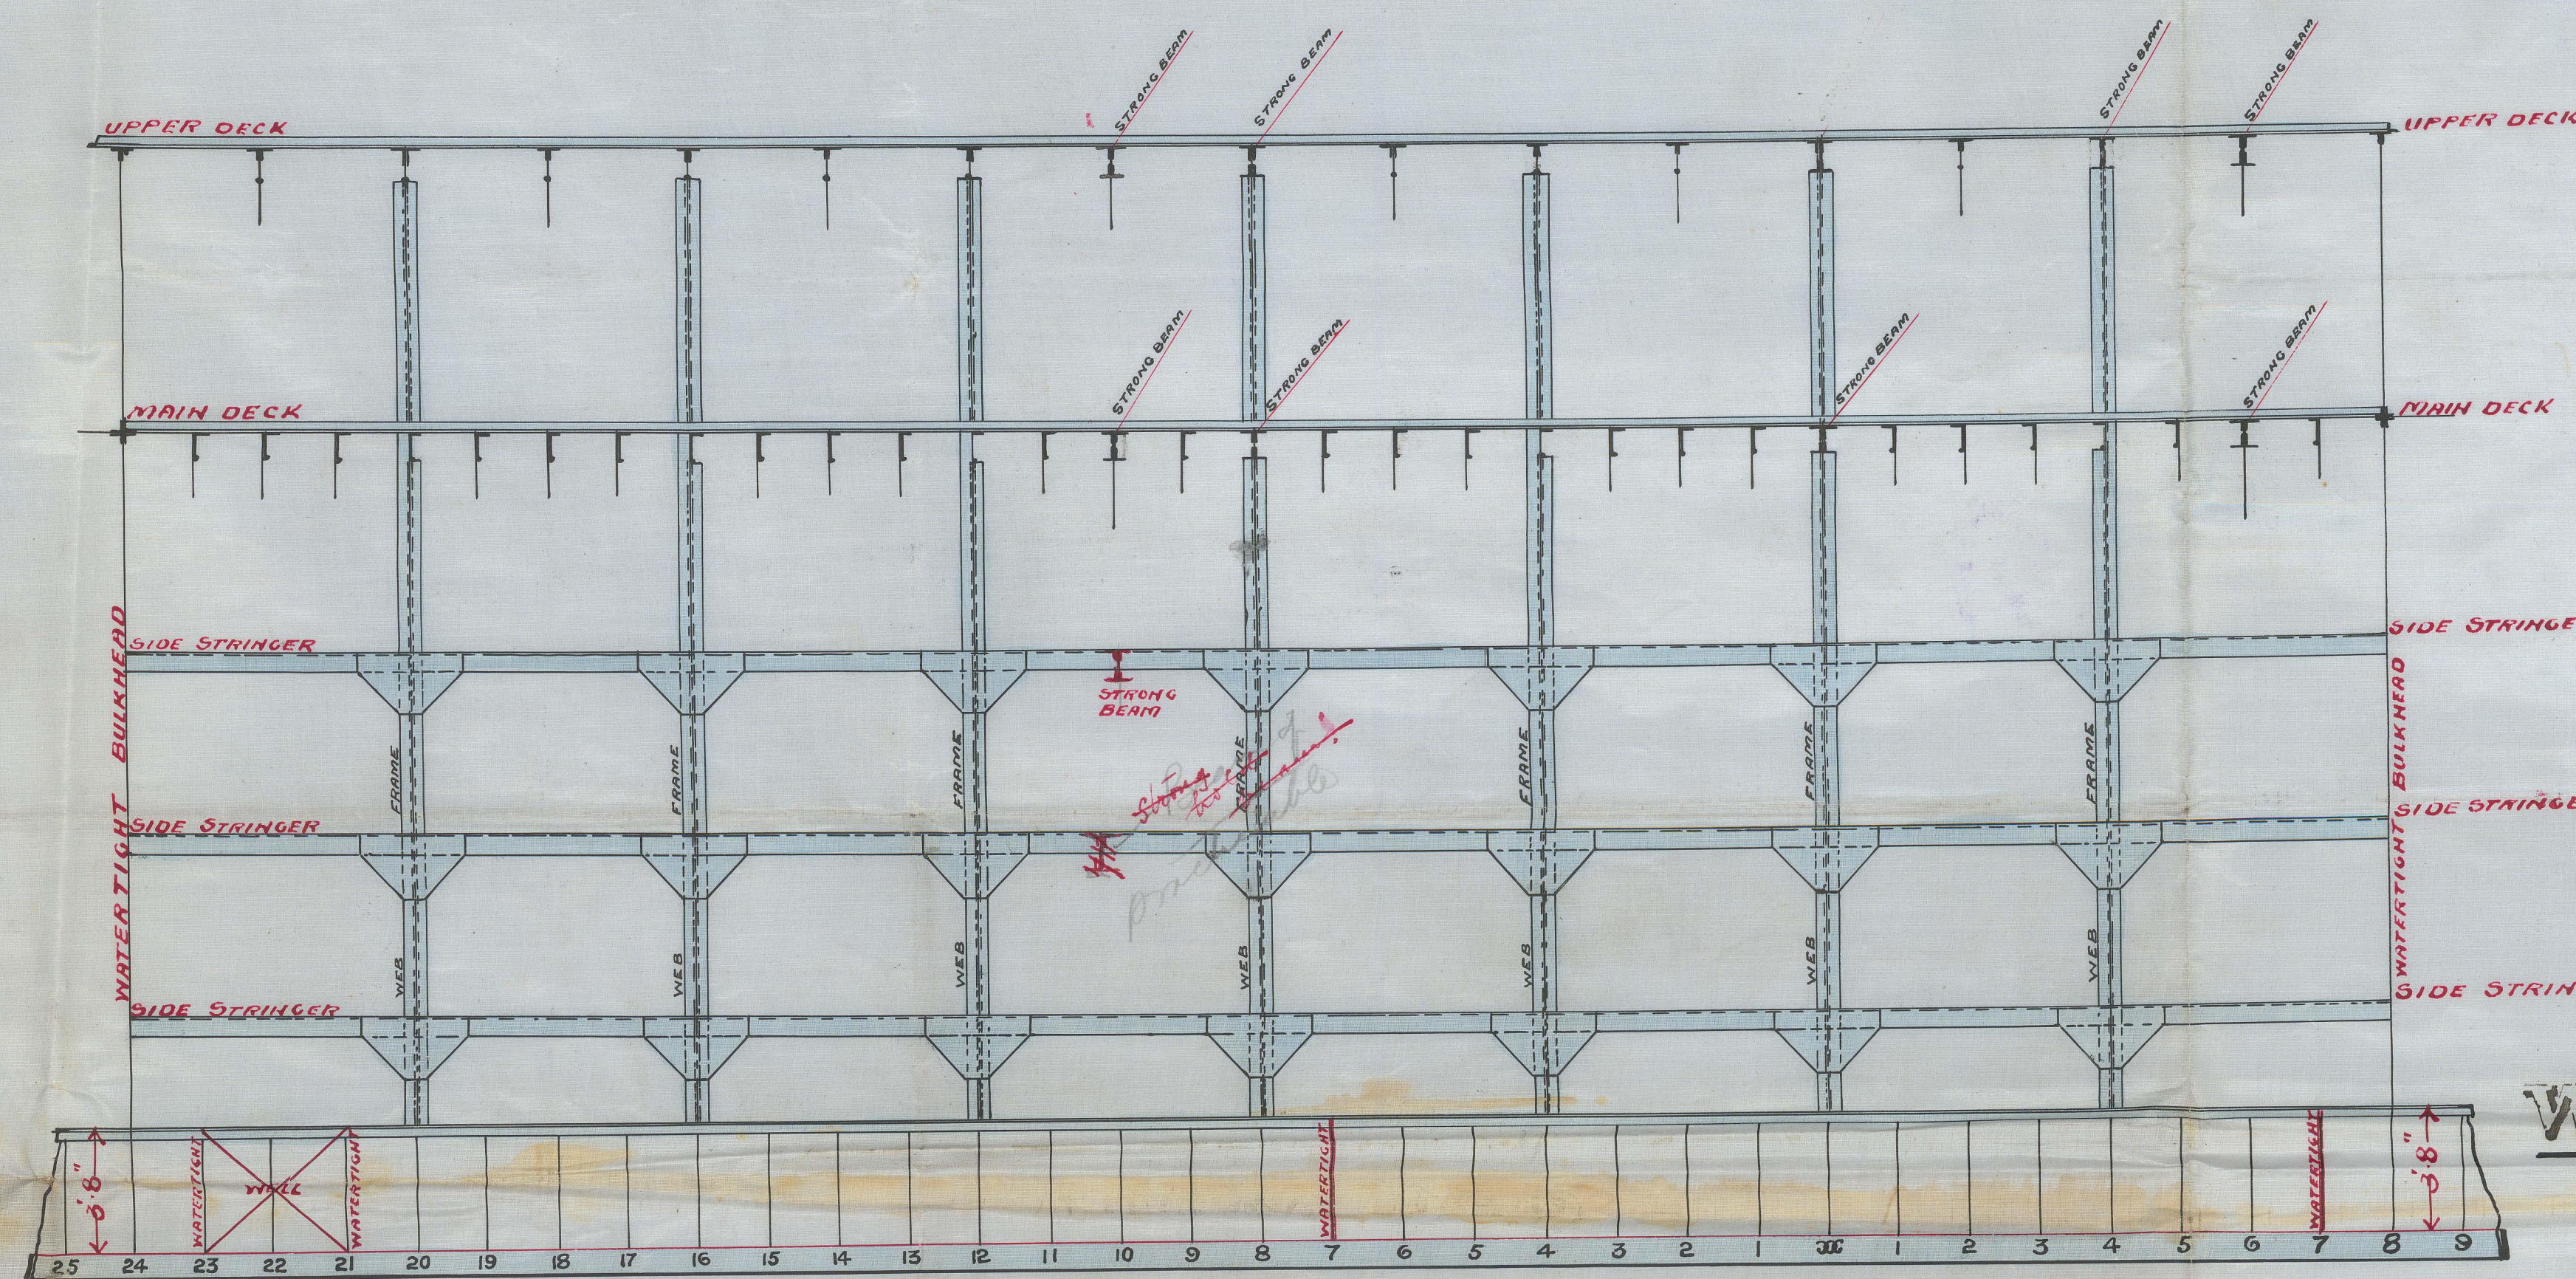


15.5.96


15281-0030

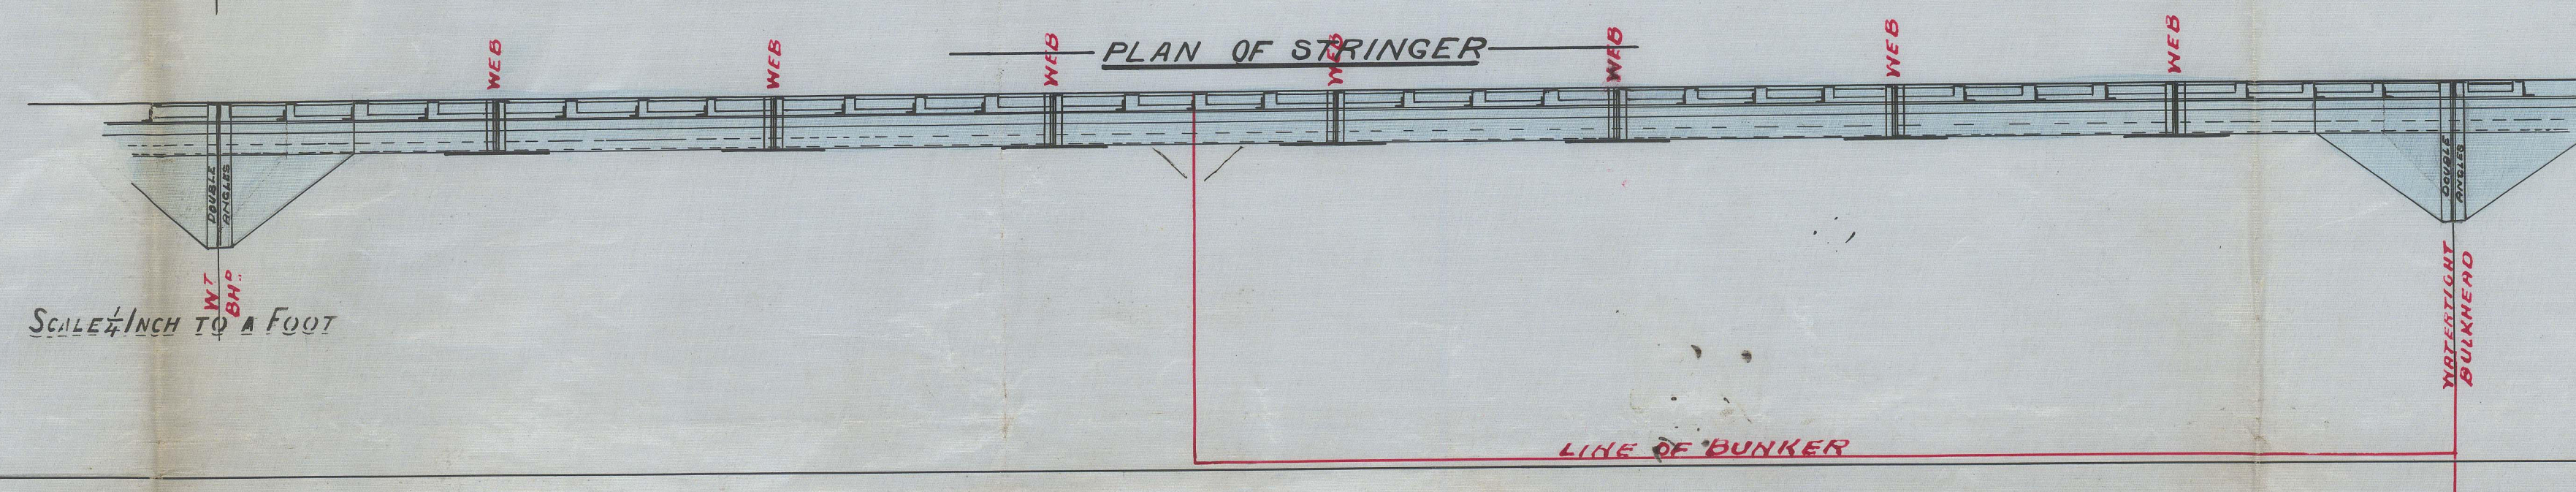

# **WEB FRAME PLAN** **S-S NO 369**

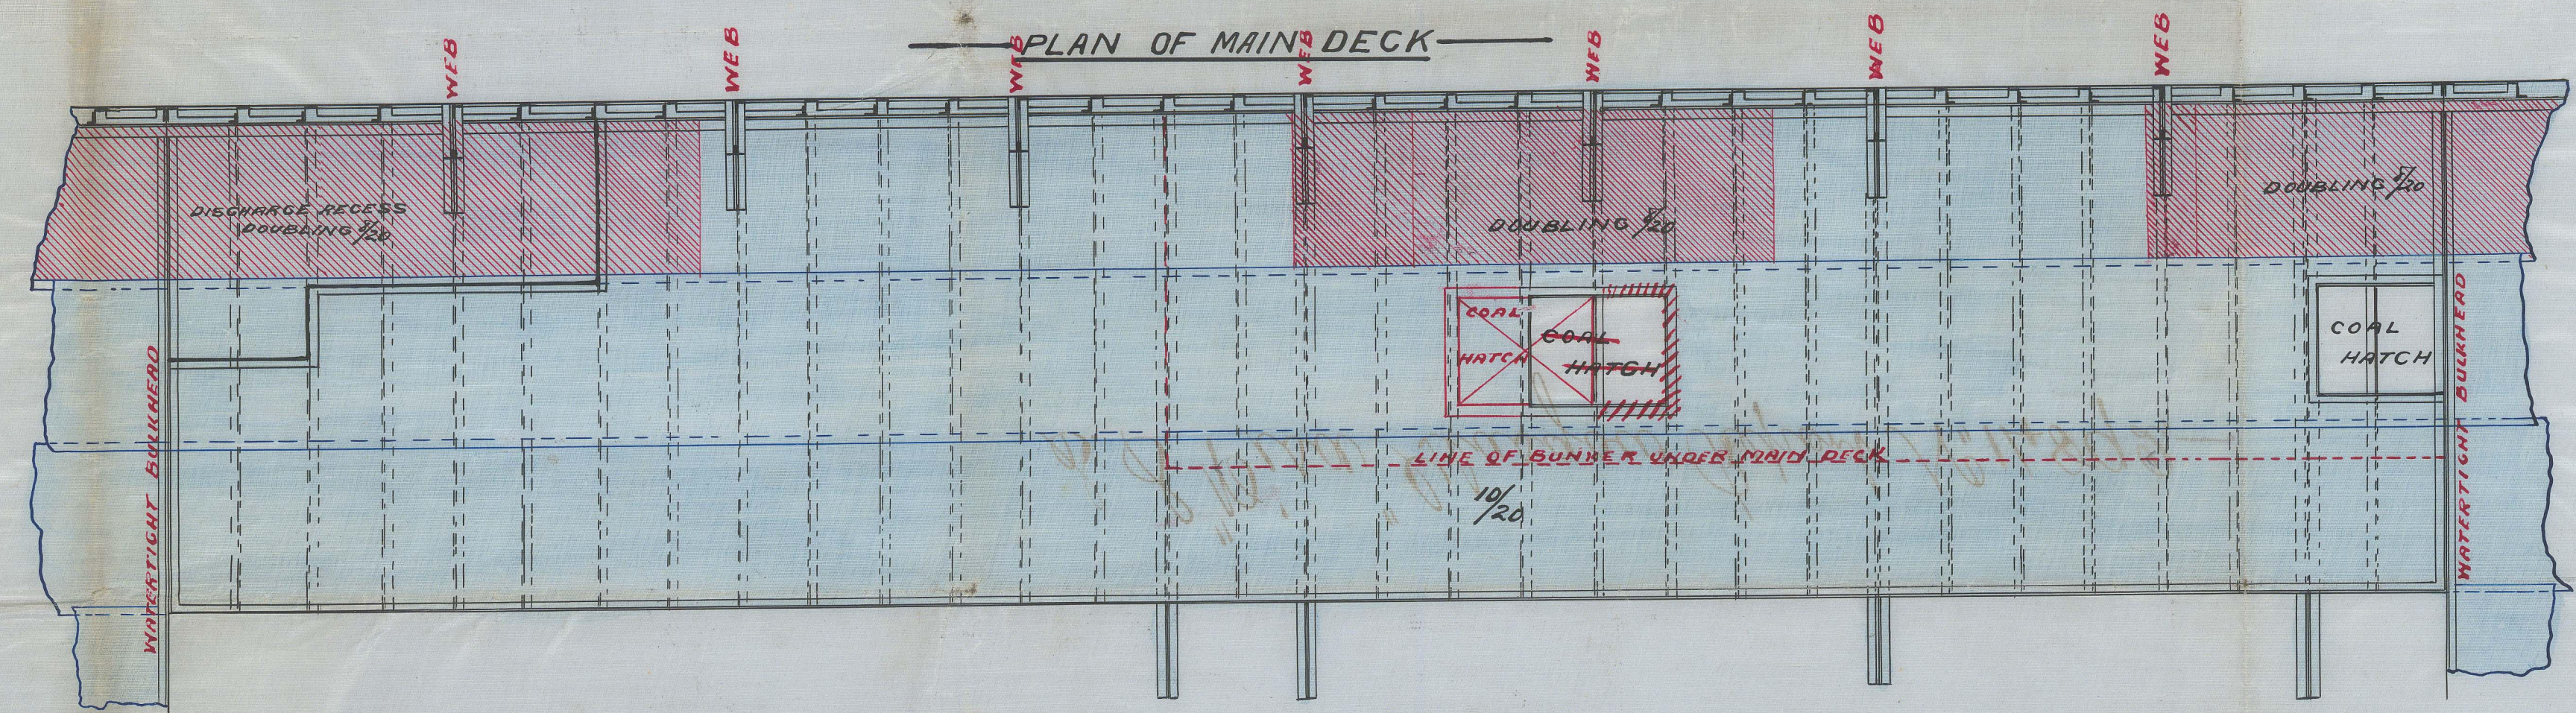

SCALE 1/4 INCH TO A FOOT

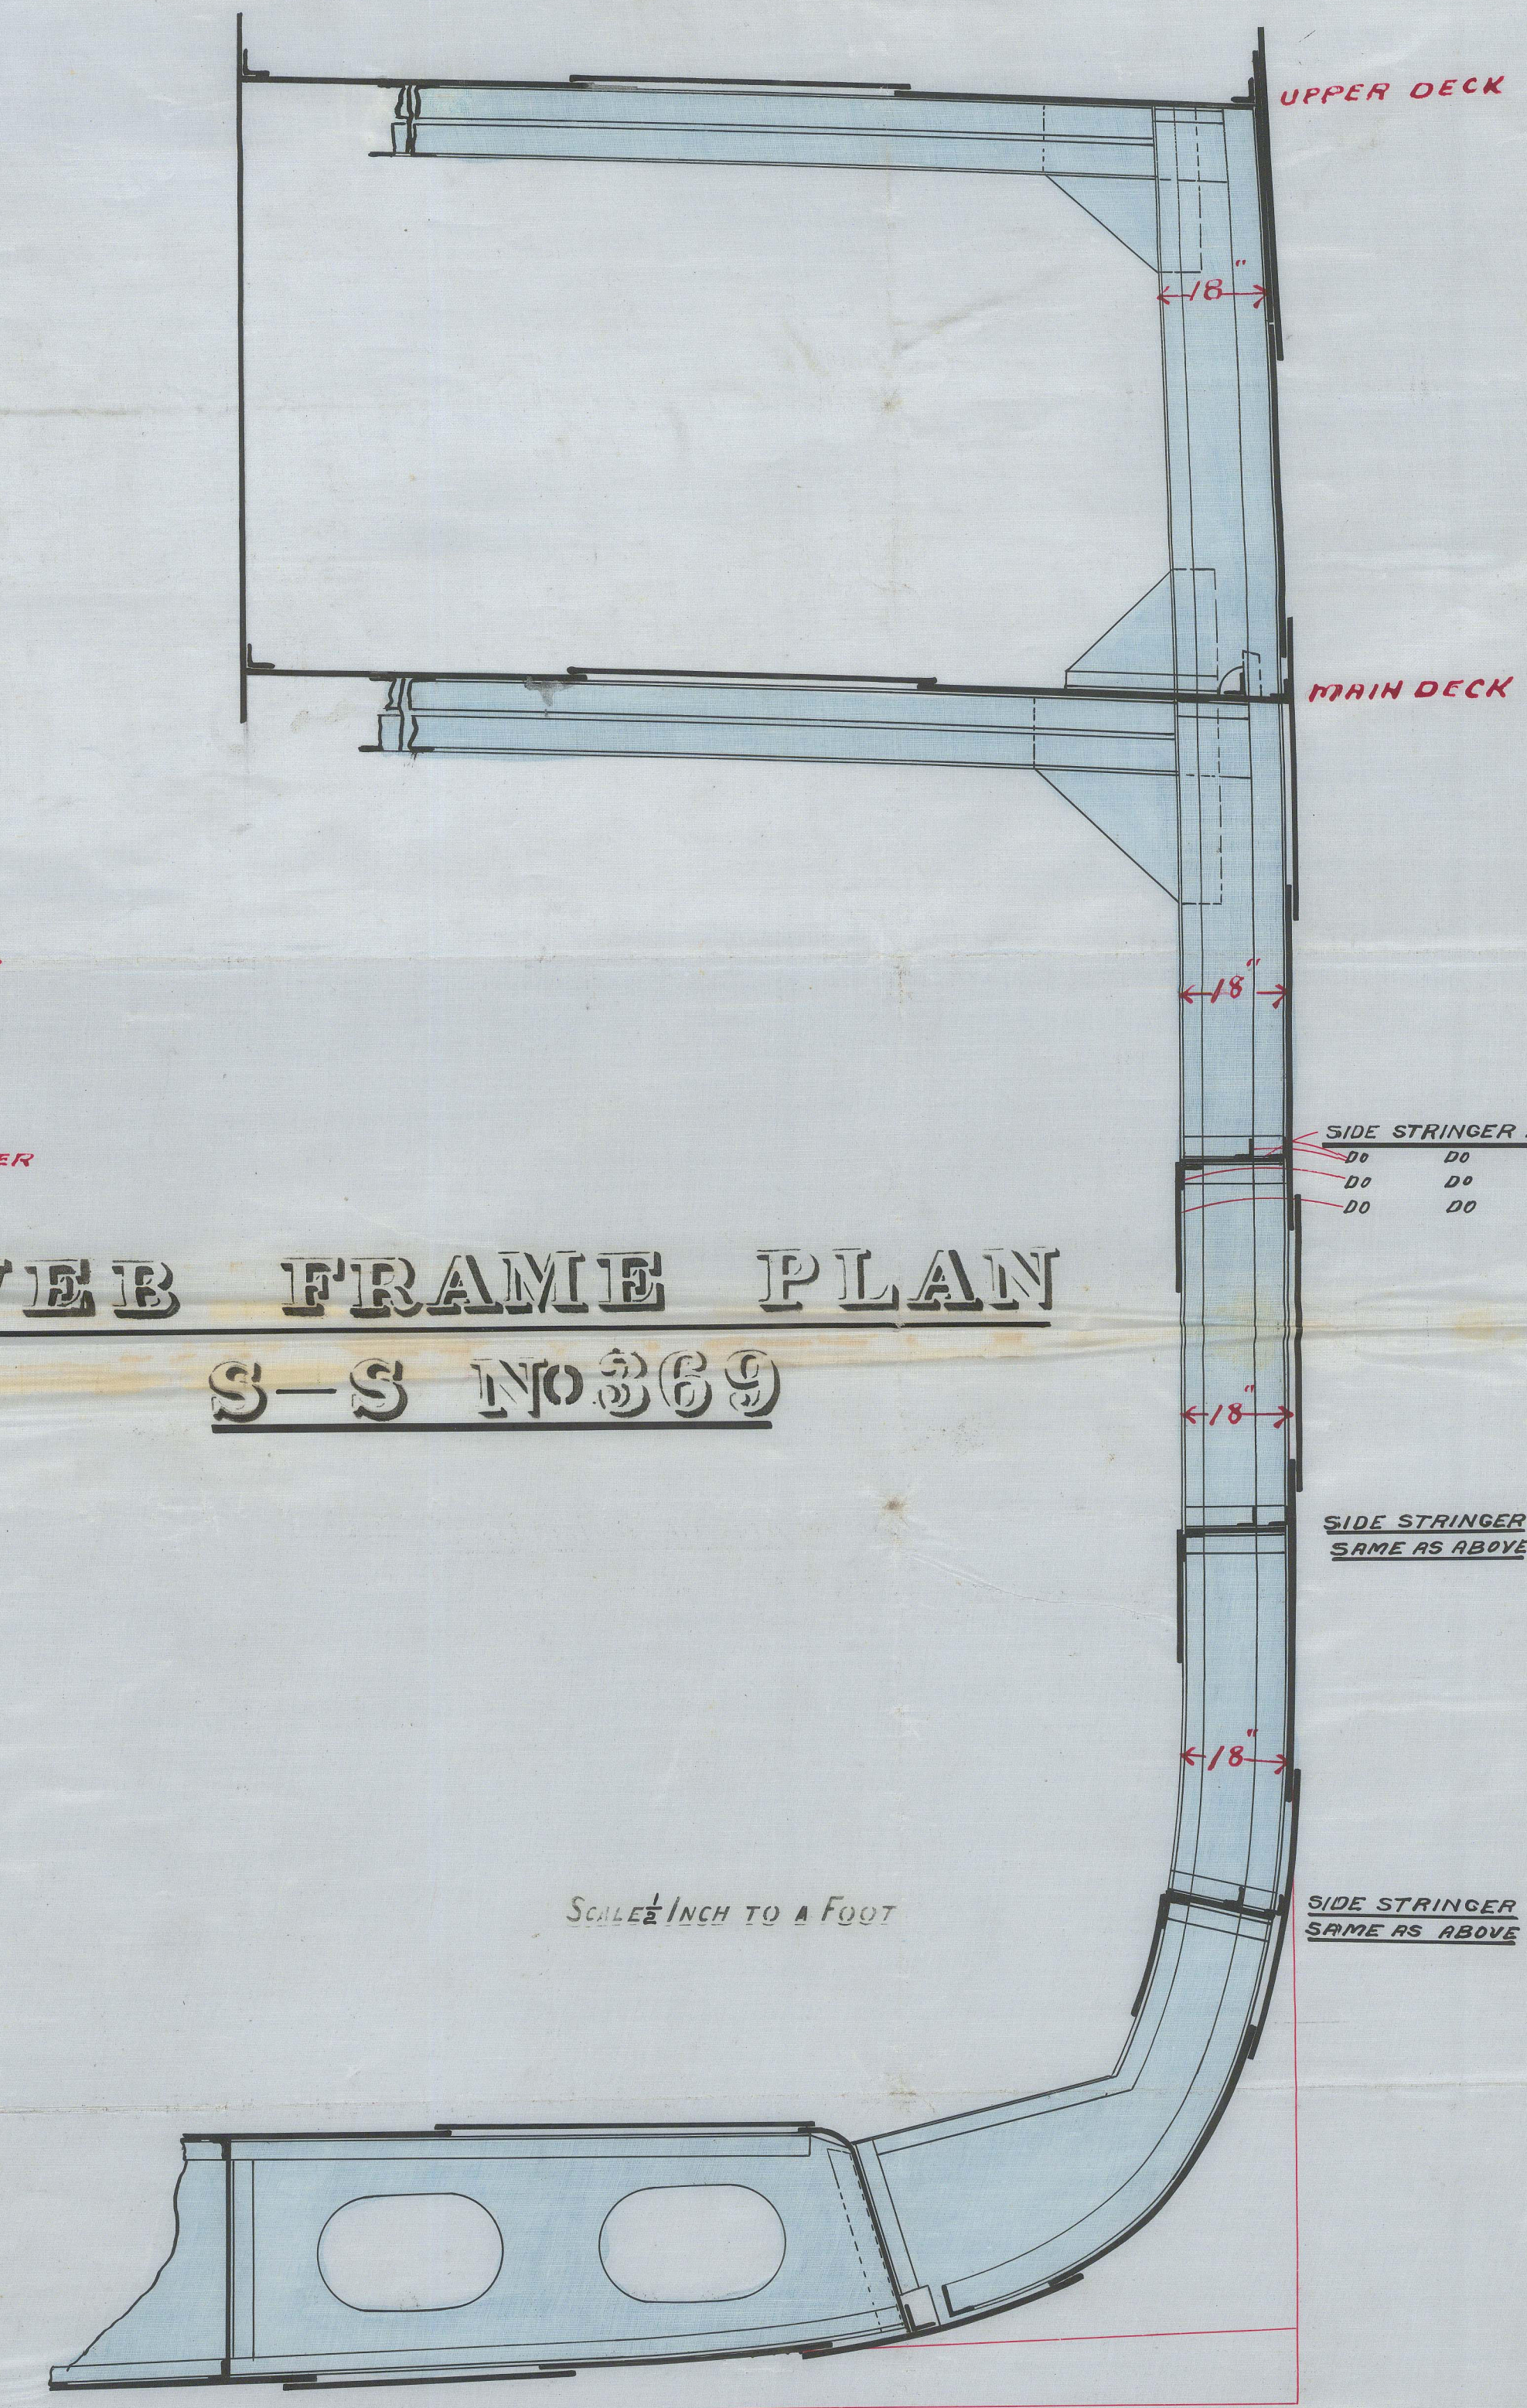

SIDE STRINGER PLATE 9/20 TO 8/20  
DO DO DO ANGLES 4x3 1/2 x 7/20 TO 9/20  
DO DO DO FACE ANGLE 6 1/2 x 4 1/2 x 7/20 TO 1 1/2  
DO DO DO DIAMOND PLATE 36 x 21 x 1 1/2 TO 7/20

SIDE STRINGER SAME AS ABOVE

SIDE STRINGER SAME AS ABOVE

SCALE 1/4 INCH TO A FOOT

15/5/96

DRAWING NO 7749  
12/5/96  
WMA

Alex<sup>r</sup> Stephen & Sons.  
SHIPBUILDERS & ENGINEERS  
GLASGOW  
J.W.  
14/5/96

GL5259-0030



TOO F 1001


96/5/51

LINE OF STAKES

10/51

LINE OF STAKES

S. S. "Pisa" Glasgow Report N<sup>o</sup> 14892.-

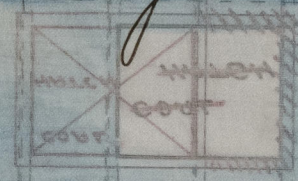

GLS259-0030

LINE OF MAIN DECK



© 2021

Lloyd's Register  
Foundation

