


UPPER DECK

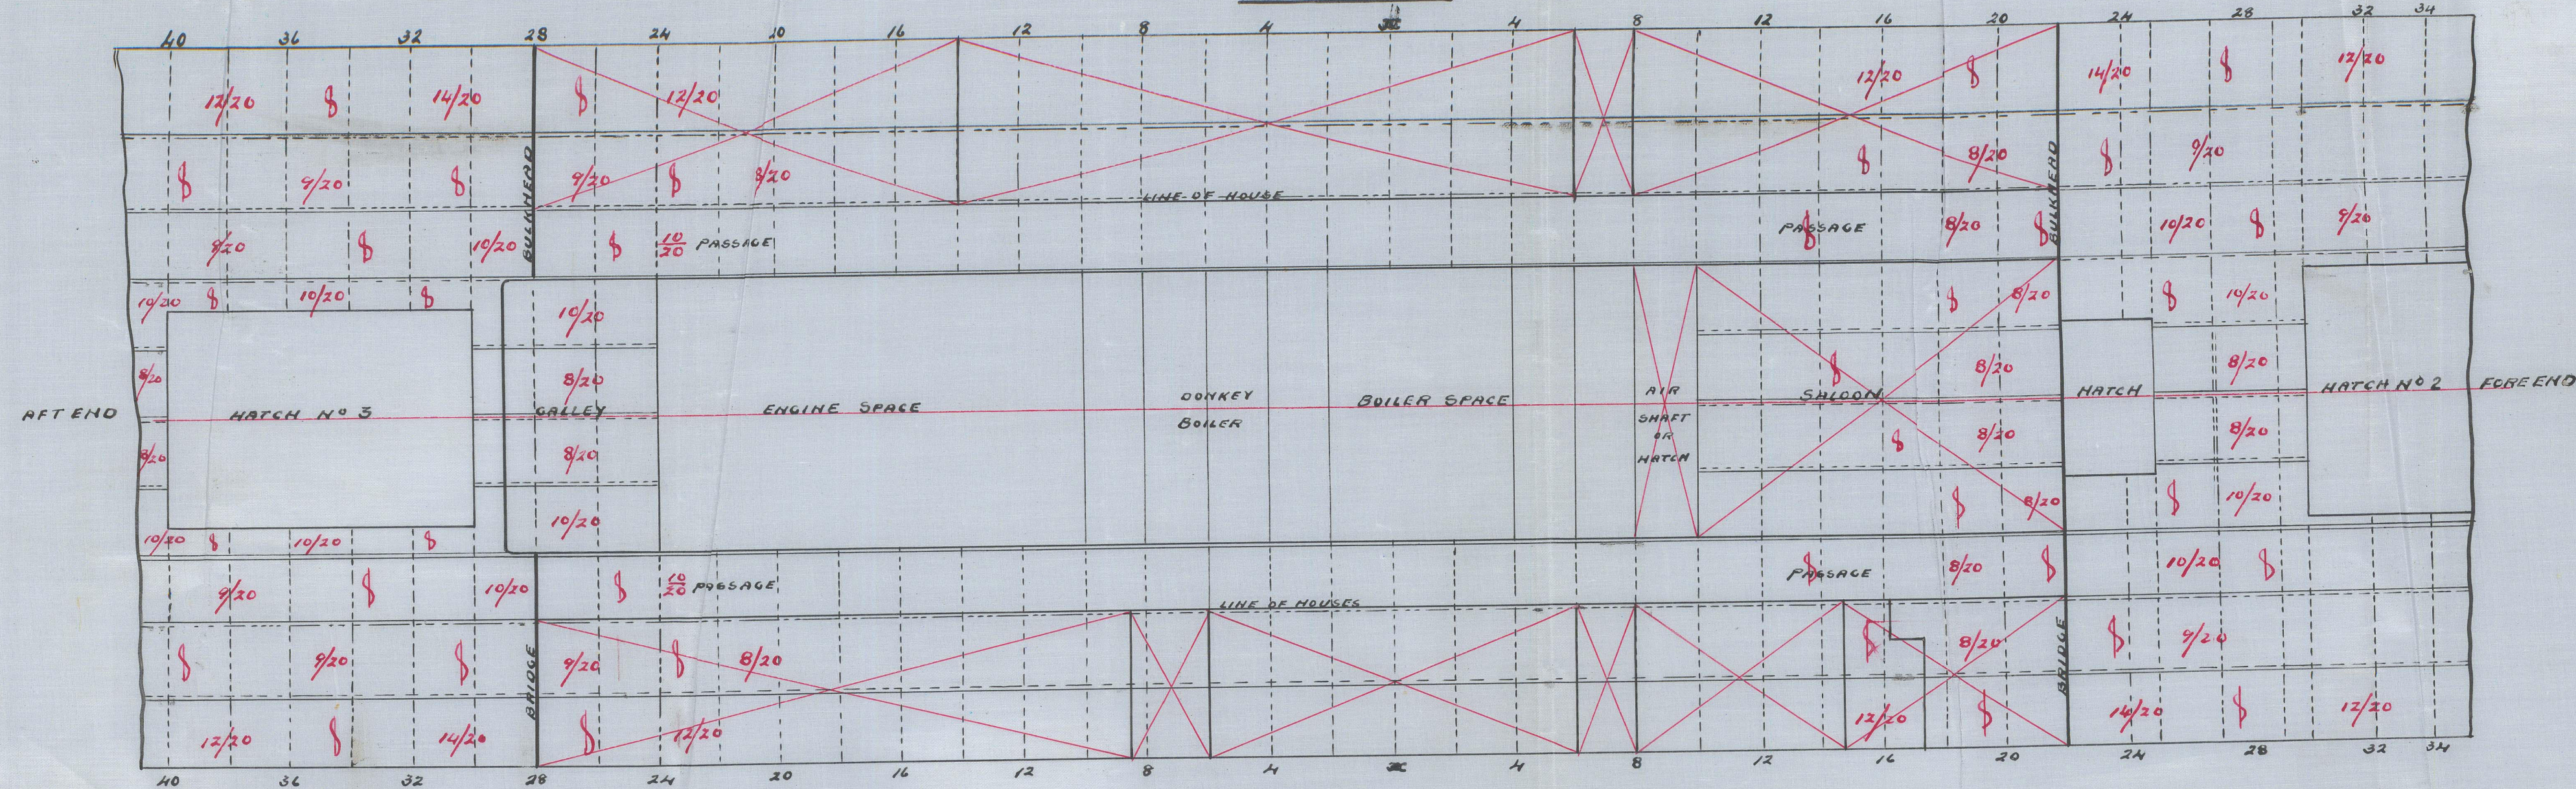

SCALE $\frac{1}{8}$ INCH TO A FOOT

Plan showing increased
thickness of deck at
ends of bridge.
— N^o 339. —

Alex^r Stephen & Sons.
SHIPBUILDERS & ENGINEERS
GLASGOW

DRAWING N^o 8069
3/12/96
W.H.B.