

Lloyd's Register of British and Foreign Shipping.

(Report on Vessel No. 14995 Port Glasgow)
"Indra"

No. 5270 SHIP FORGINGS ~~OR CASTINGS~~.

I have to report that the undermentioned ~~Iron or Steel Forgings or Castings~~,
manufactured by Messrs Charles Camell & Co.
of Glasgow, for the Vessel No. 235, being built
by Messrs Charles Camell & Co. of Glasgow.
have been inspected by me as set forth below, and found to be, so far as can be seen,
Sound.

The words FORGINGS or CASTINGS, IRON or STEEL, should be struck out as may be required.


Mark on Forgings.

Lloyd's
No. 5270
E.C.

Frank Cook
Glasgow 21/12/96

	STERN FRAME.	RUDDER FRAME.	STEM.
Material* ...	/	<u>Scrap Steel</u>	<u>Scrap Steel.</u>
How made ...		<u>Forged</u>	<u>Forged.</u>
Dimensions ...		<u>10 1/2 x 9 1/2 x 7"</u>	<u>12 x 3 1/8"</u>
Progress on Inspection		<u>Forged & smithed.</u>	<u>Forged & smithed</u>
Date when Inspected		<u>19/9/96 to 18/12/96.</u>	<u>1/6/96 to 14/9/96</u>

SKETCHES OF FRAMES SHOWING POSITION AND DESCRIPTION OF WELDS OF FORGINGS, OR PARTICULARS OF TESTS APPLIED TO CASTINGS.

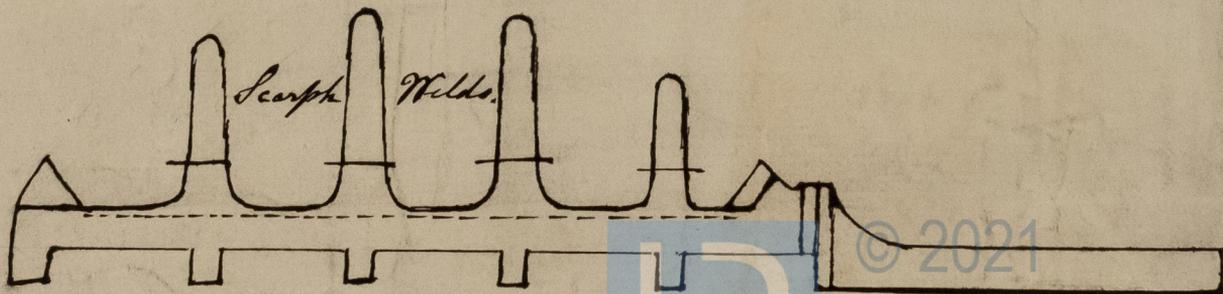

Fee (if any chargeable) £ : :

To be paid at



Lloyd's Register
Foundation