

4. 8. d

Ed. & Andrew Glasgow Report No. 1499.


# PLAN OF MASTS

S. S. N<sup>o</sup> 235

FORE & AFT RIG-

FORE & MAIN MASTS

*Diameters altered  
by Owners.*

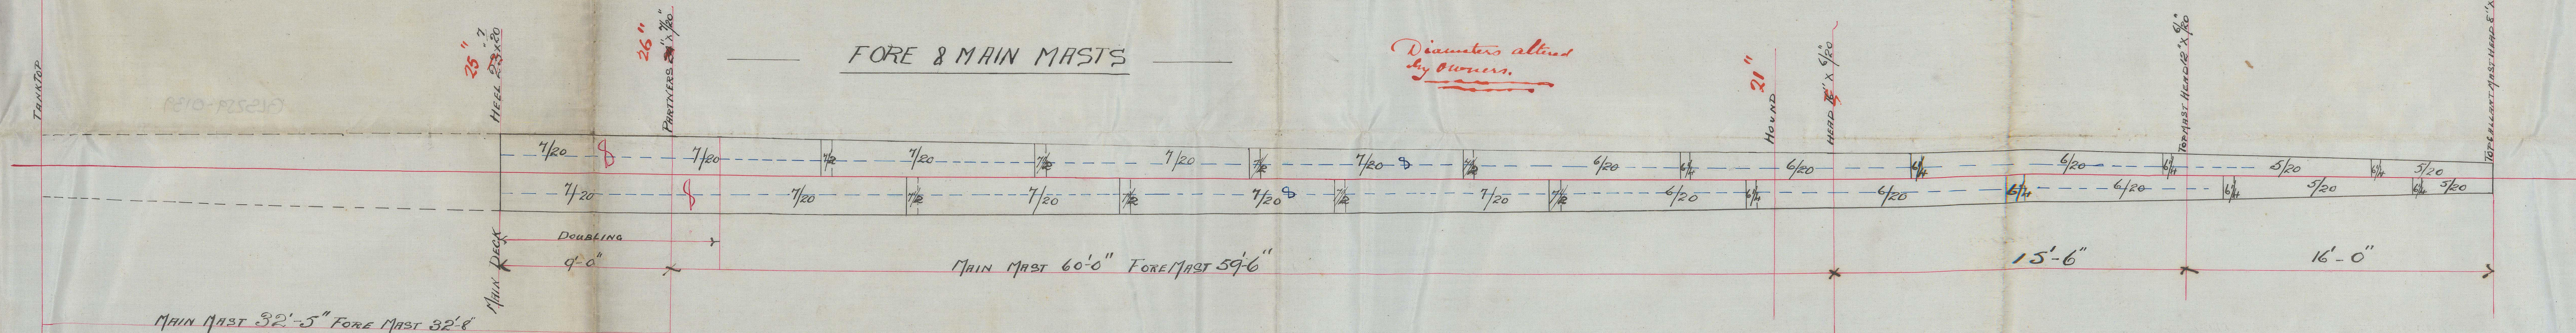

NOTES

FORE AND MAIN MASTS BUILT IN TWO PLATES TO THE ROUND  
LANDINGS SINGLE RIVETED  
BUTTS OVERLAPPED & TREBLE RIVETED  
MAST DOUBLED AT HEEL AND AT WEDGING

TWO ANGLES FITTED FROM HEEL  
TO TOP MAST HEAD  $3'' \times 2\frac{1}{2}'' \times \frac{1}{16}''$  3" FLANGE VERTICAL

O. CONNELL & CO.  
Shipbuilders,  
GLASGOW.

31/7/26.


T. W.  
 55 1/8 96

J. A. L.  
4/8/96

GLS259-0139

© 2021  
Lloyd's Register  
Foundation



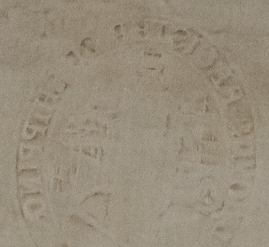

Sp 28. 7

S. S. "Indra" Glasgow Report No. 14995.

HEF 22X50  
52

GLS259-0139



© 2021

Lloyd's Register  
Foundation

