


17.7.96

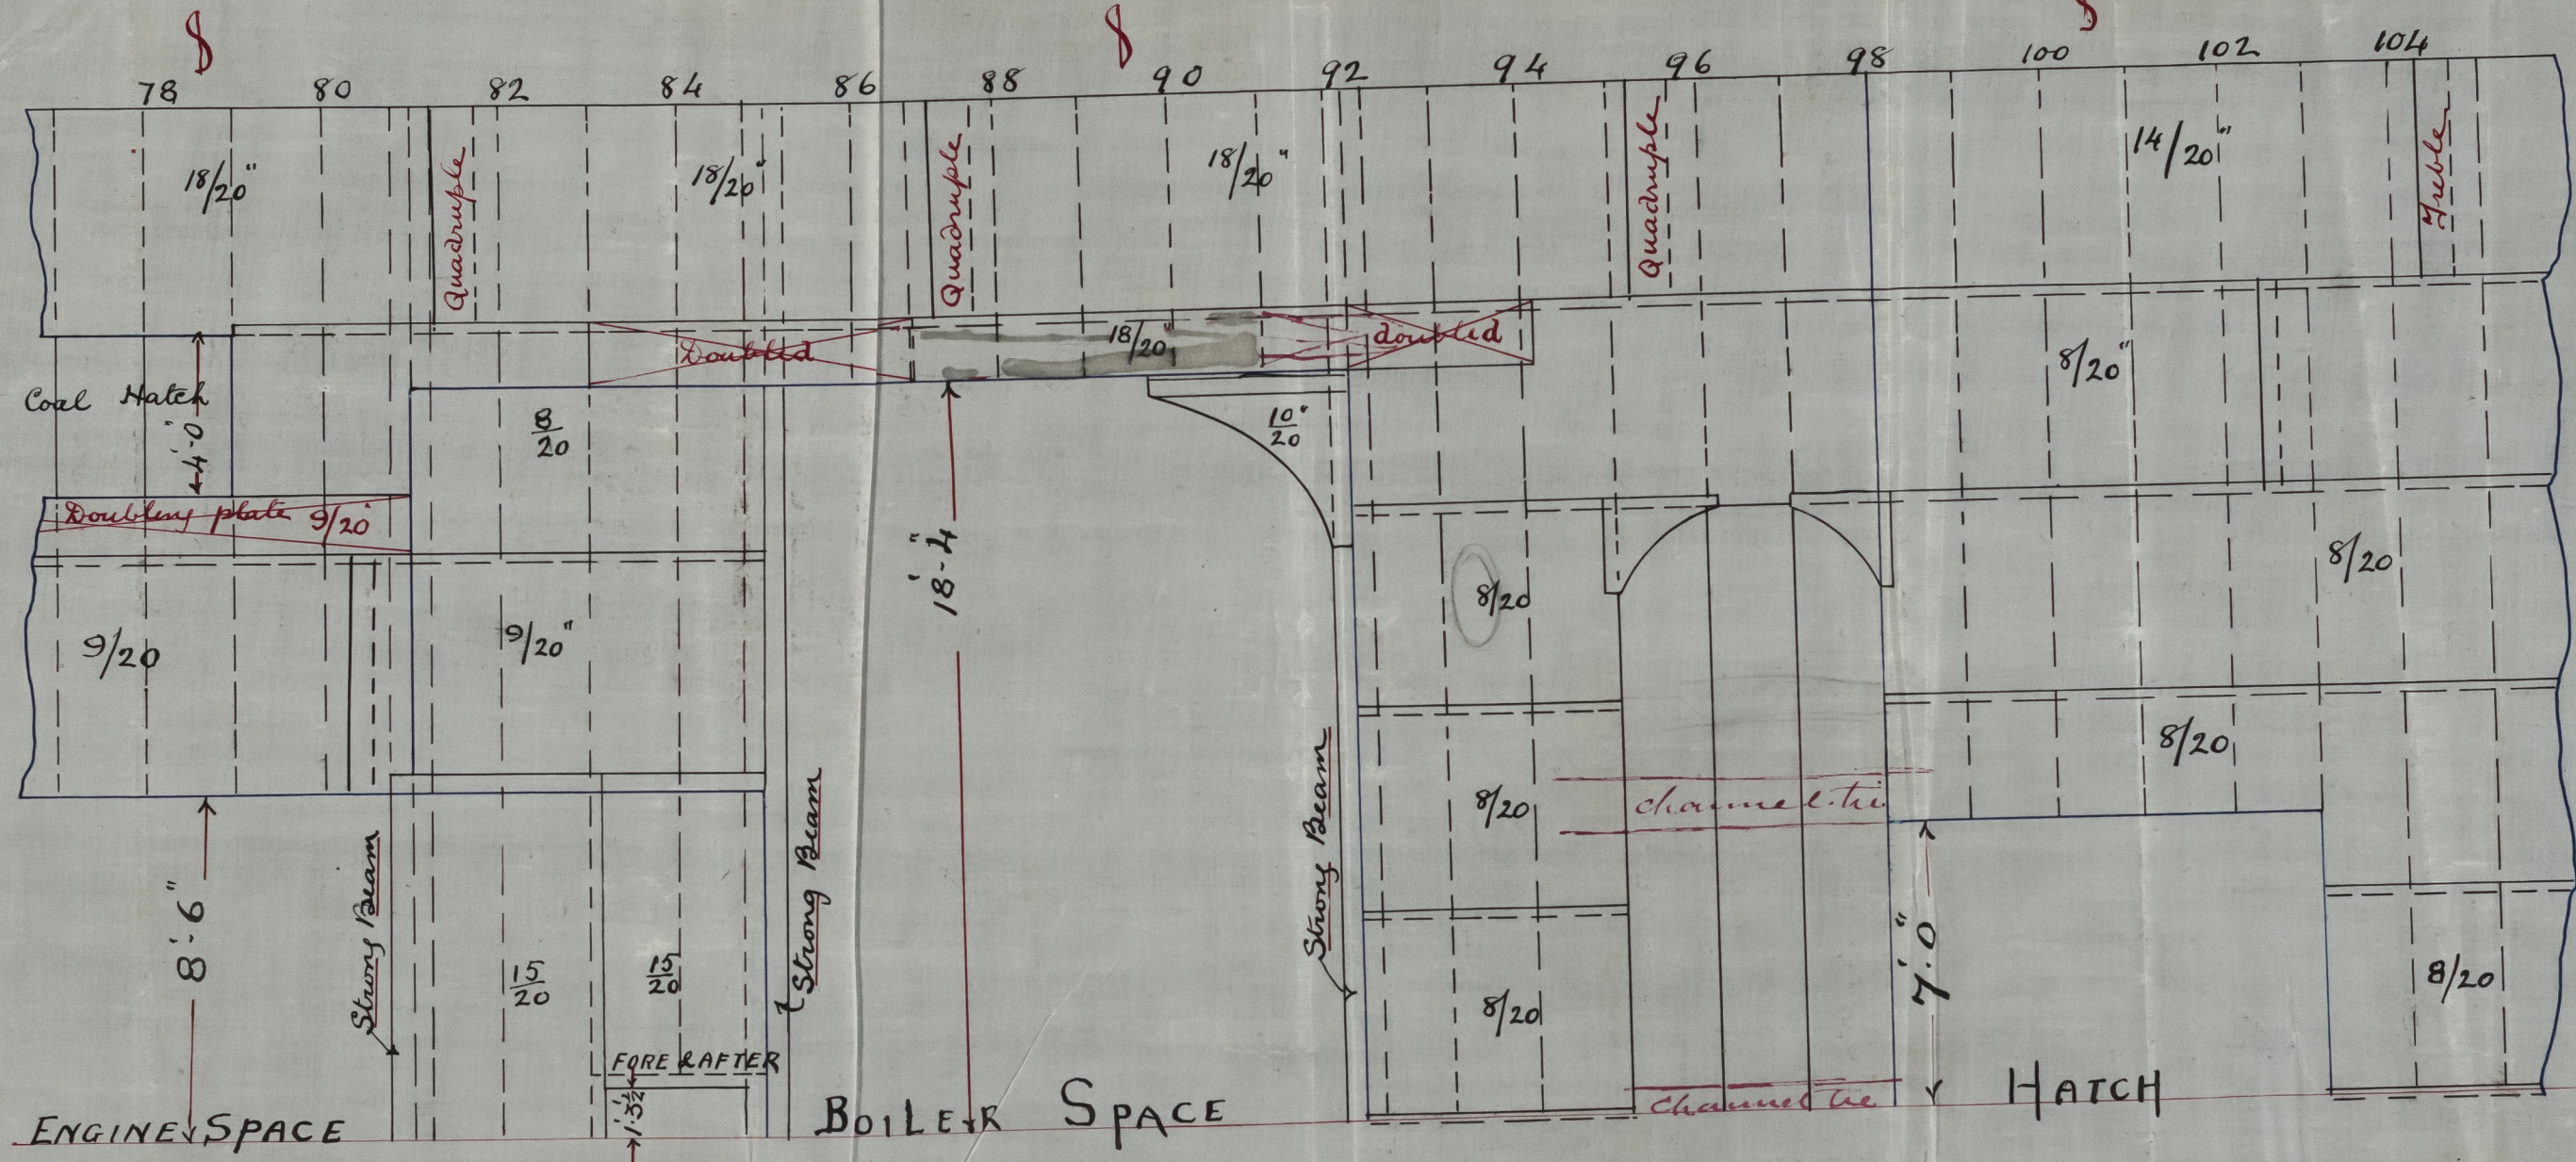

— S. S. No 235 —  
 — Part plan of Main Deck —  
 — Scale 1/4" = 1 Foot —

G. CONNELL & CO.  
 Shipbuilders,  
 GLASGOW  
 15/7/96.  
 J.H.L.

J.H.L.  
 7/7/96

© 2021  
 Lloyd's Register  
 Foundation  
 GLS259-0143



