

17.3.96

Half Diamond Plates  $36 \times 21 \times \frac{1}{2}$   
 Intercostal Stringer Plates  $20 \times \frac{10-9}{20}$   
 Angles  $3\frac{1}{2} \times 3\frac{1}{2} \times \frac{10-9}{20}$   
 Intercostal Face Bar  $6\frac{1}{2} \times 4\frac{1}{2} \times \frac{1}{2}$

Single face angles  
 $6\frac{1}{2} \times 4\frac{1}{2} \times \frac{1}{2}$

Side stringers same as above


Framing in C. & B. Space

Section of Web Frames

S. S. No. 235

Scale  $\frac{1}{2}'' = 1 \text{ Foot}$

For spacing of Webs see Profile

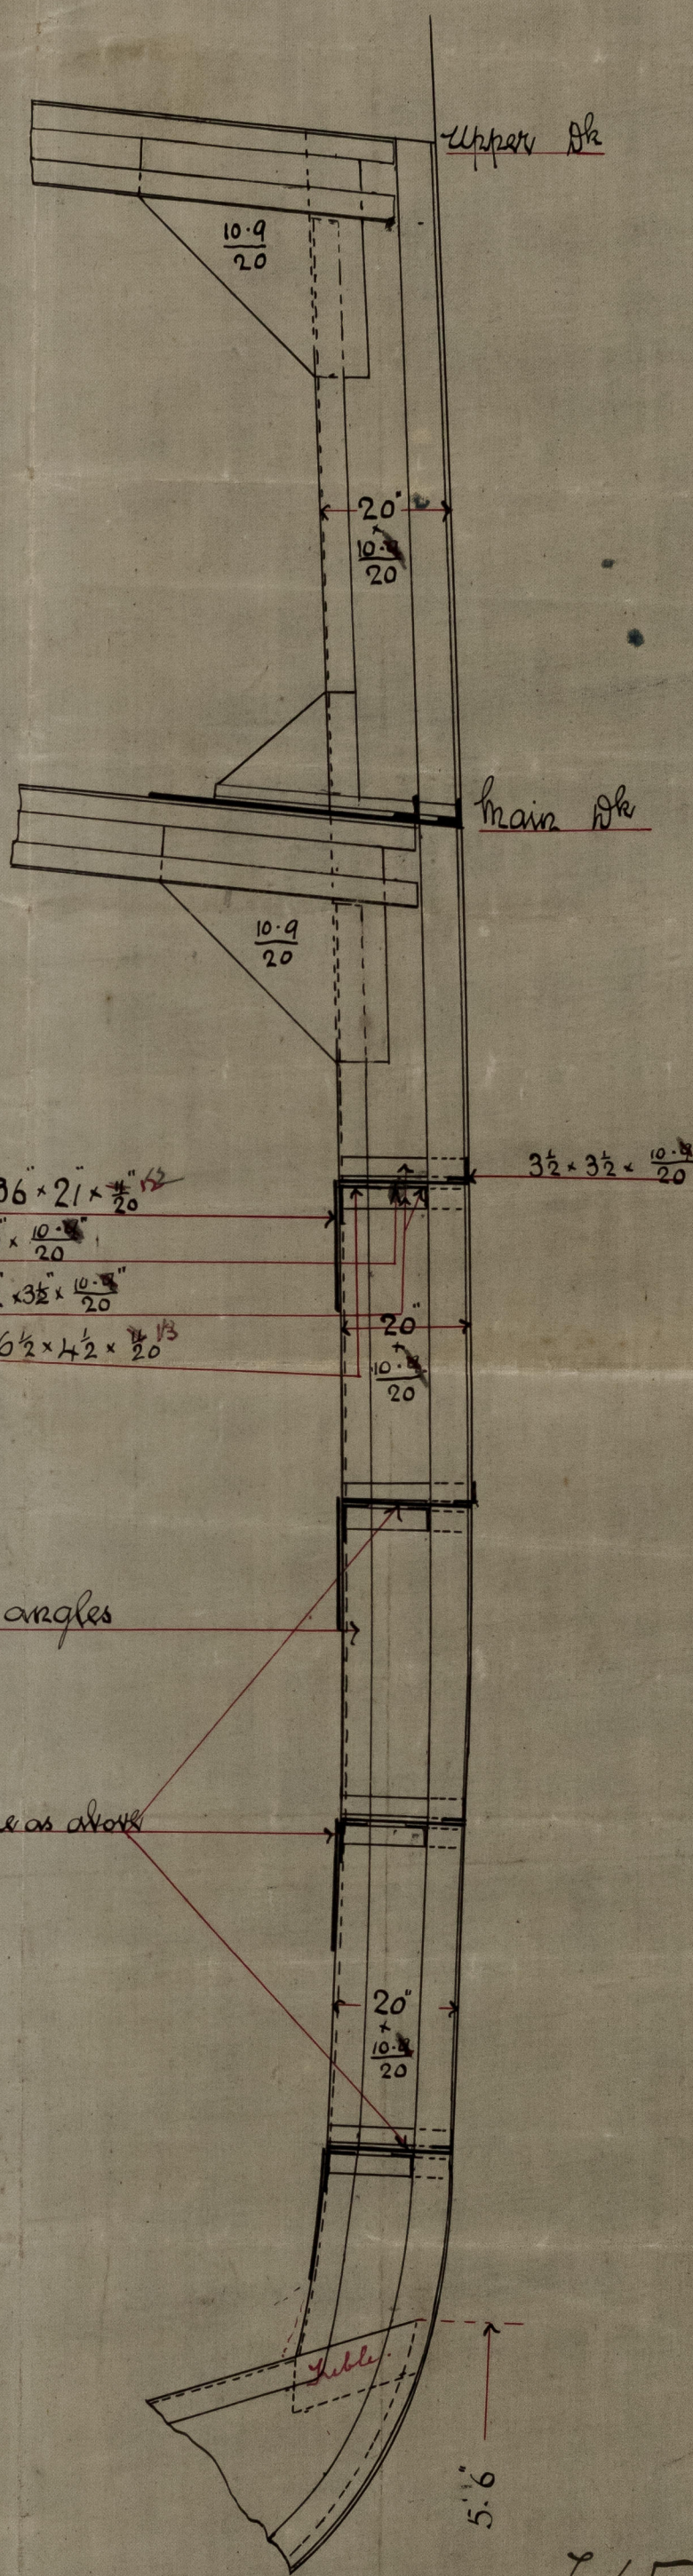


J.W.  
 9/3/96

BASE LINE

O. CONNELL & CO.  
 Shipbuilders,  
 GLASGOW.

J.W.  
 17/3/96

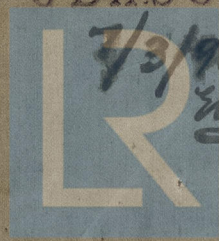

© 2021  
 Lloyd's Register  
 Foundation

GLS259-0145



S. S. "Indra" Glasgow Report 14995



11.3.01

GLS259-0145



© 2021

Lloyd's Register  
Foundation