


17.3.96

— PLAN OF STERN FRAME —
— S. S N° 235 —
— SCALE 1" = ONE FOOT —
— STEEL CASTING —

G. CONNELL & CO.
Shipbuilders,
GLASGOW.
7/3/96
m




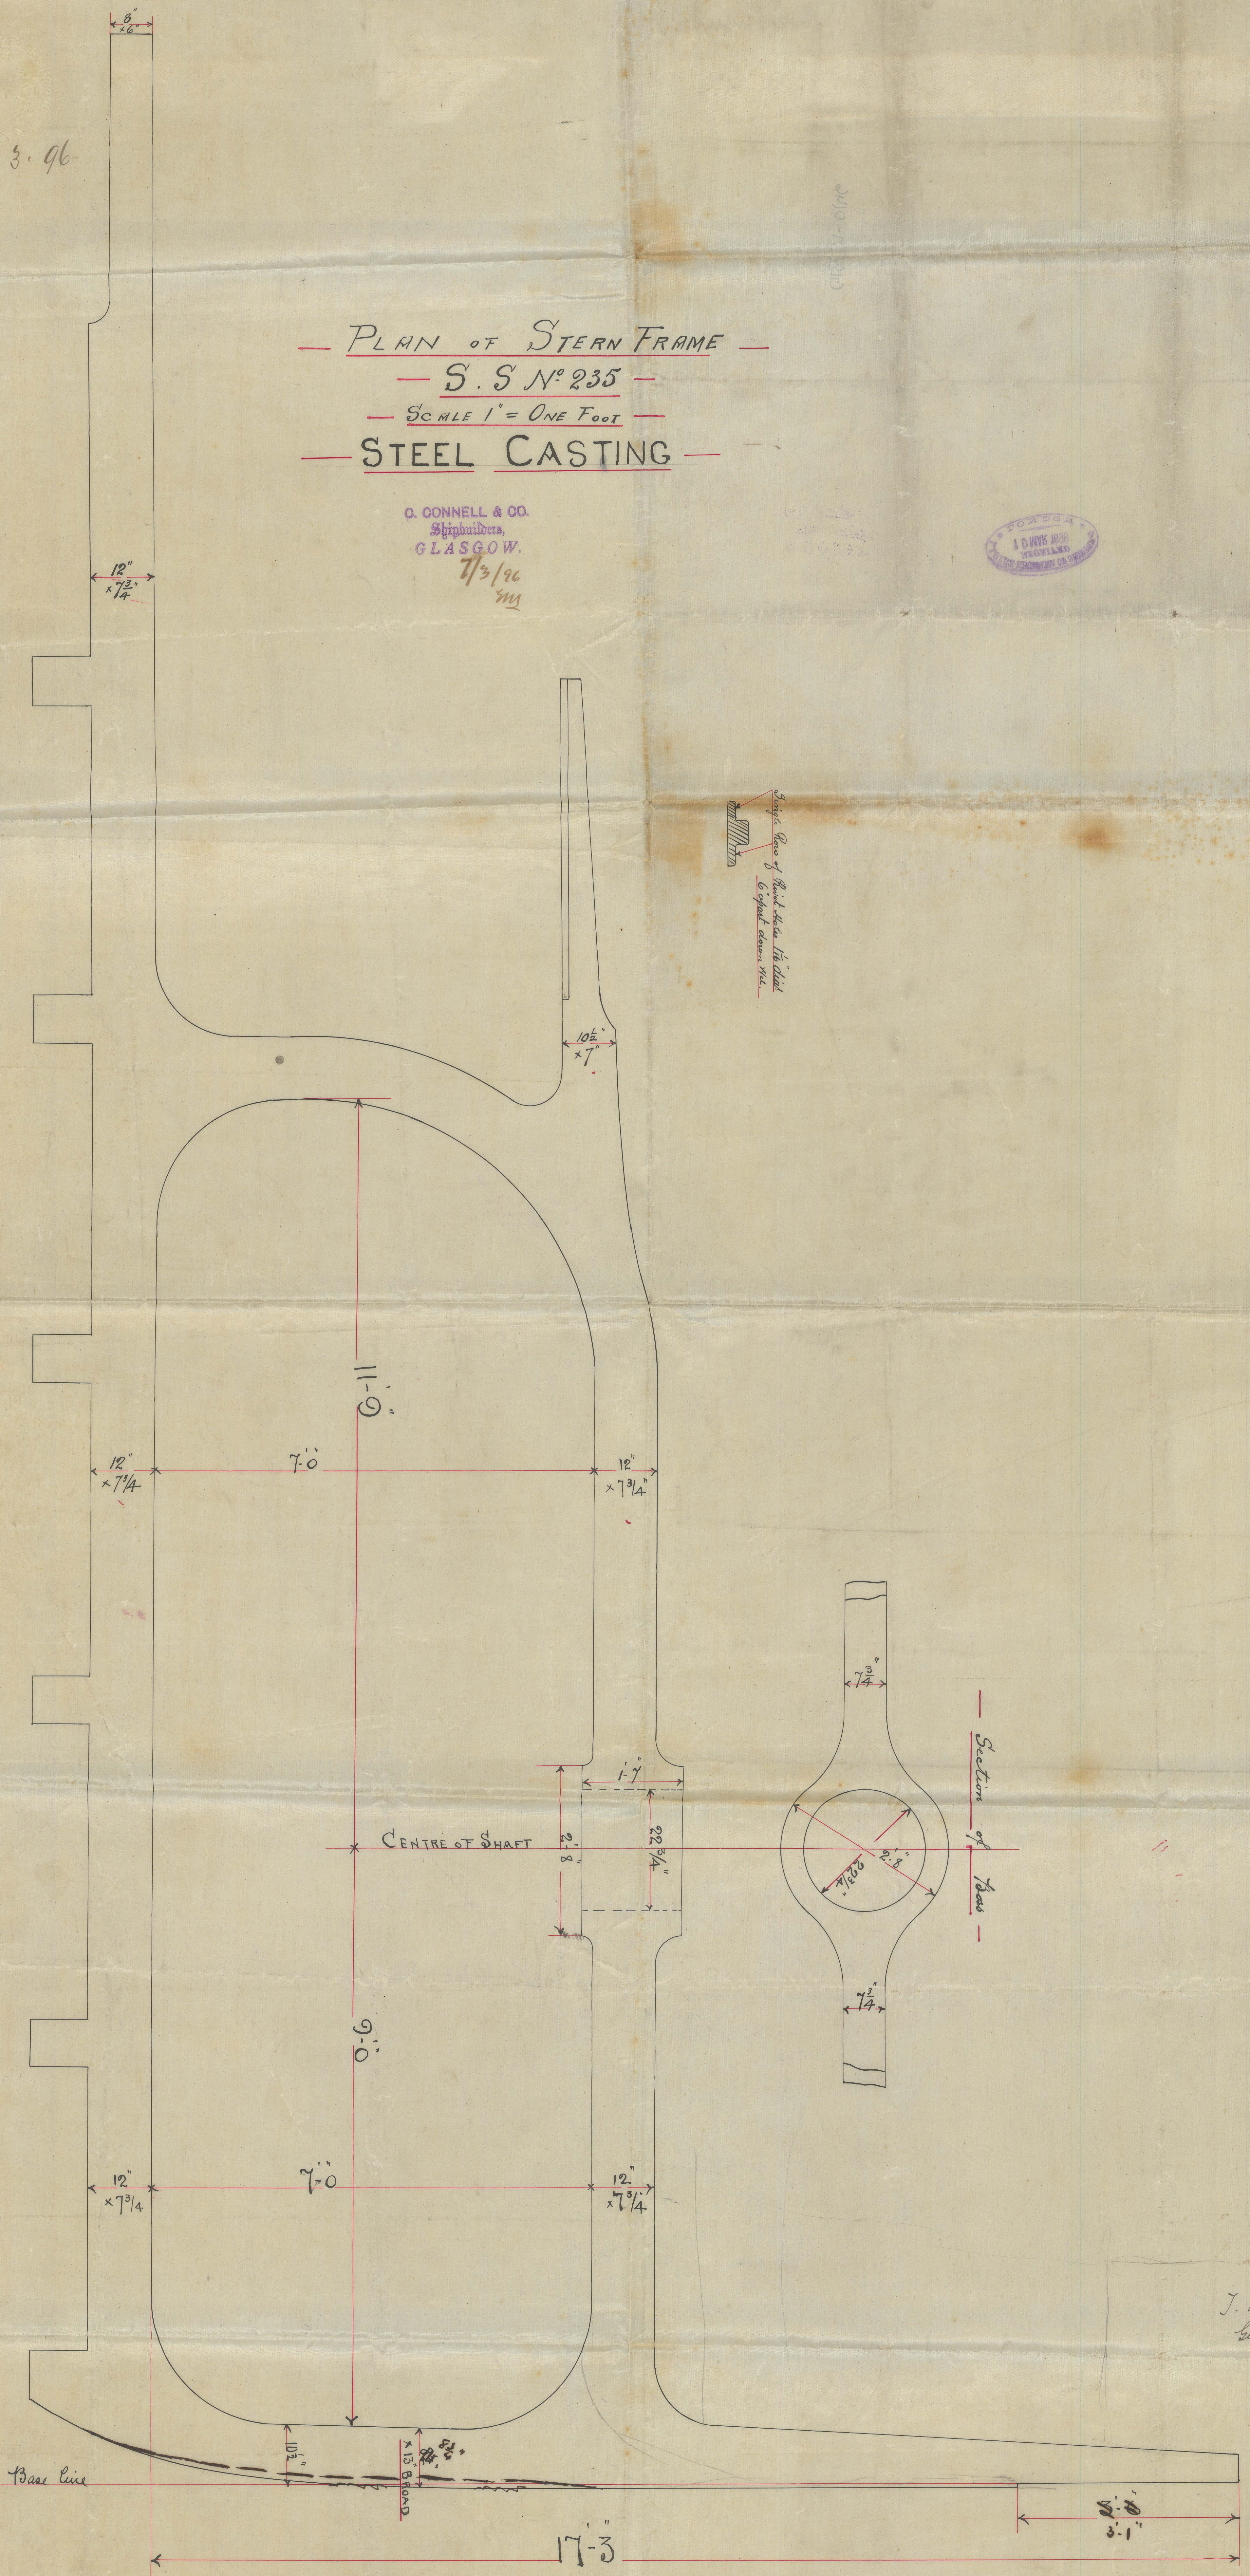


J. W.
6/3/96

J. W.
16/3/96

GLS259-0146

S. S. "Indra" Glasgow Report N^o 14995.-

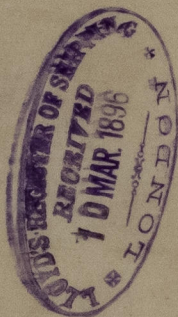

GLS259-0146



© 2021

Lloyd's Register
Foundation