
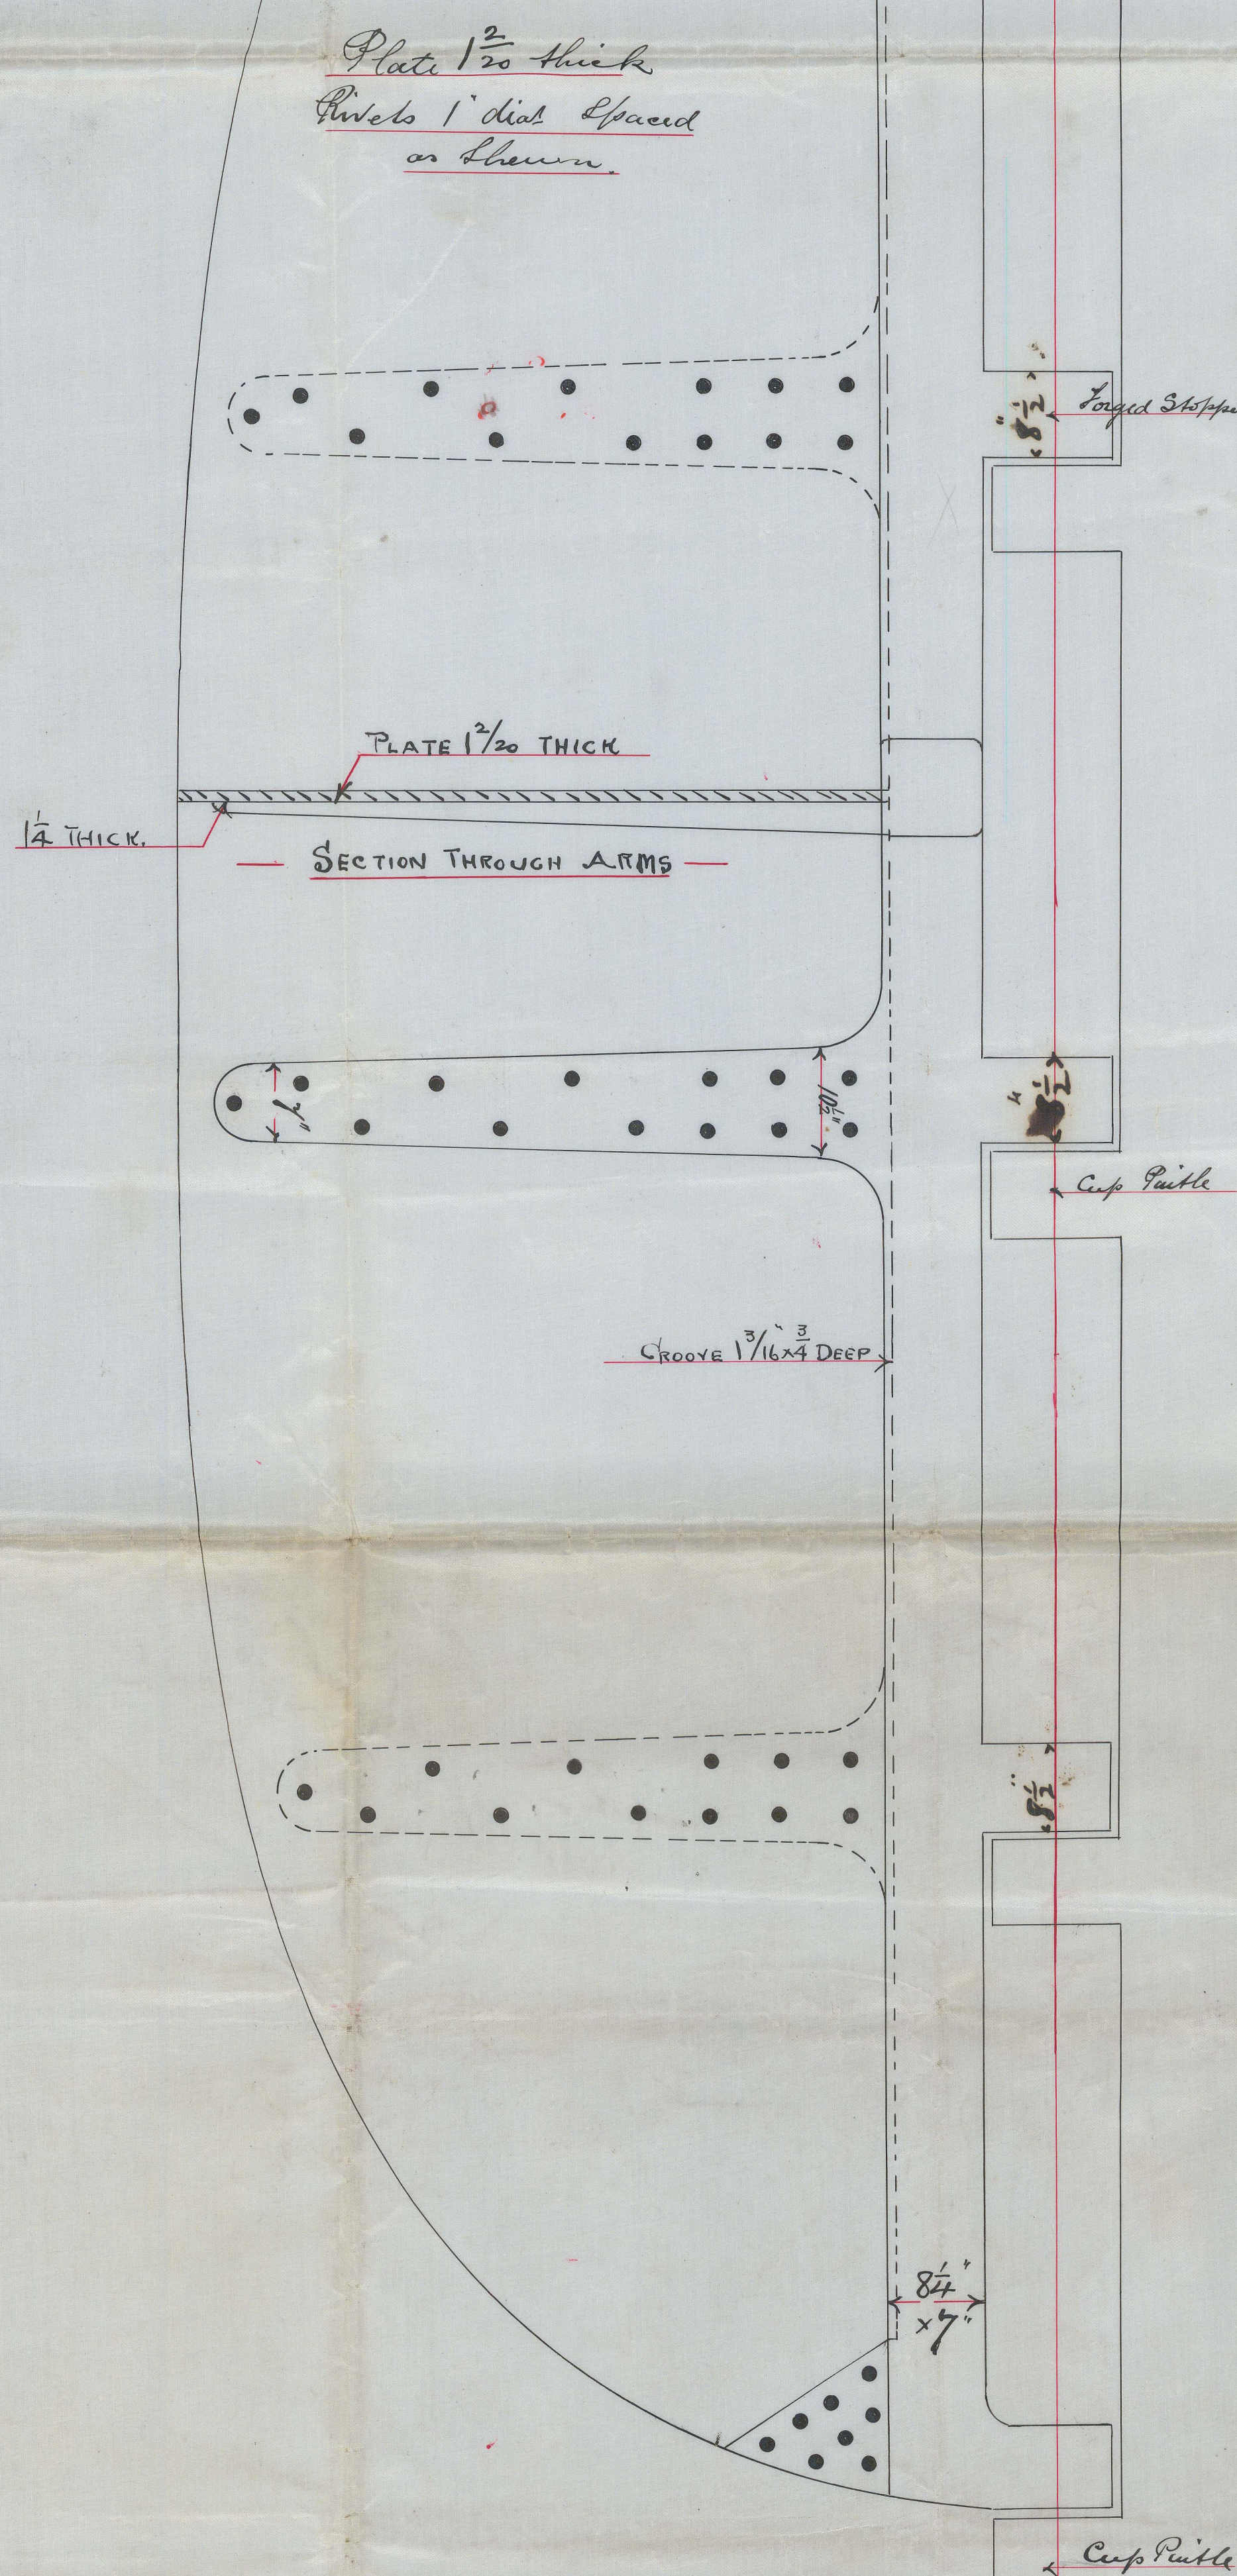


Plan of Rudder
S. S. N^o 235
Scale 1" = a foot.

Speed of Vessel 9 knots.

Place of Land looking down
on top

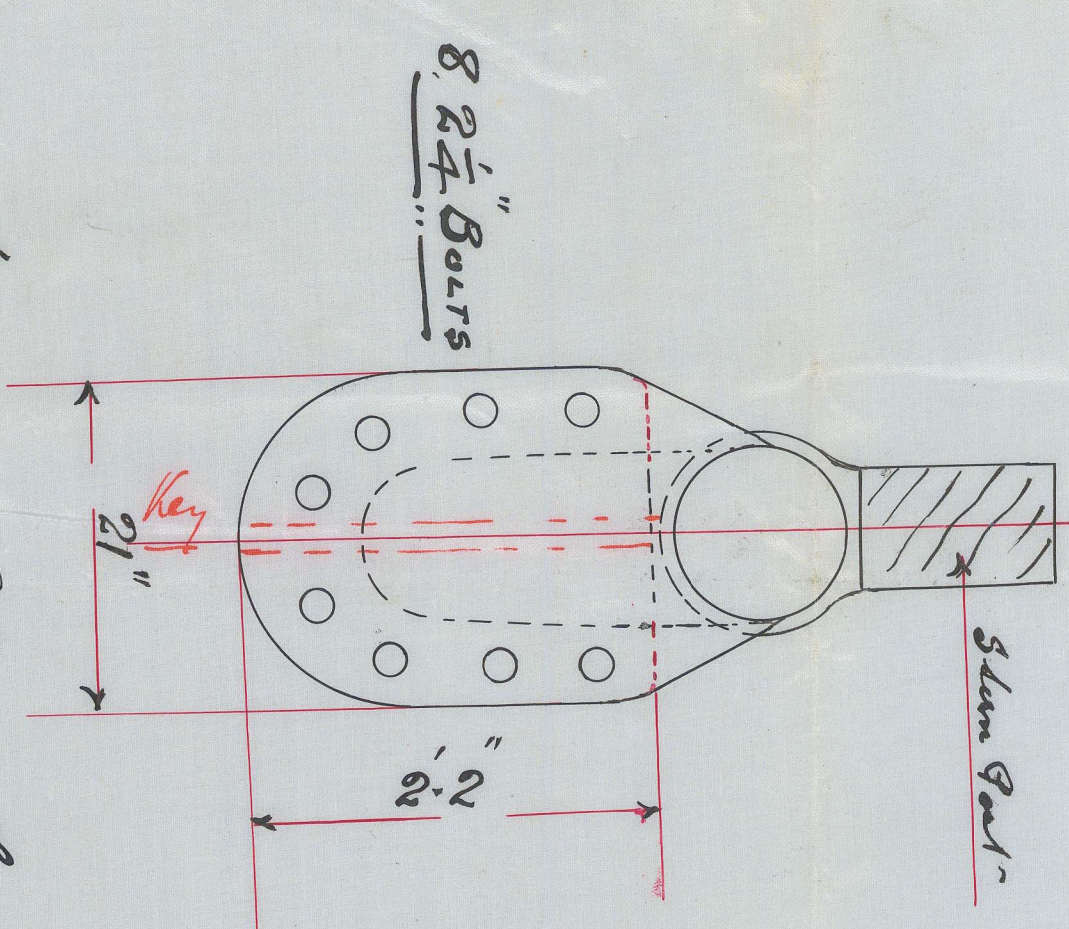


FRONT ELEVATION

J. W.
E. 3/4/96

S. S. "Indra" Glasgow Report N° 14995.

G15259-0148


1/10/96
J. J. J.
in letter.

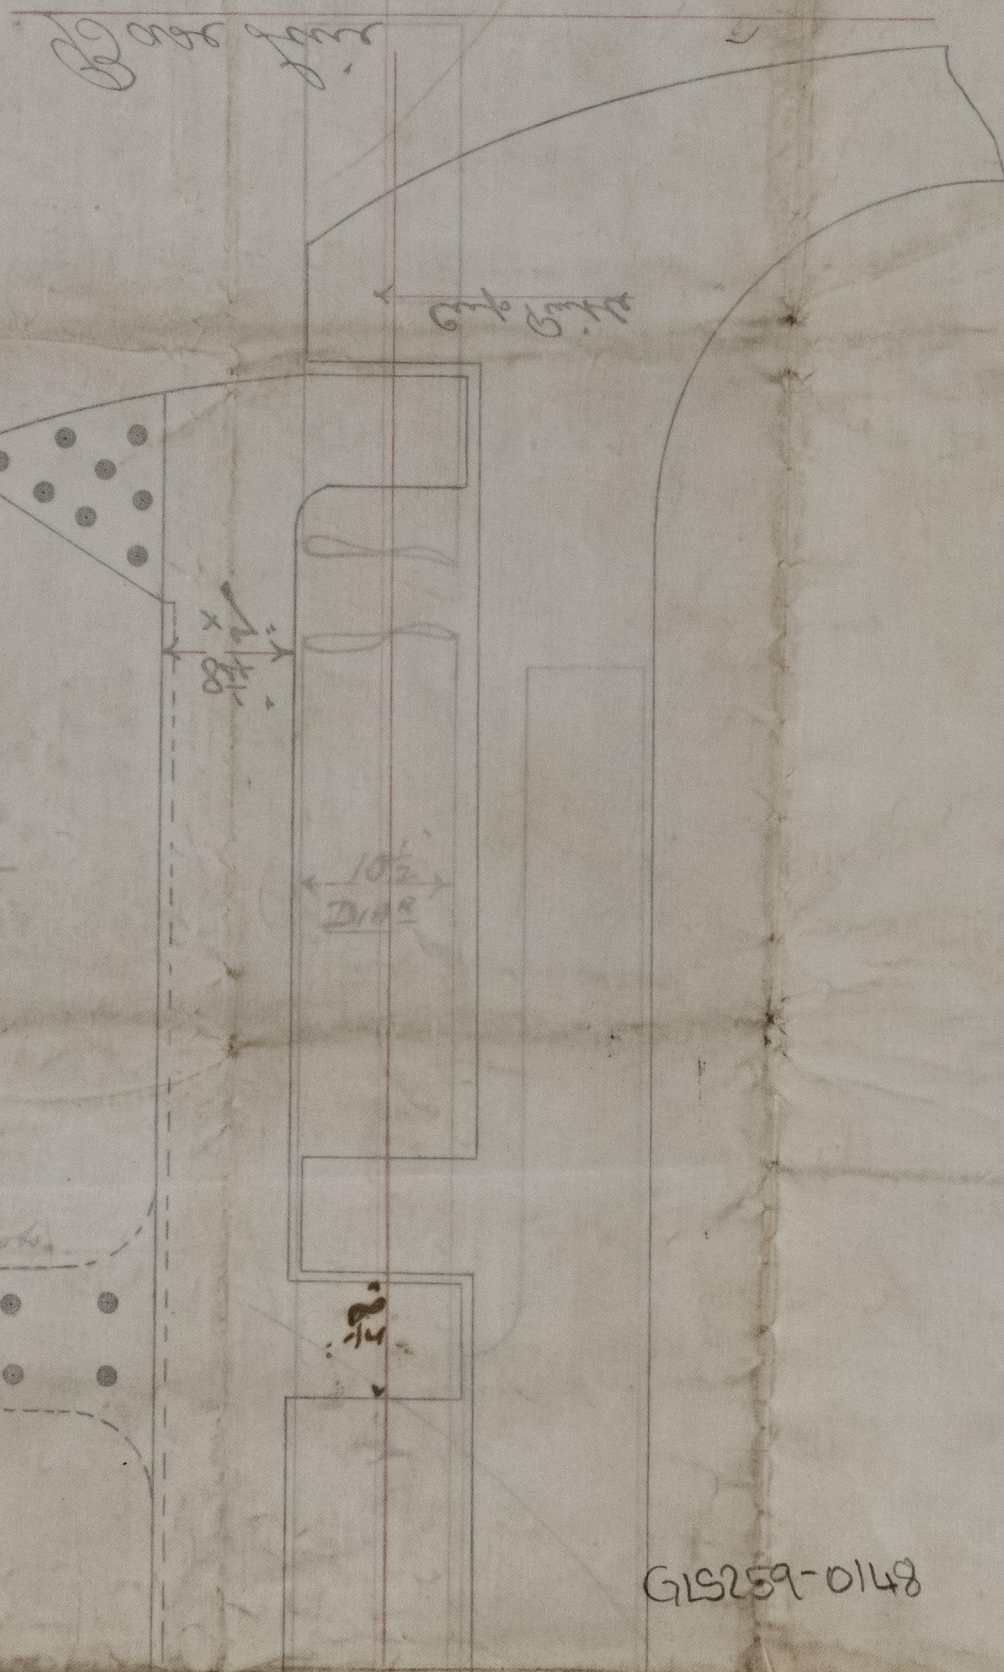

of Rudder —
N° 235 —
1" = a foot —

Speed of Vessel 9 knots.

1/10/96
J. J. J.

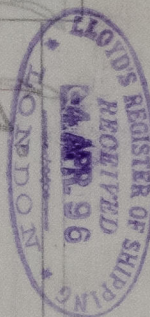

G15259-0148



© 2021

Lloyd's Register
Foundation