


W. H. SHANKS & BELL  
ENGINEERS &  
6 MAR. 96  
SHIPBUILDERS  

7. 3. 96

Arrangement of James & Berne James Nos 81 & 82  
30 in spacing

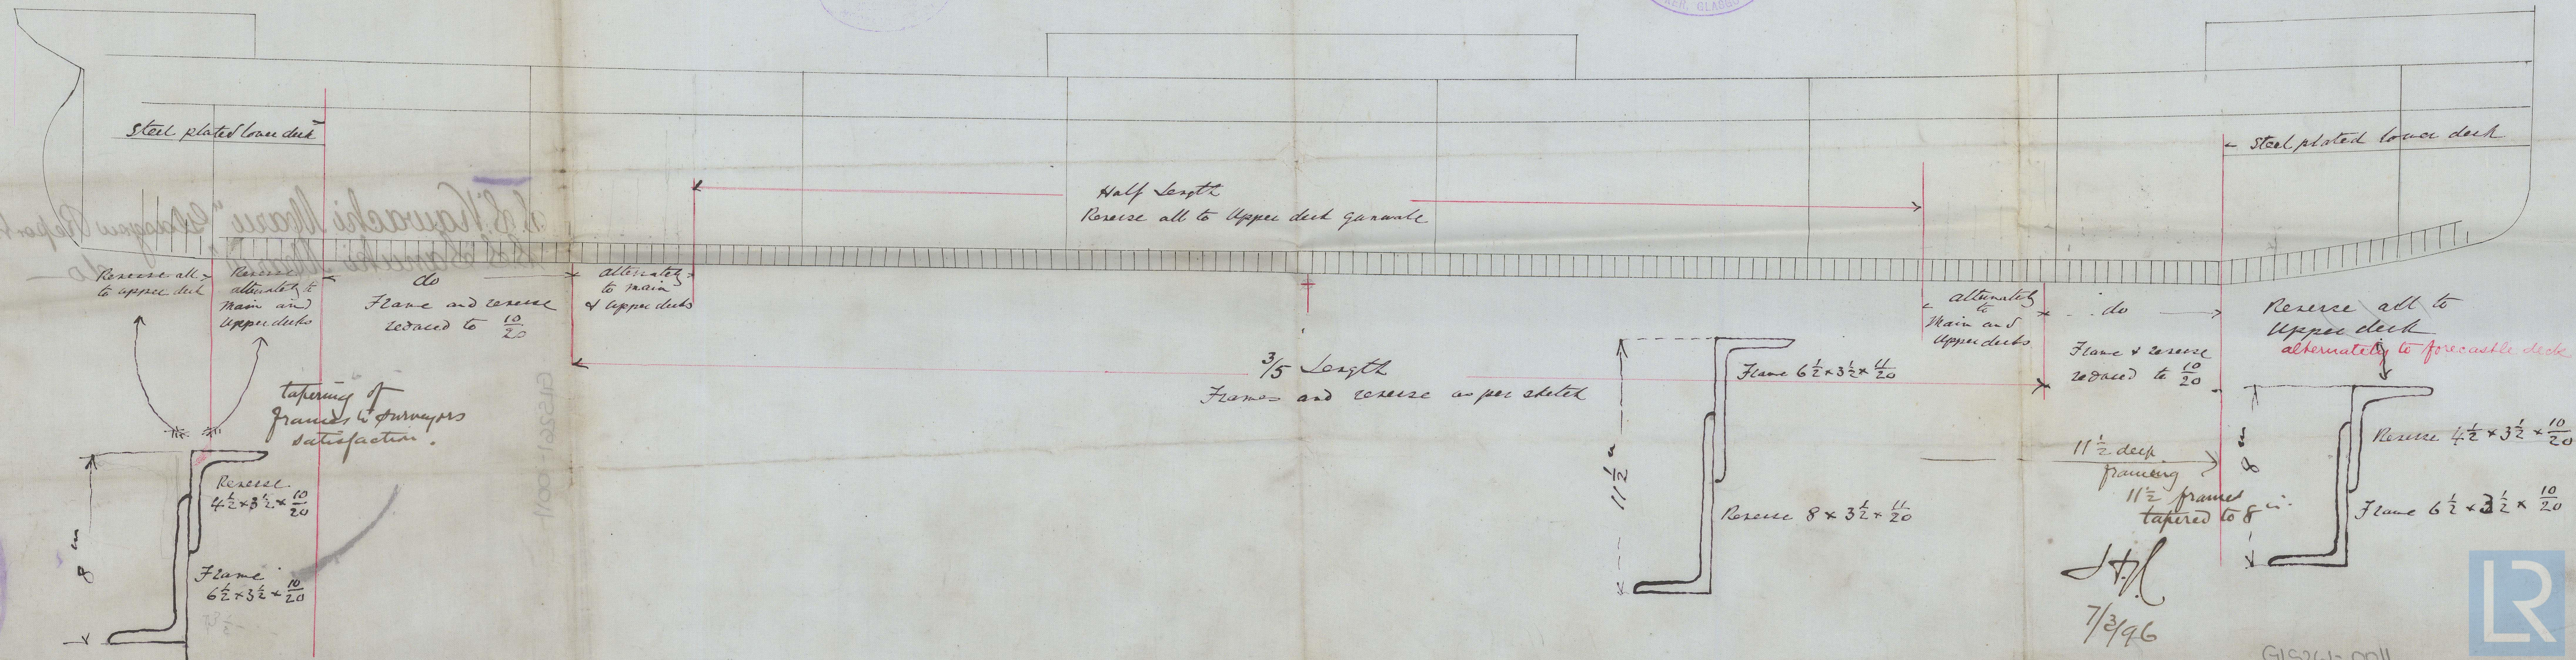


GLS261-0011



2000

7.3.7

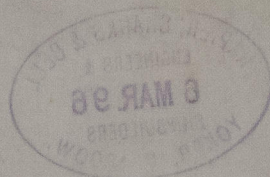

S.S. "Kawachi Maru" Glasgow Report No. 15722  
S.S. "Sanuki Maru" do

Shank's Nello  
182

GLS261-0011



© 2012  
Lloyd's Register  
Foundation

GLS261-0011