

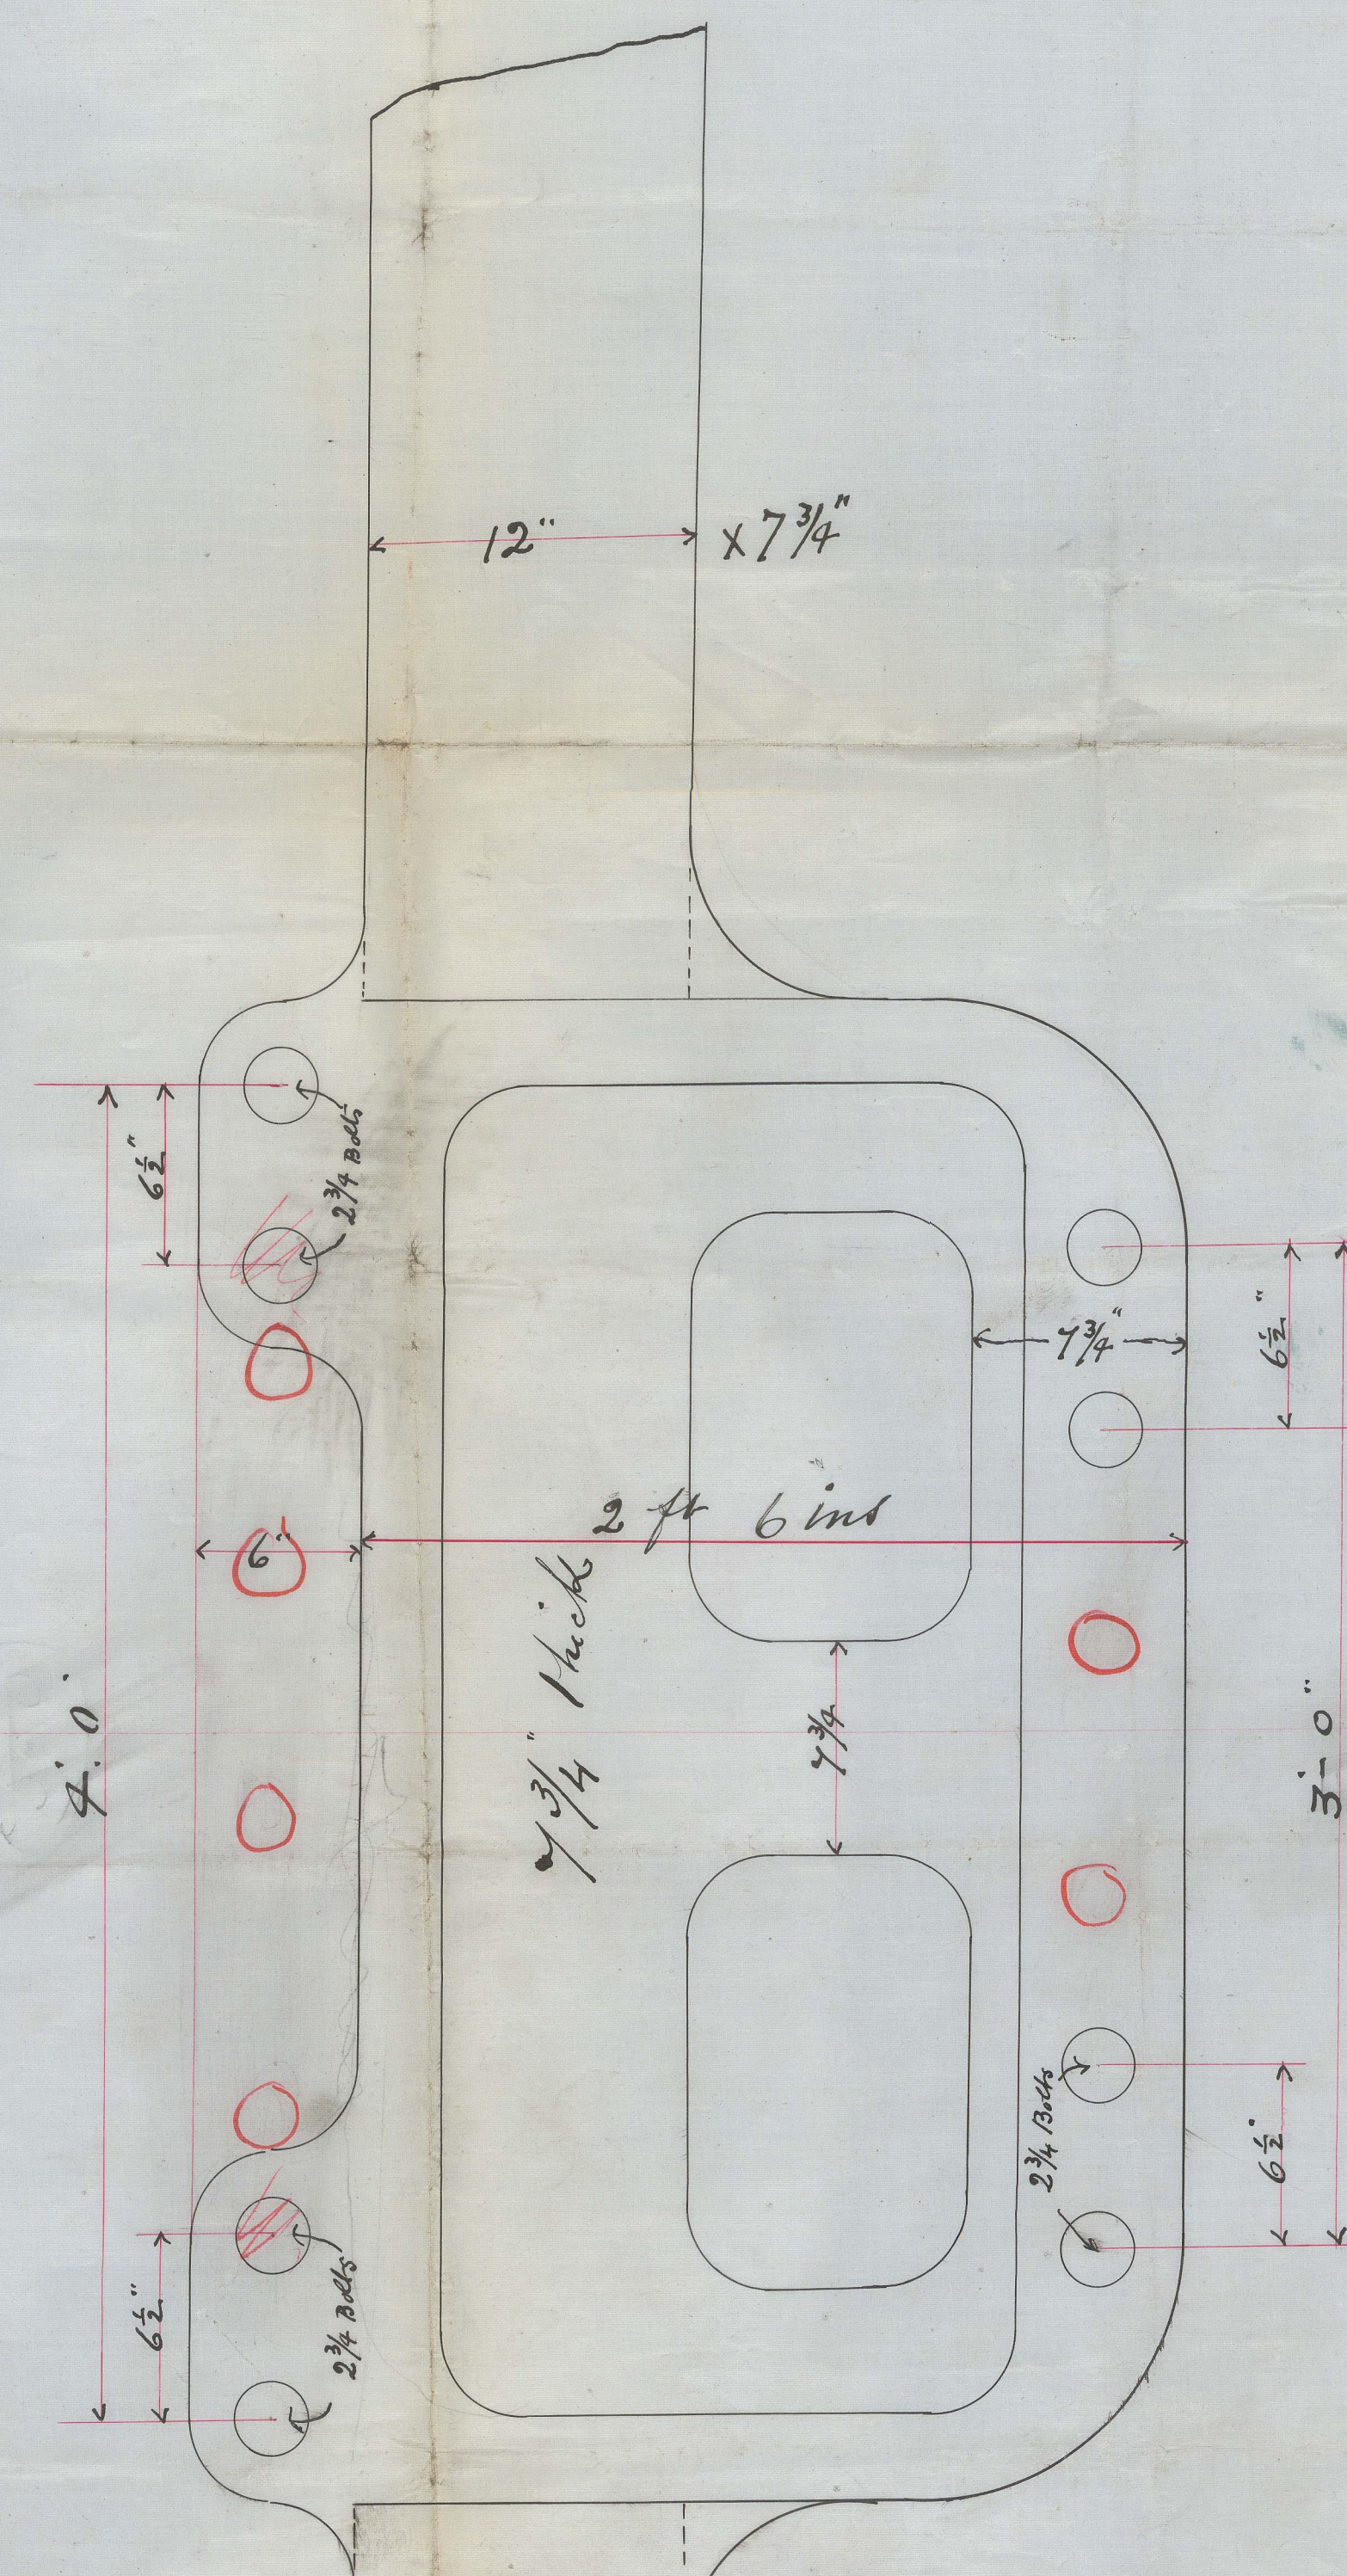
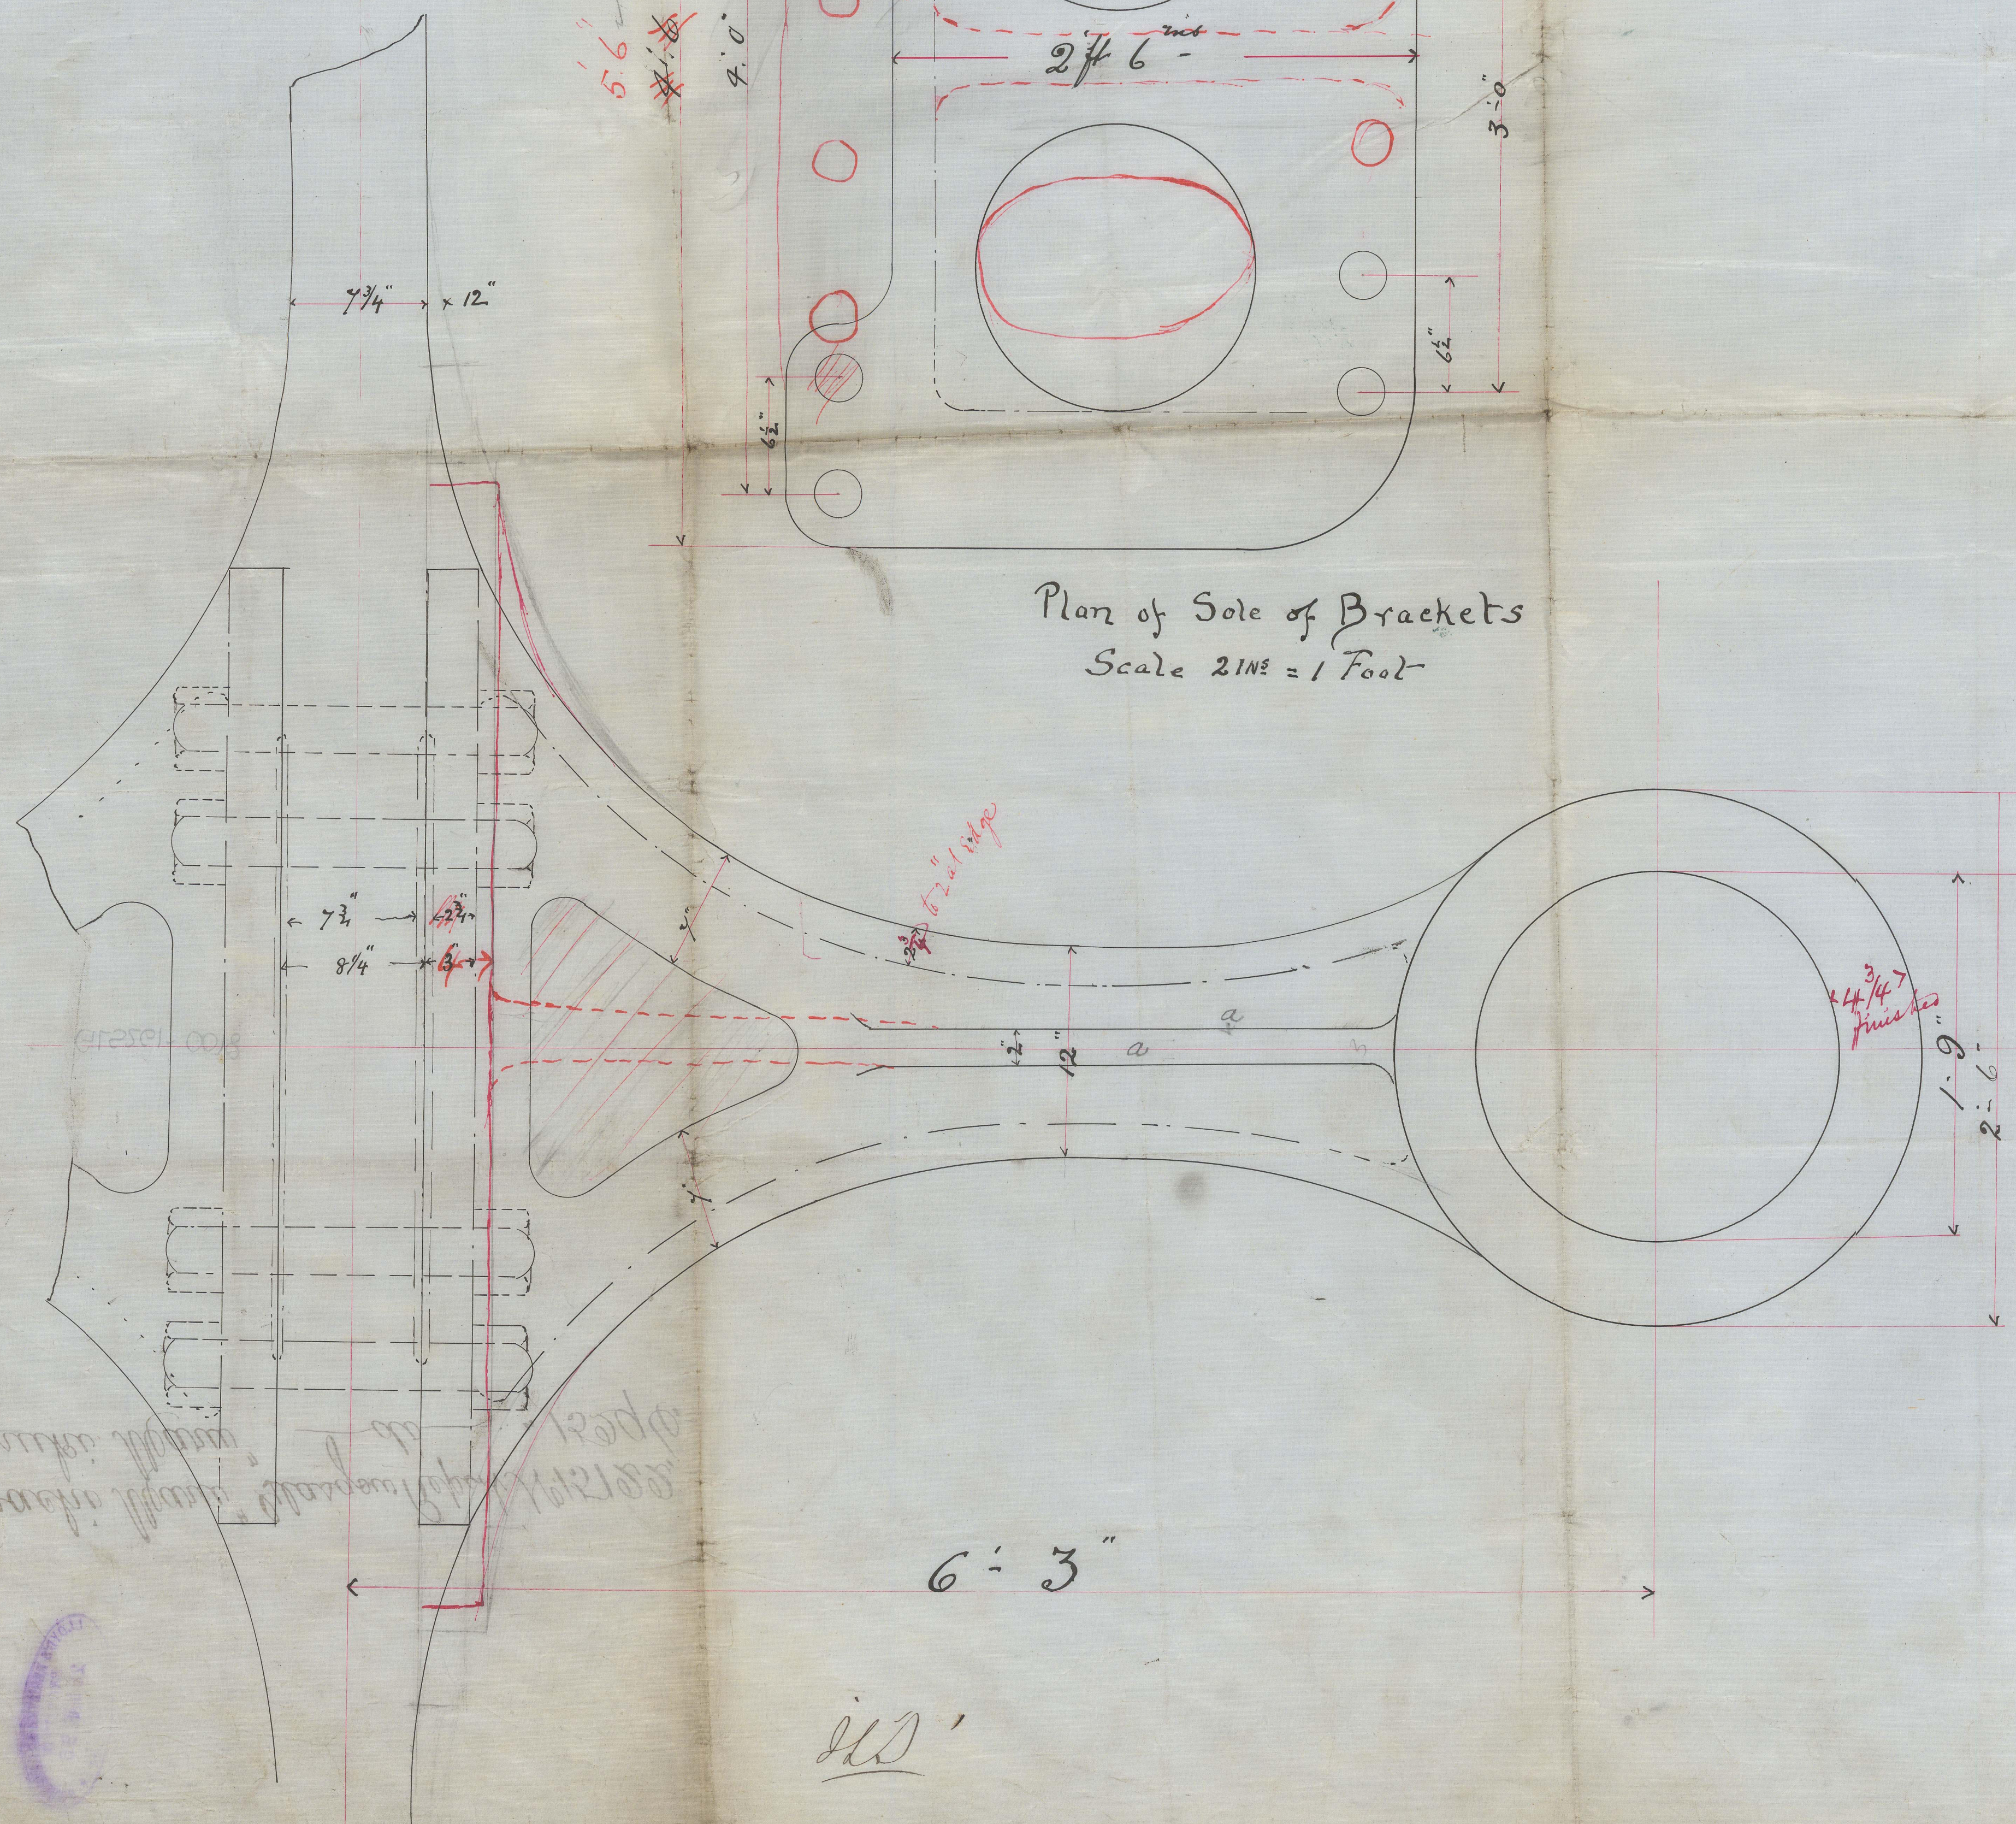


30.3.96

NAPIER, SHANKS & BELL
ENGINEERS &
25 MAR. 96
SHIPBUILDERS
YOKER, GLASGOW.

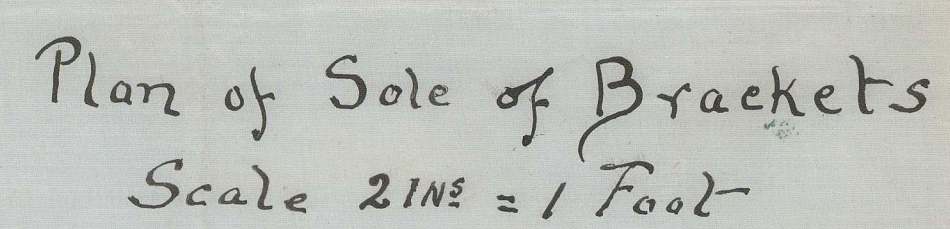

2100-19757D

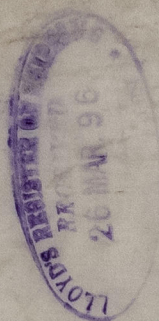

S.S. "Kawachi Maru" Glasgow Report No 15122,
S.S. "Sanuki Maru" — do — "15296.

GLS261-0018



© 2021

Lloyd's Register
Foundation