
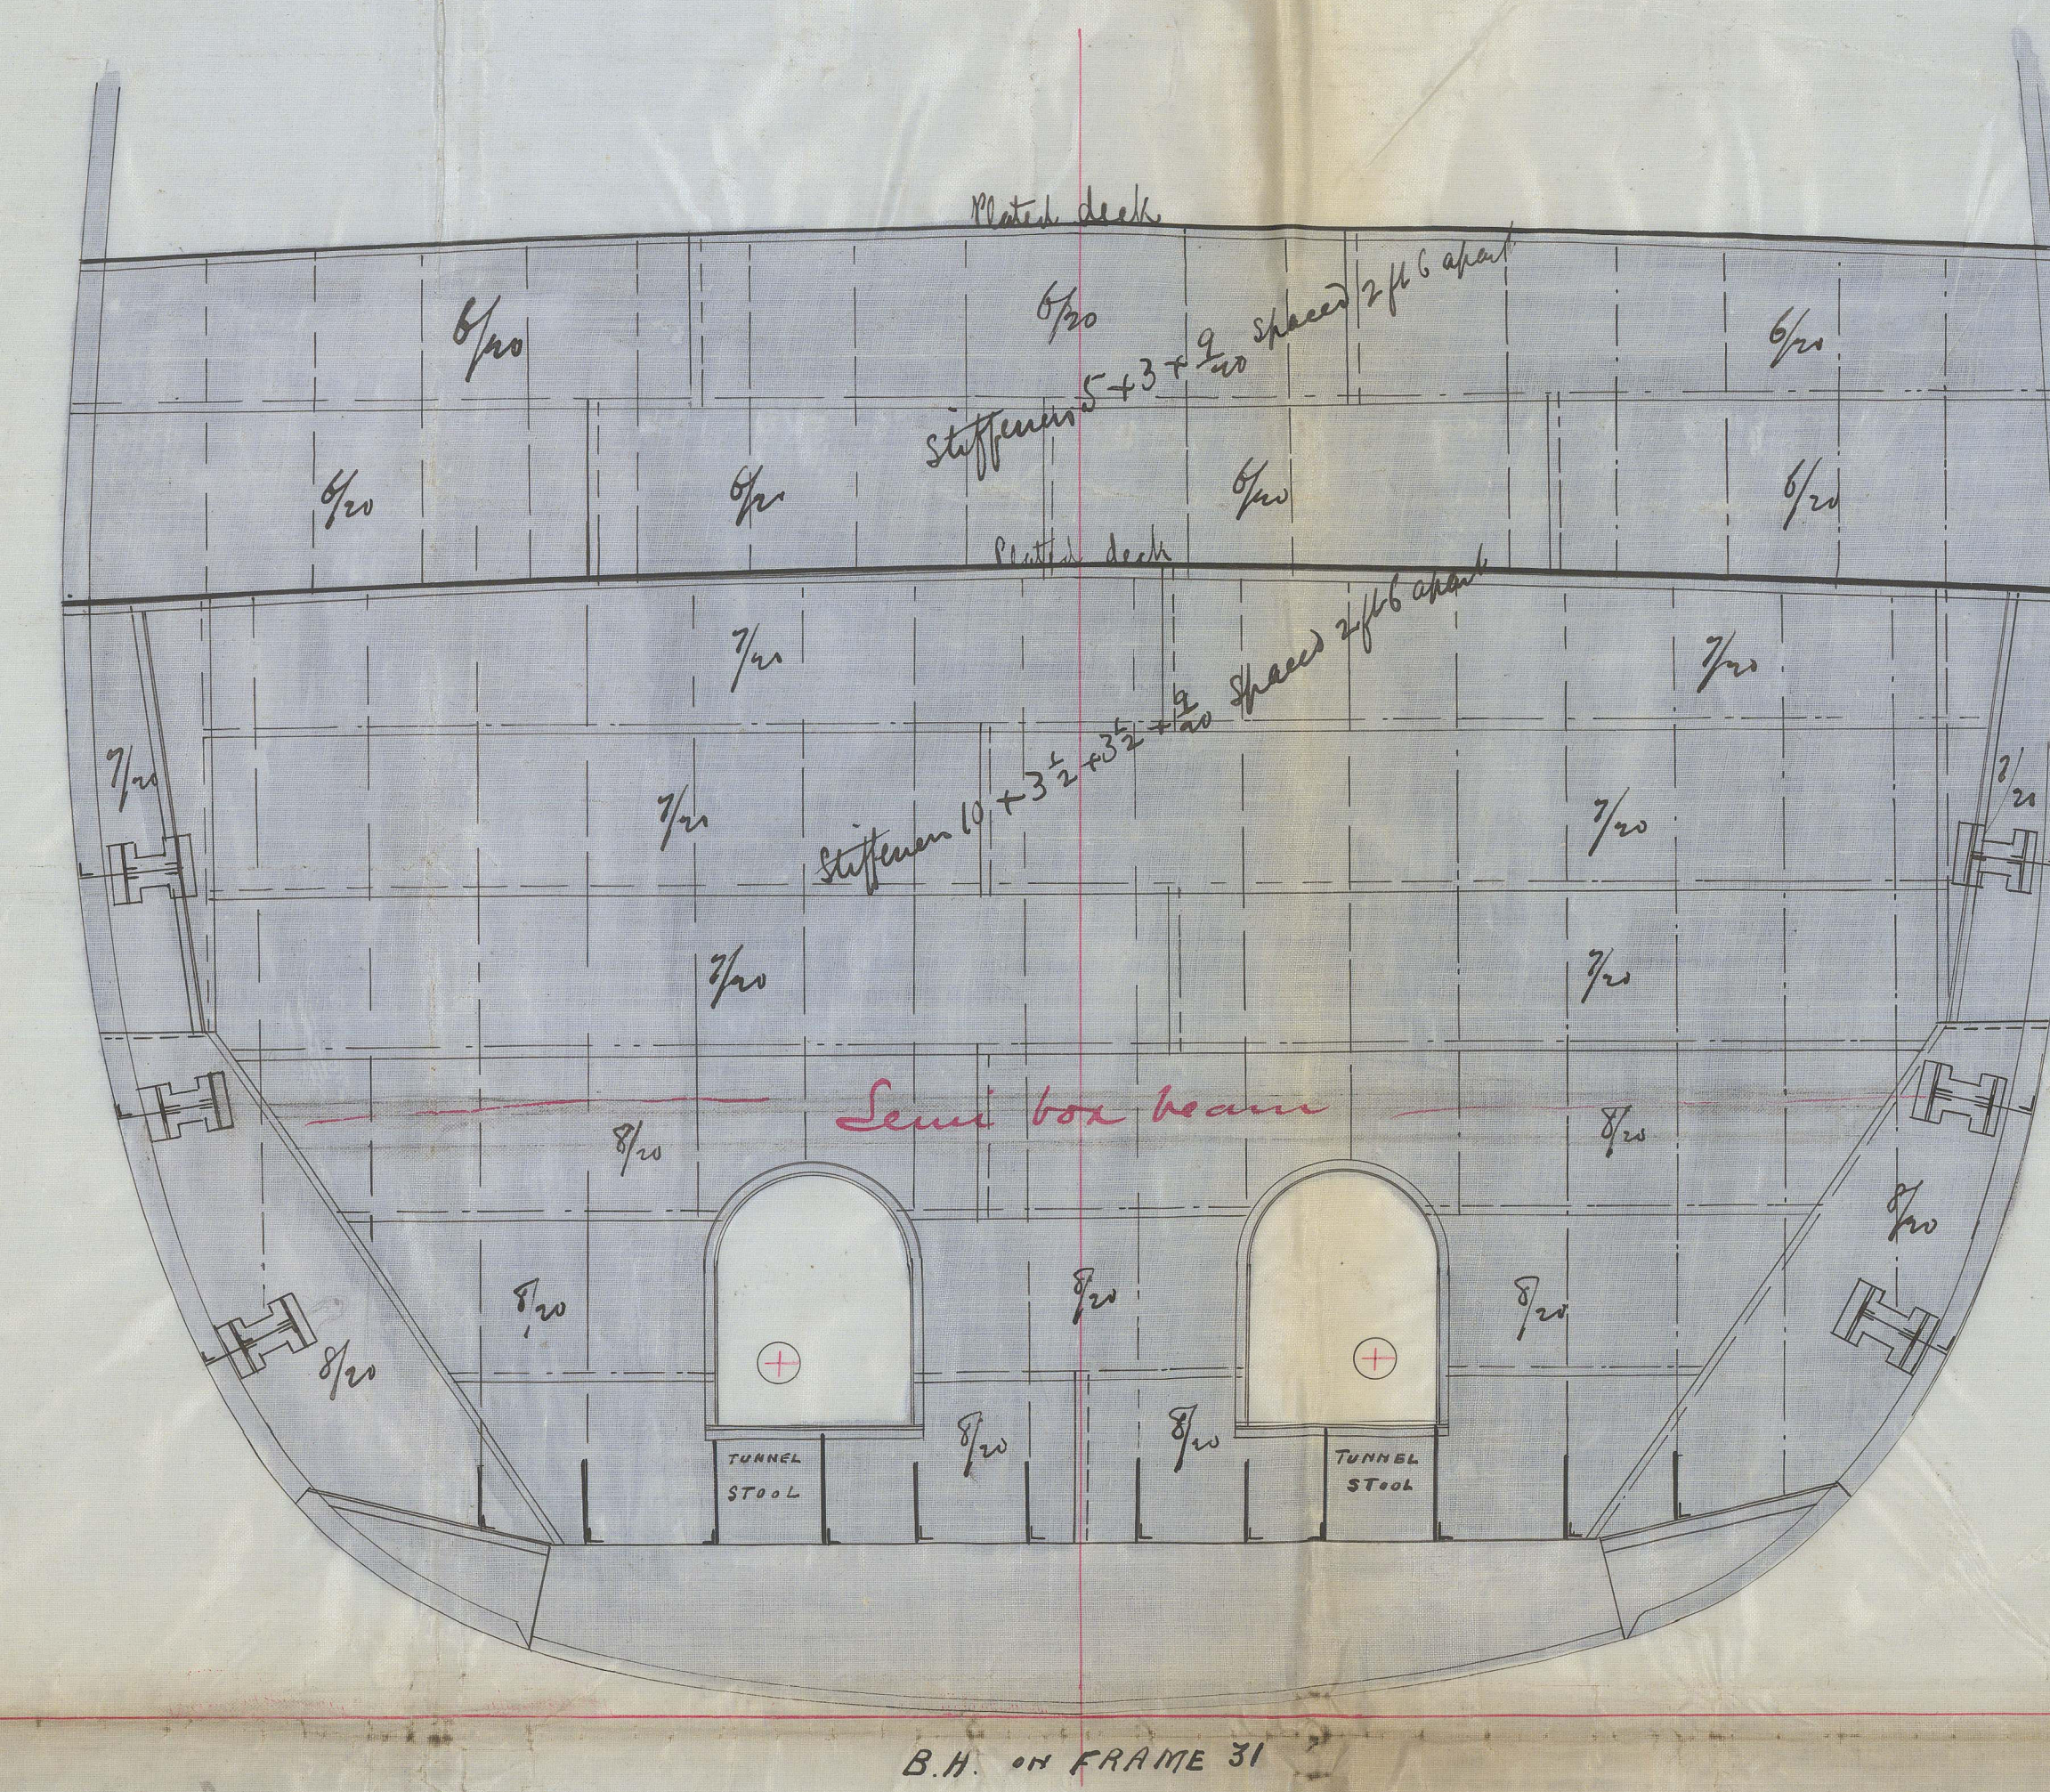
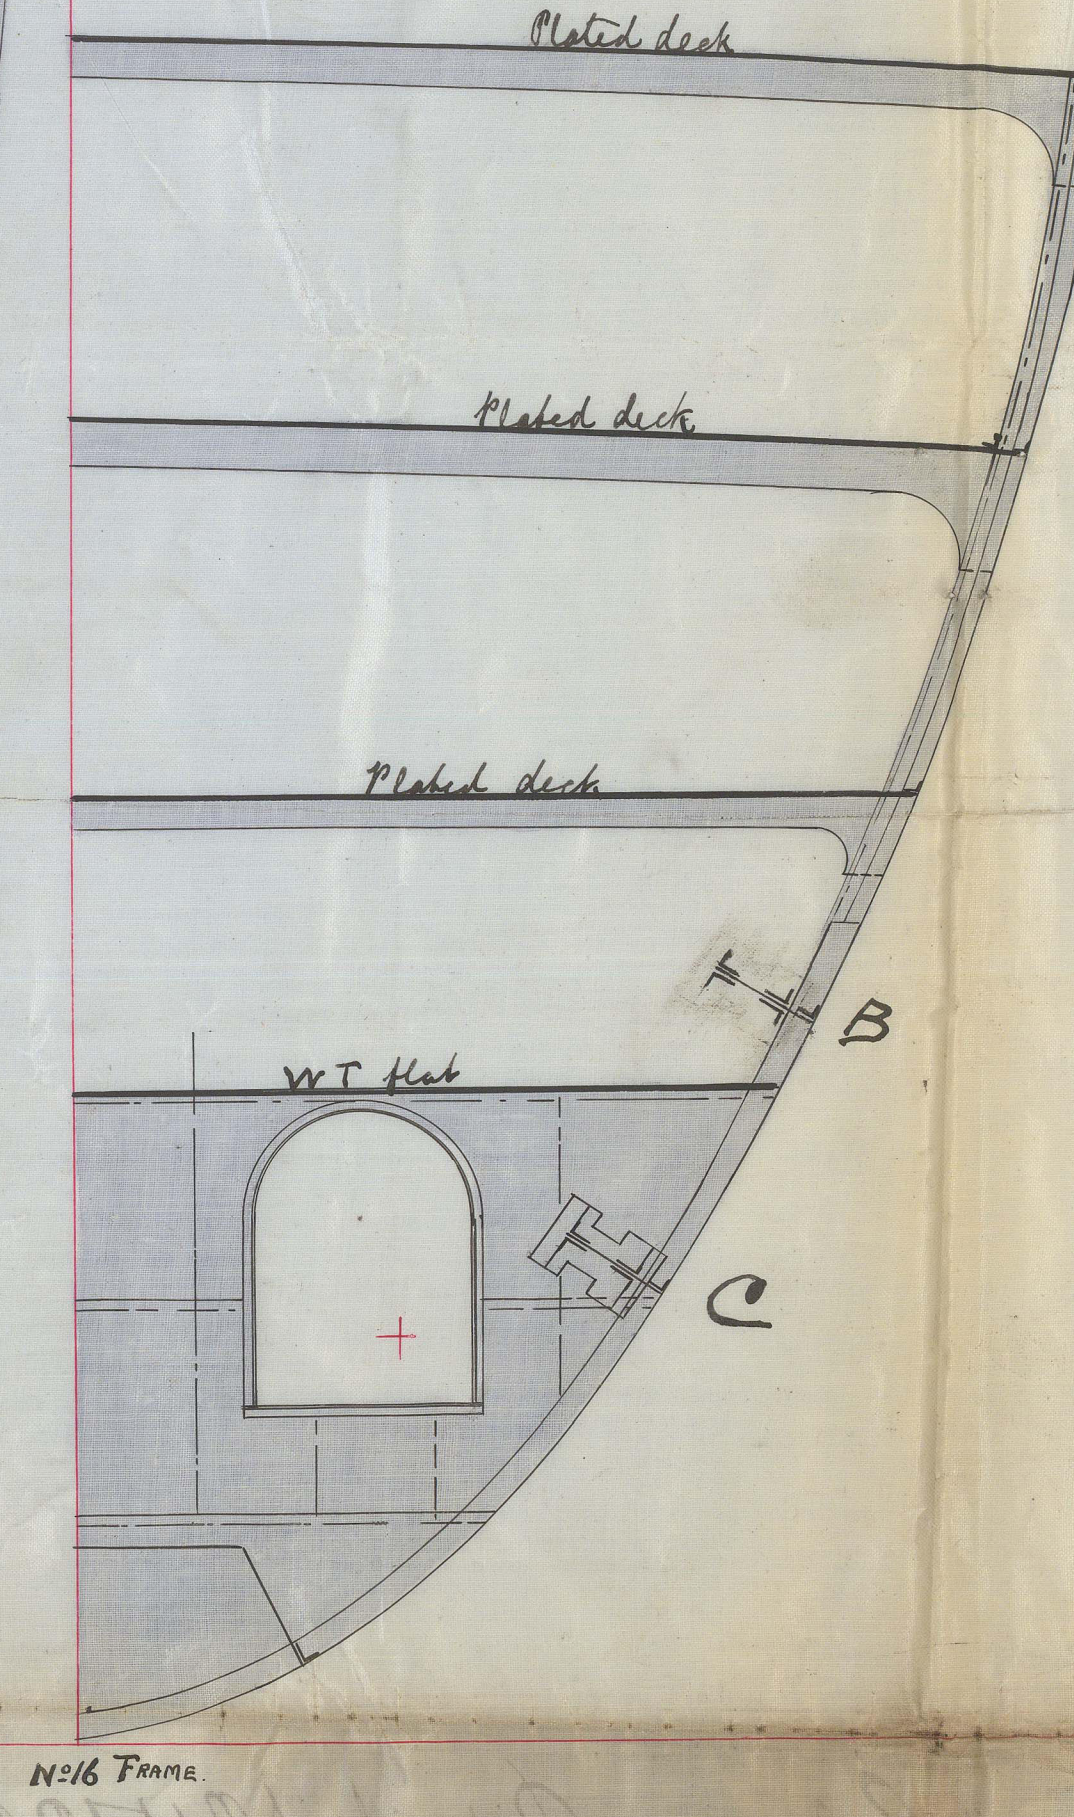
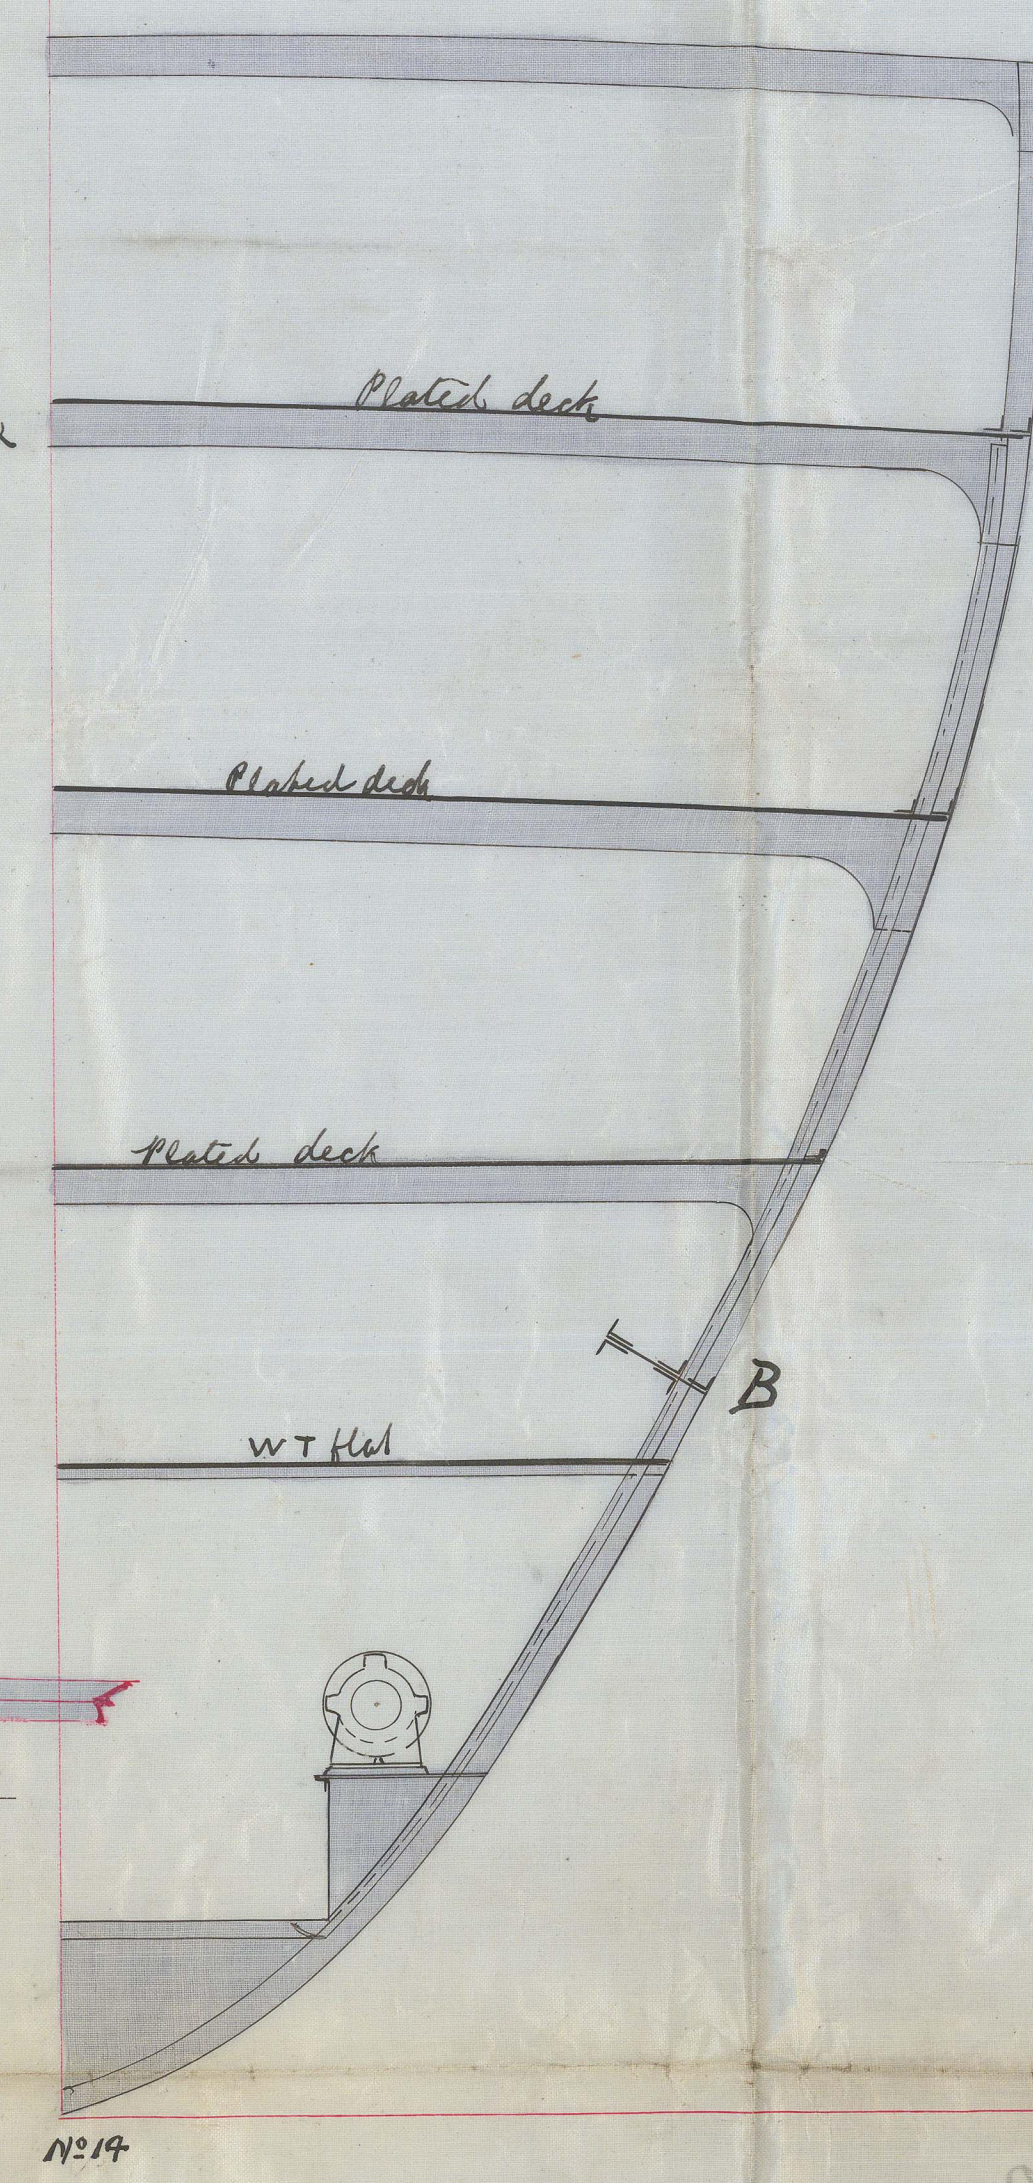


6083








4.5.96

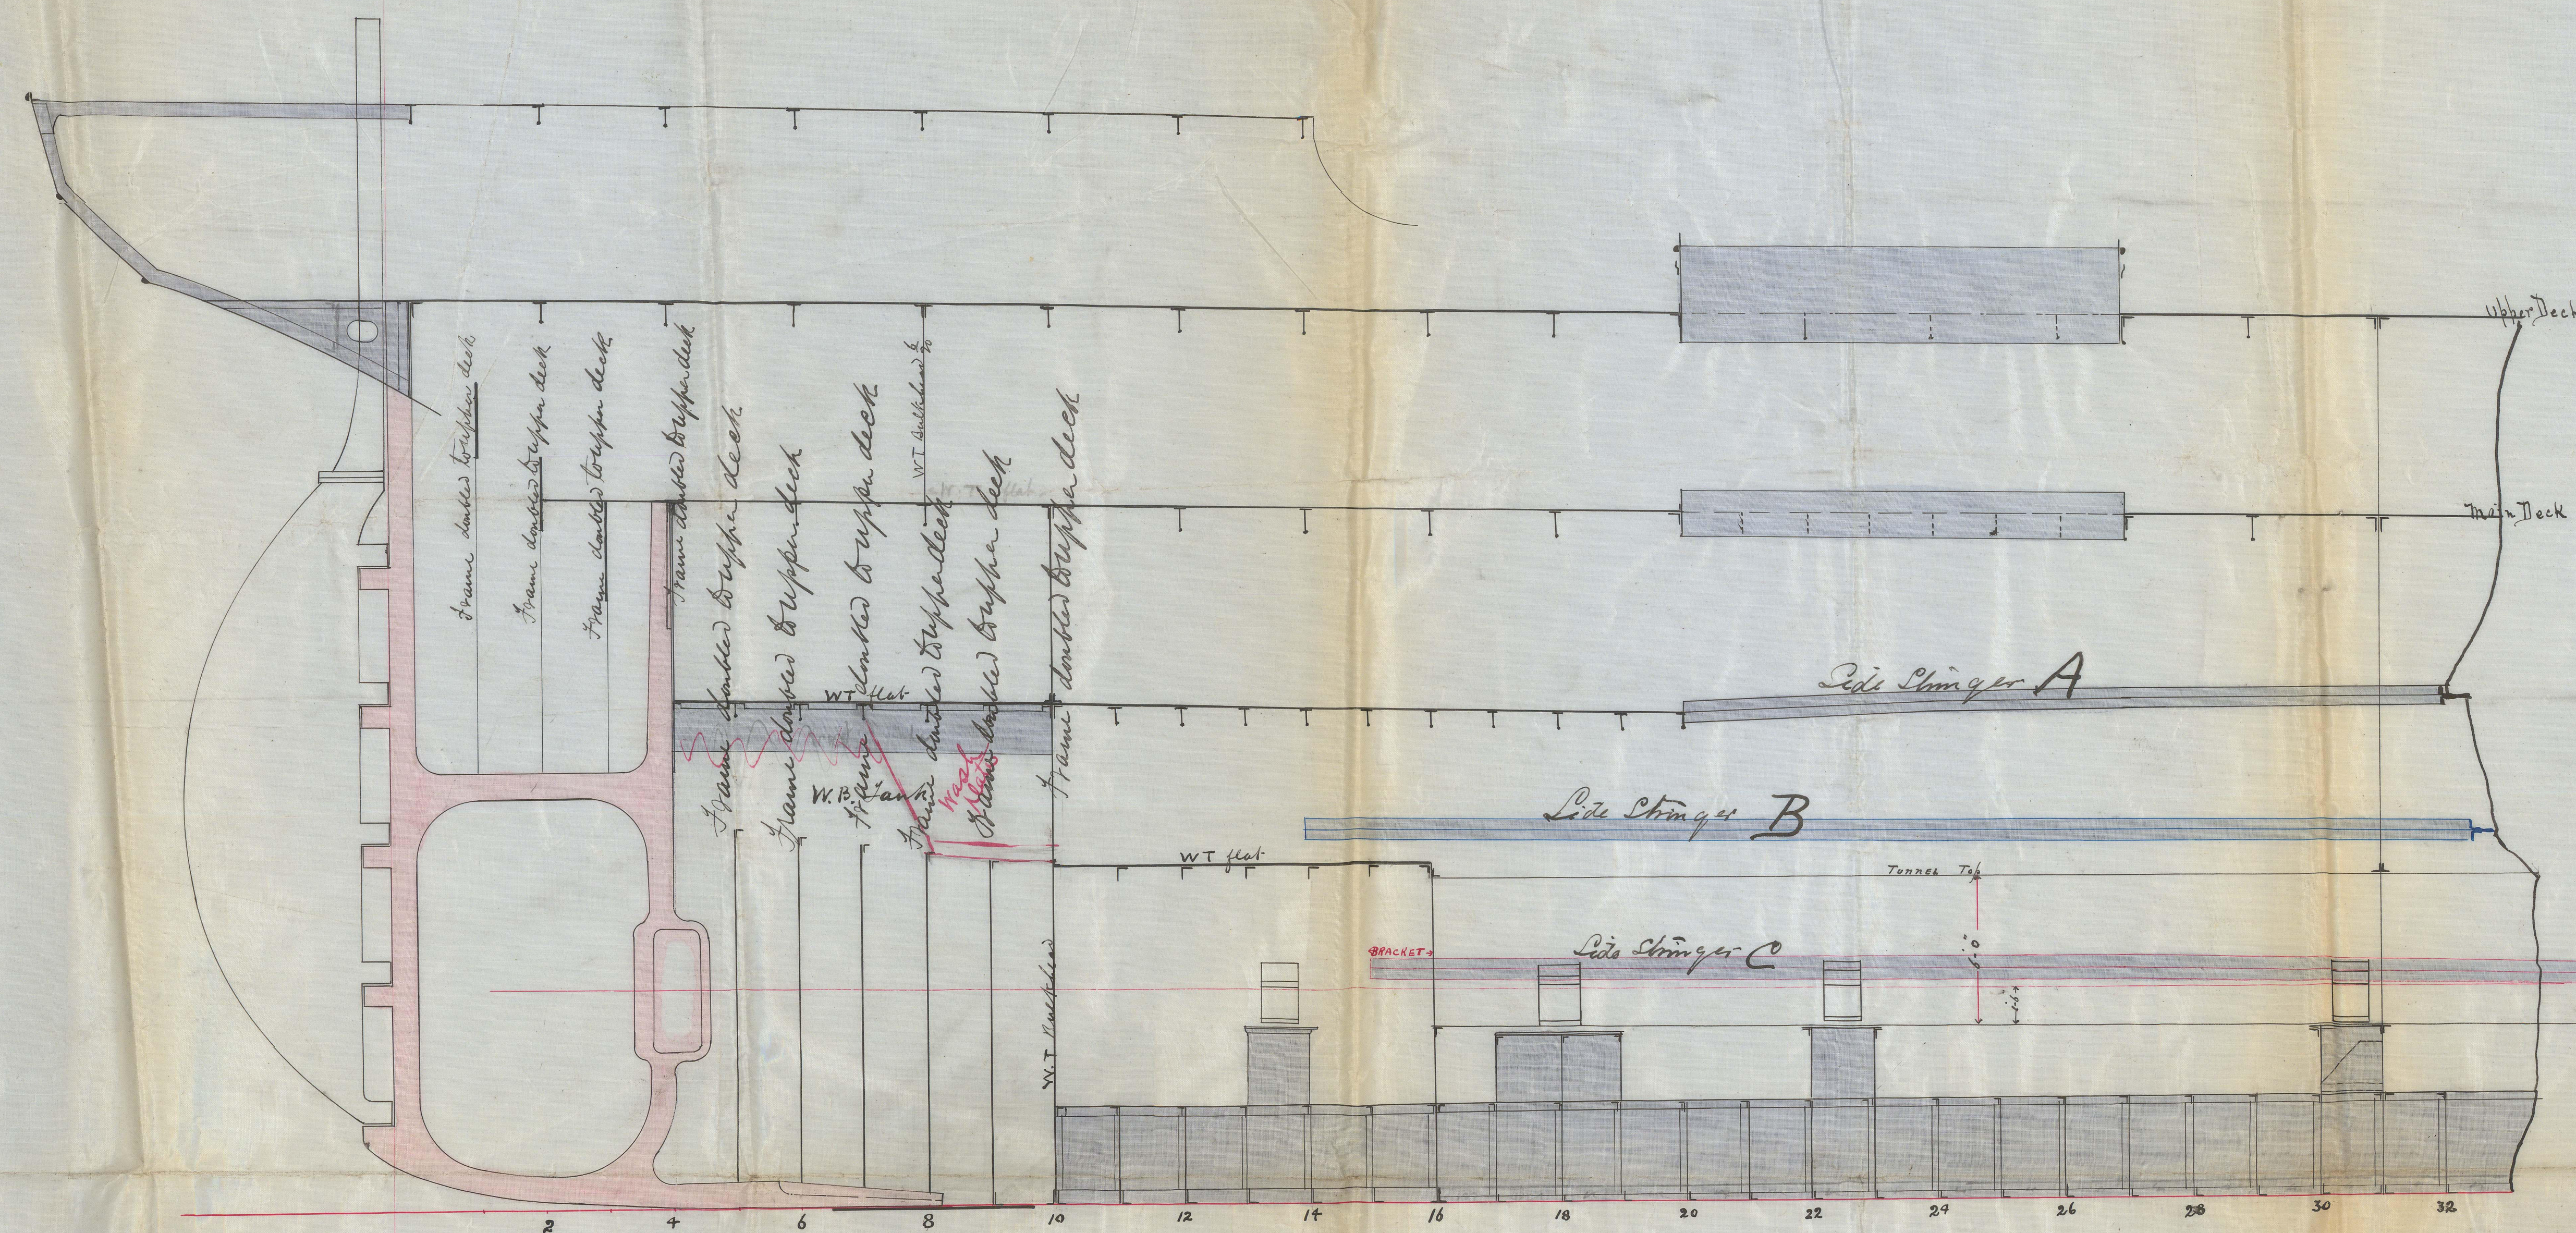

# ARRANGEMENT OF STERN FRAMES

NO 81382



SCALE 1/4 INCH = 1 FOOT

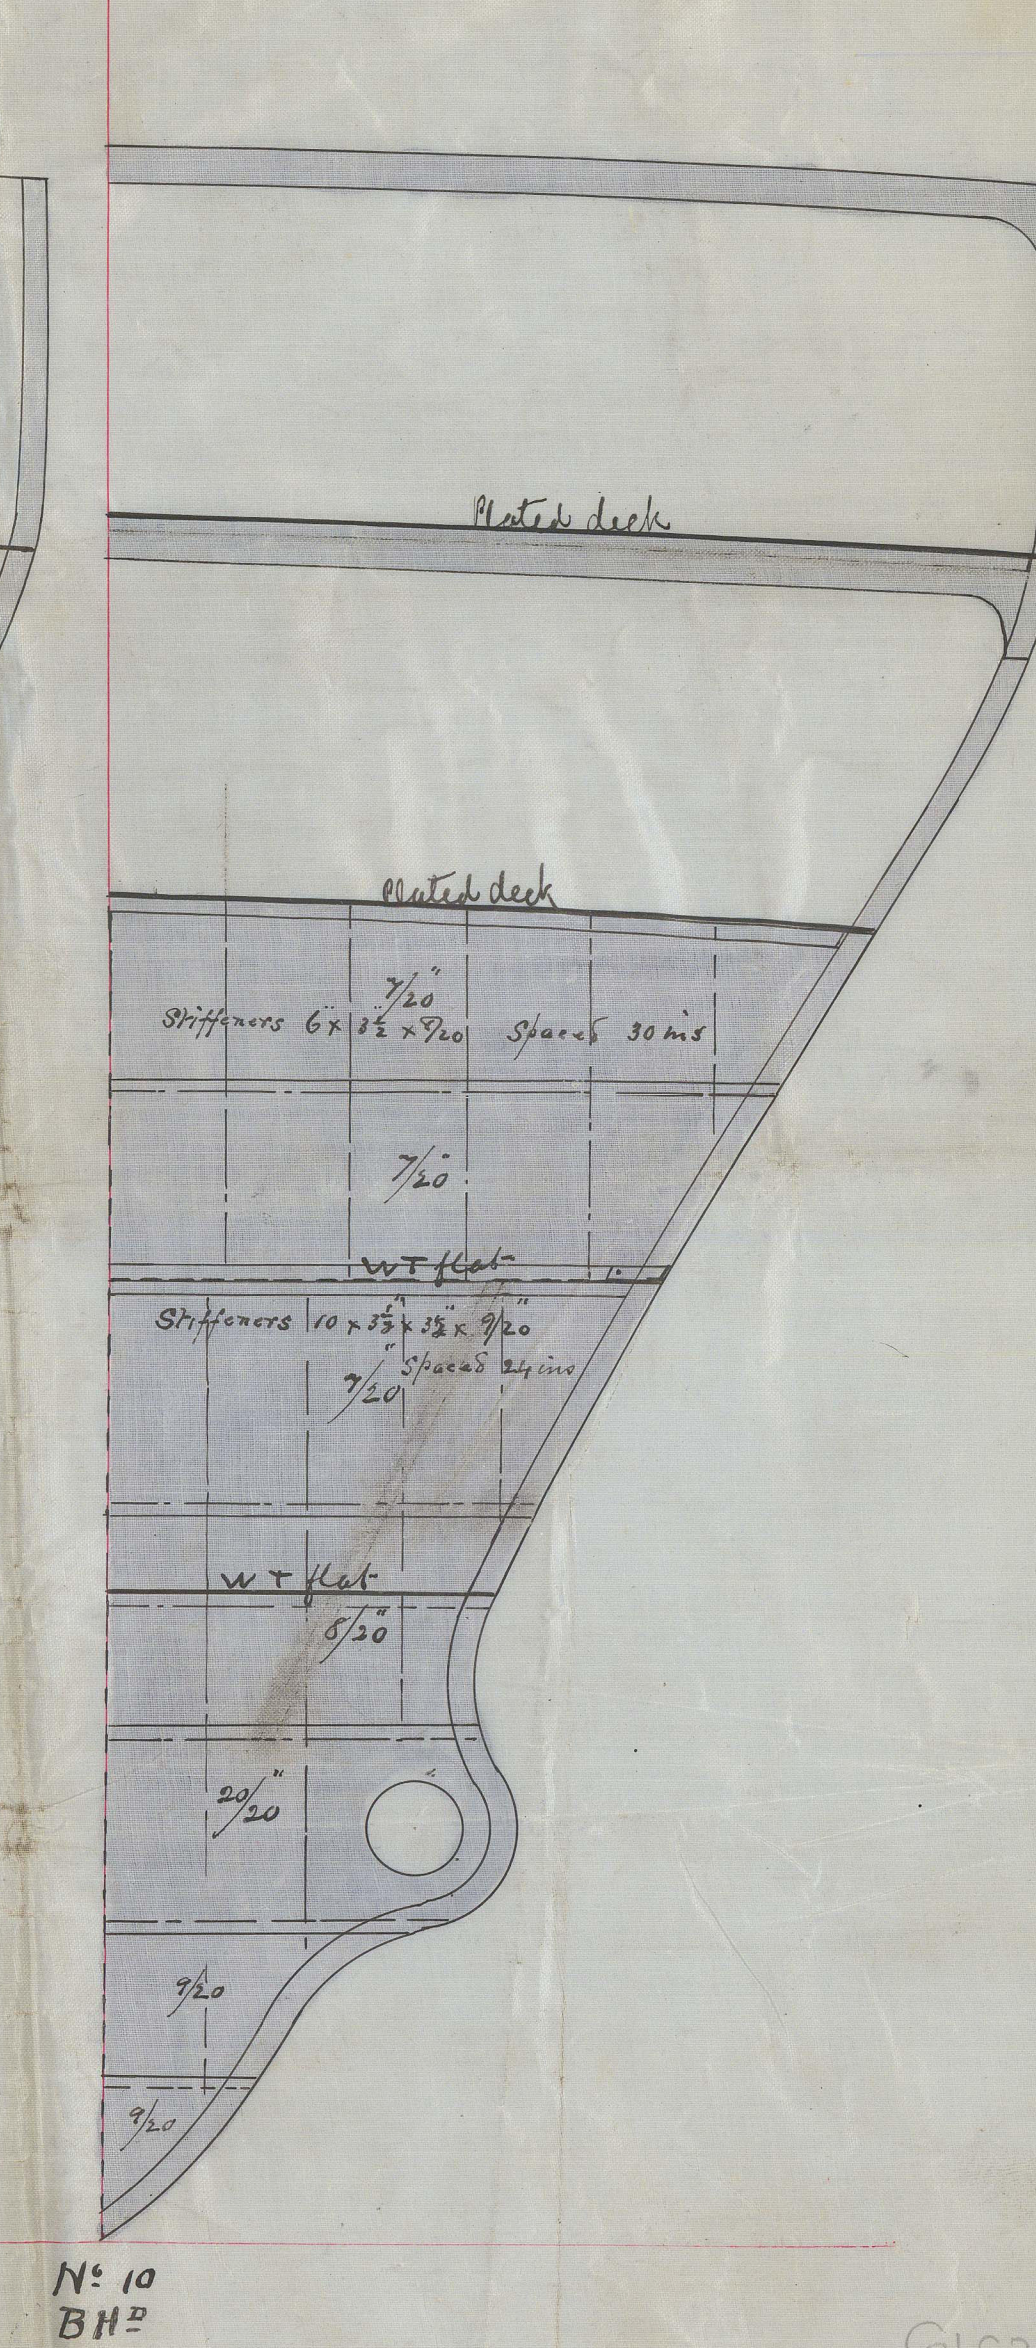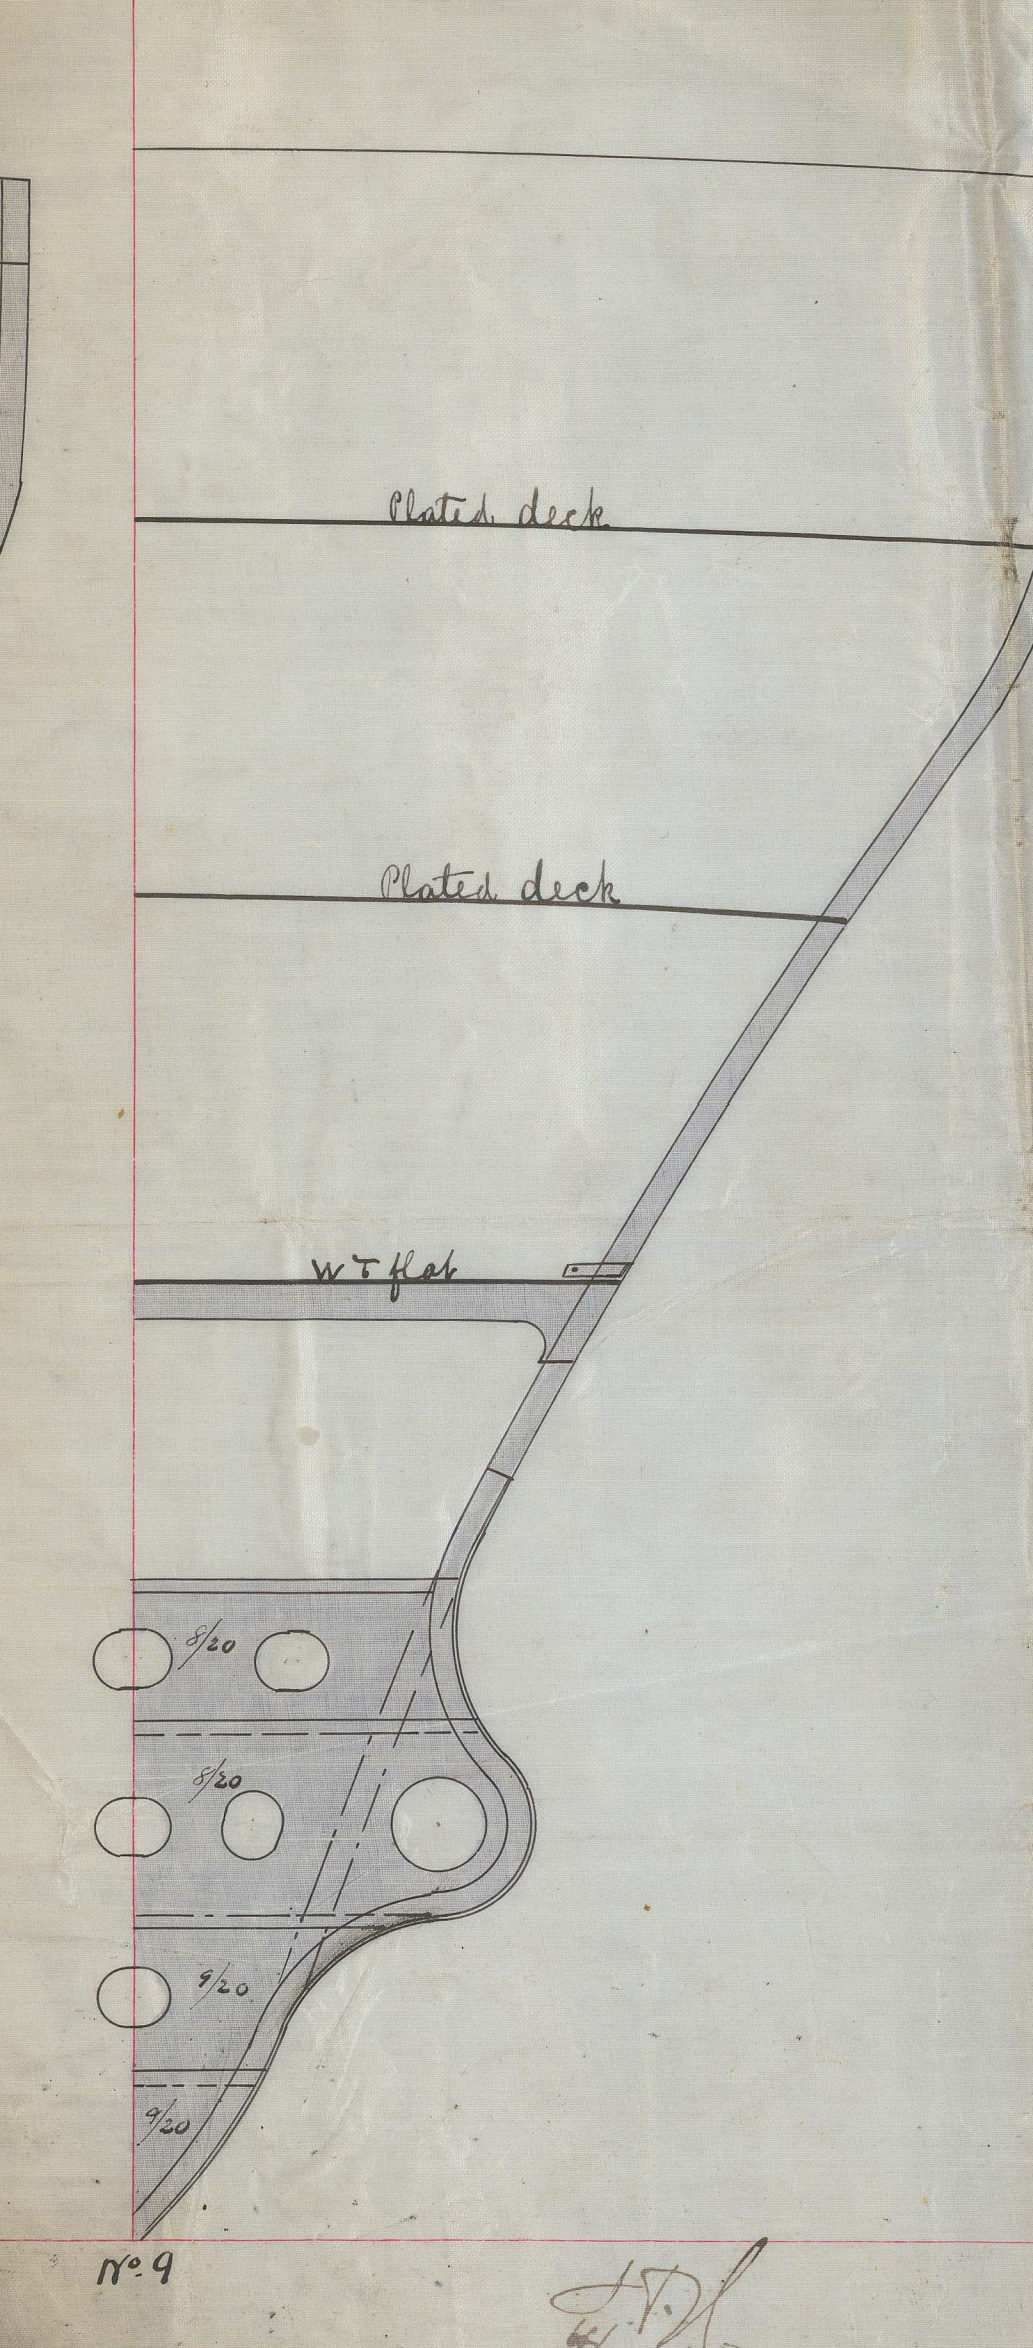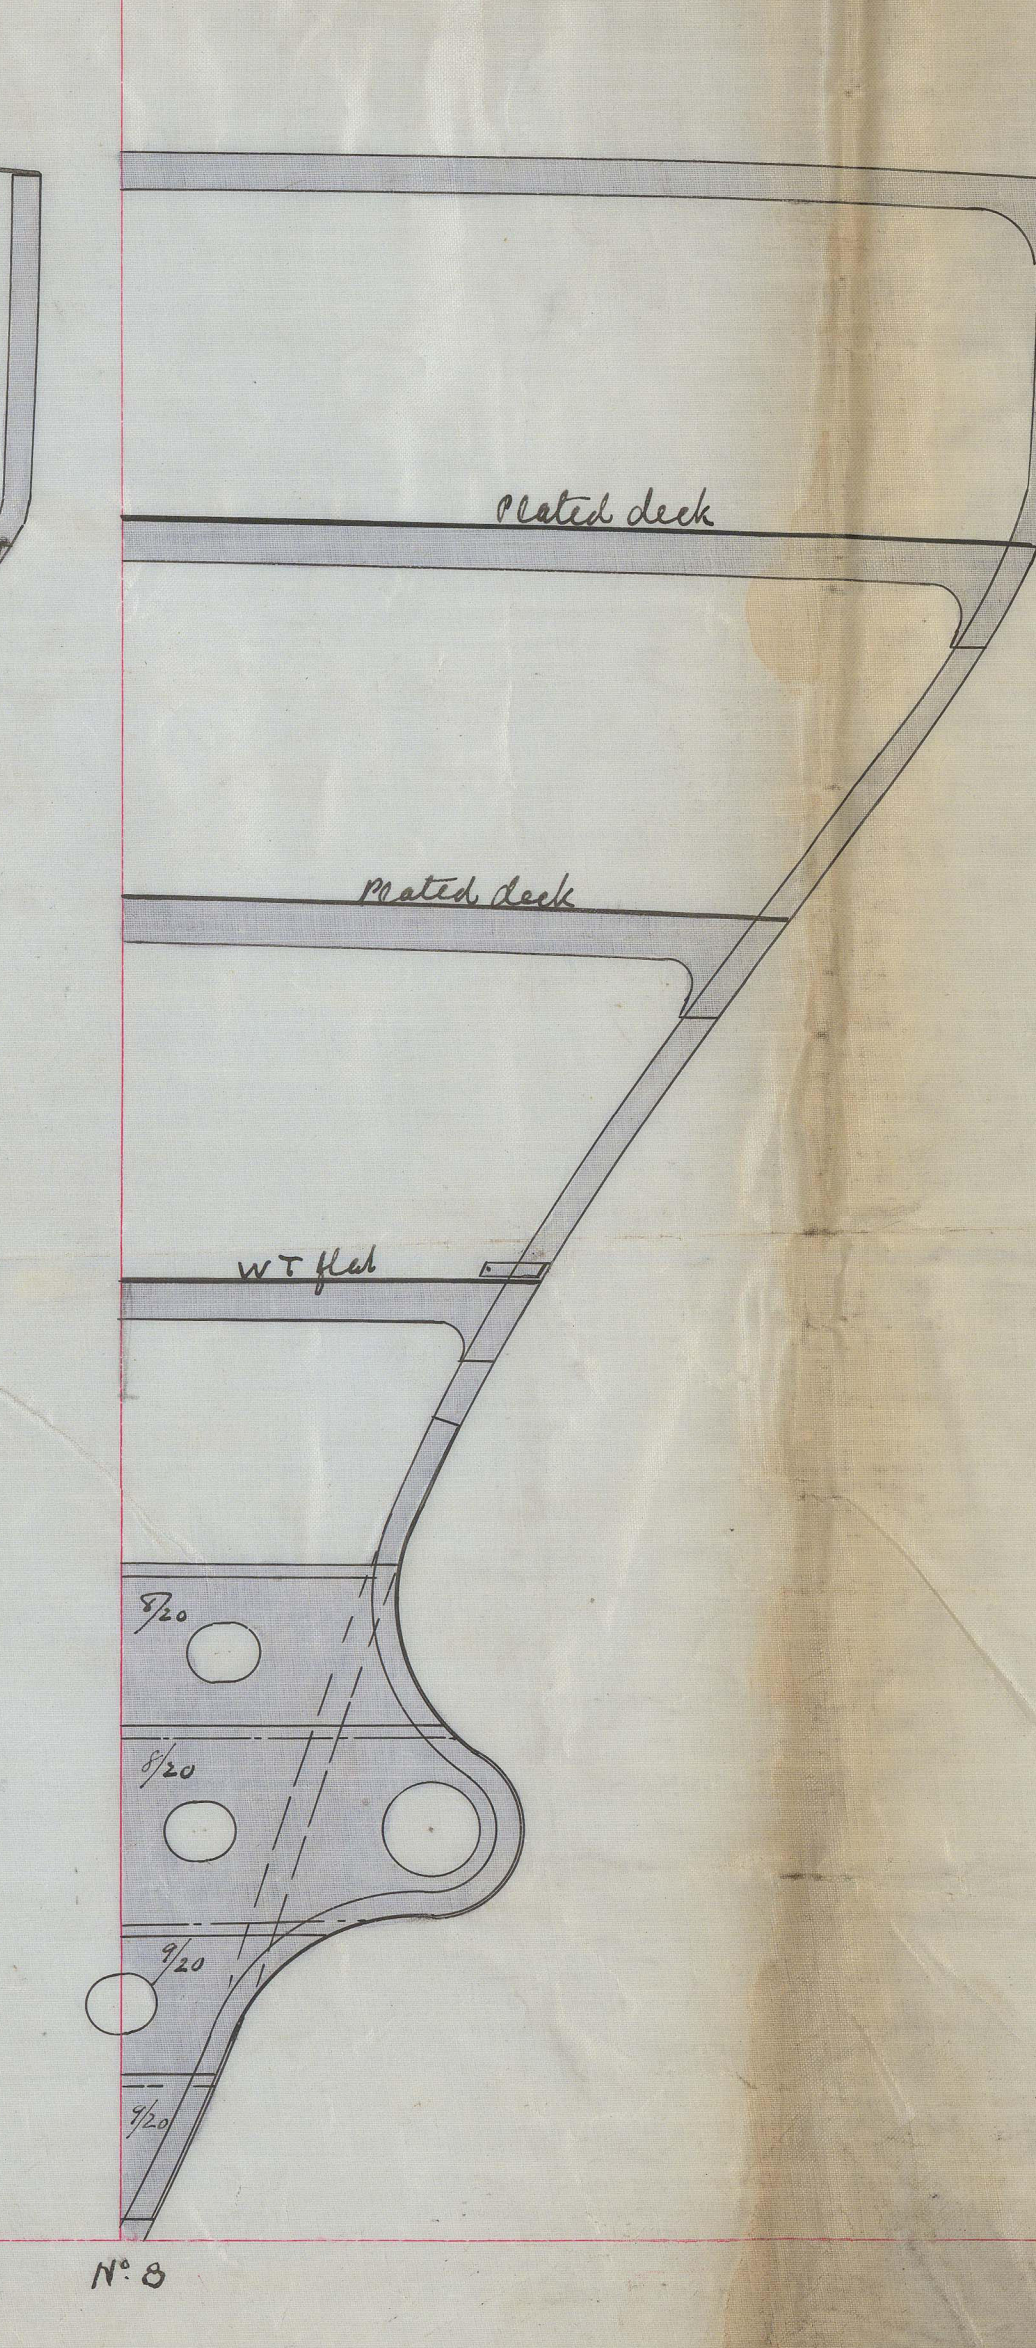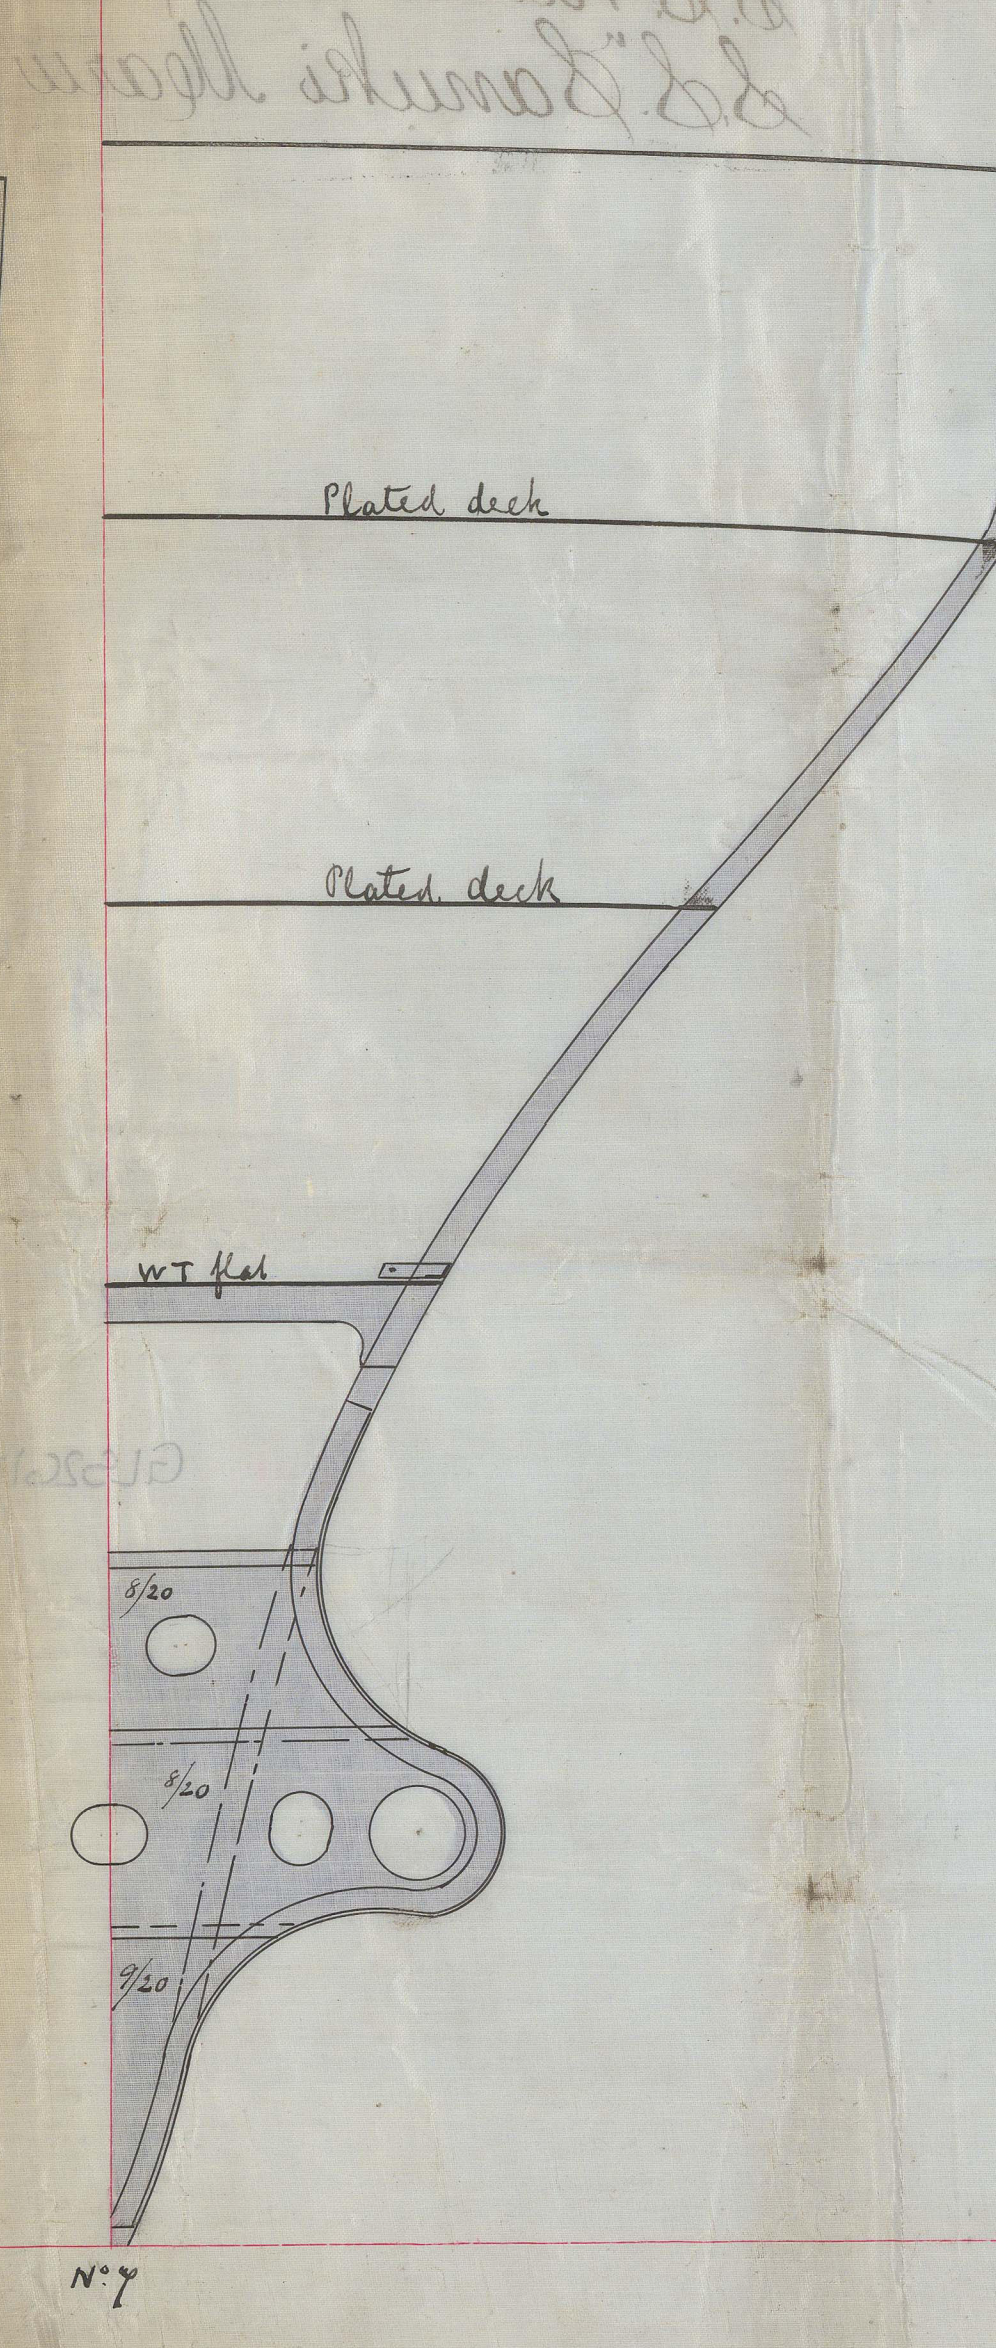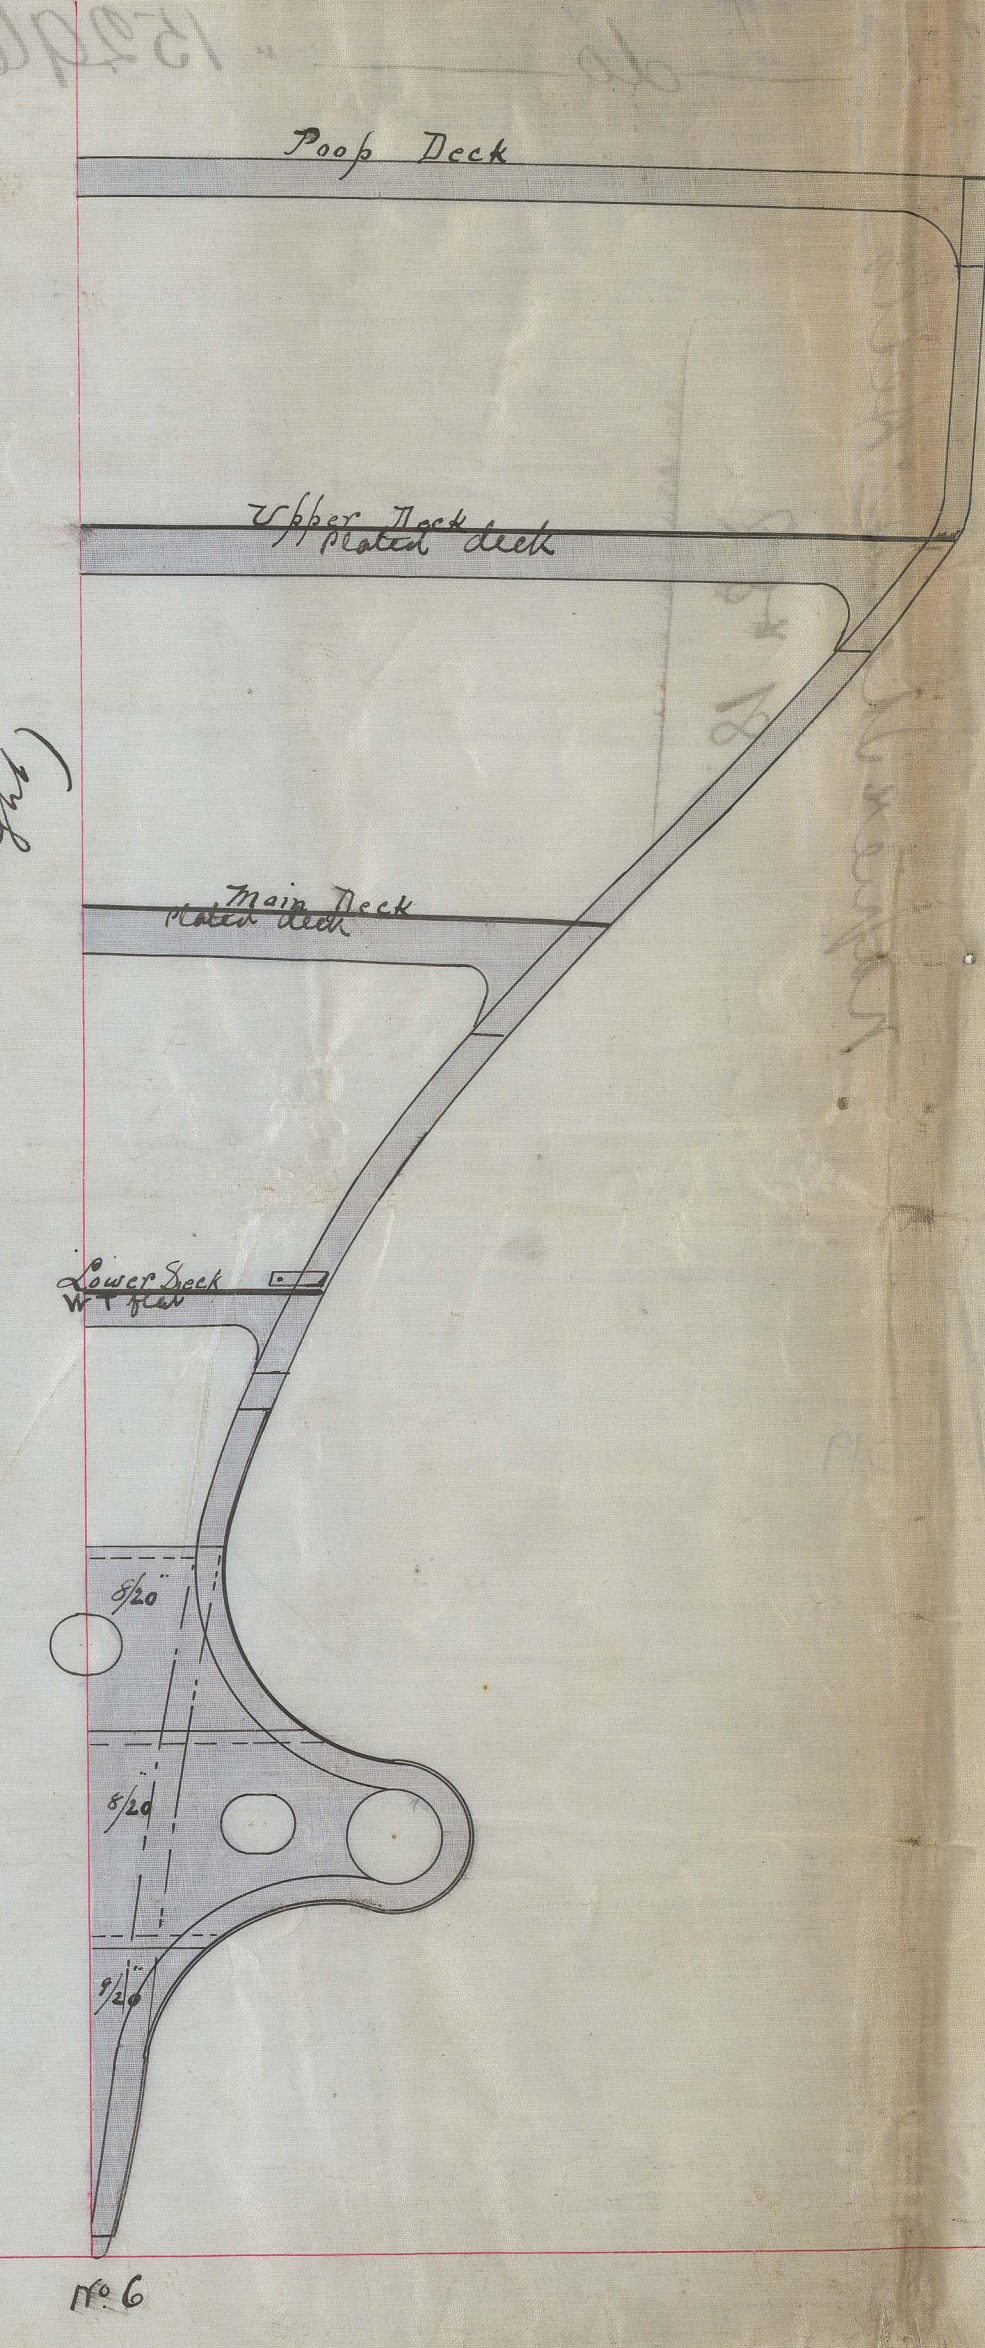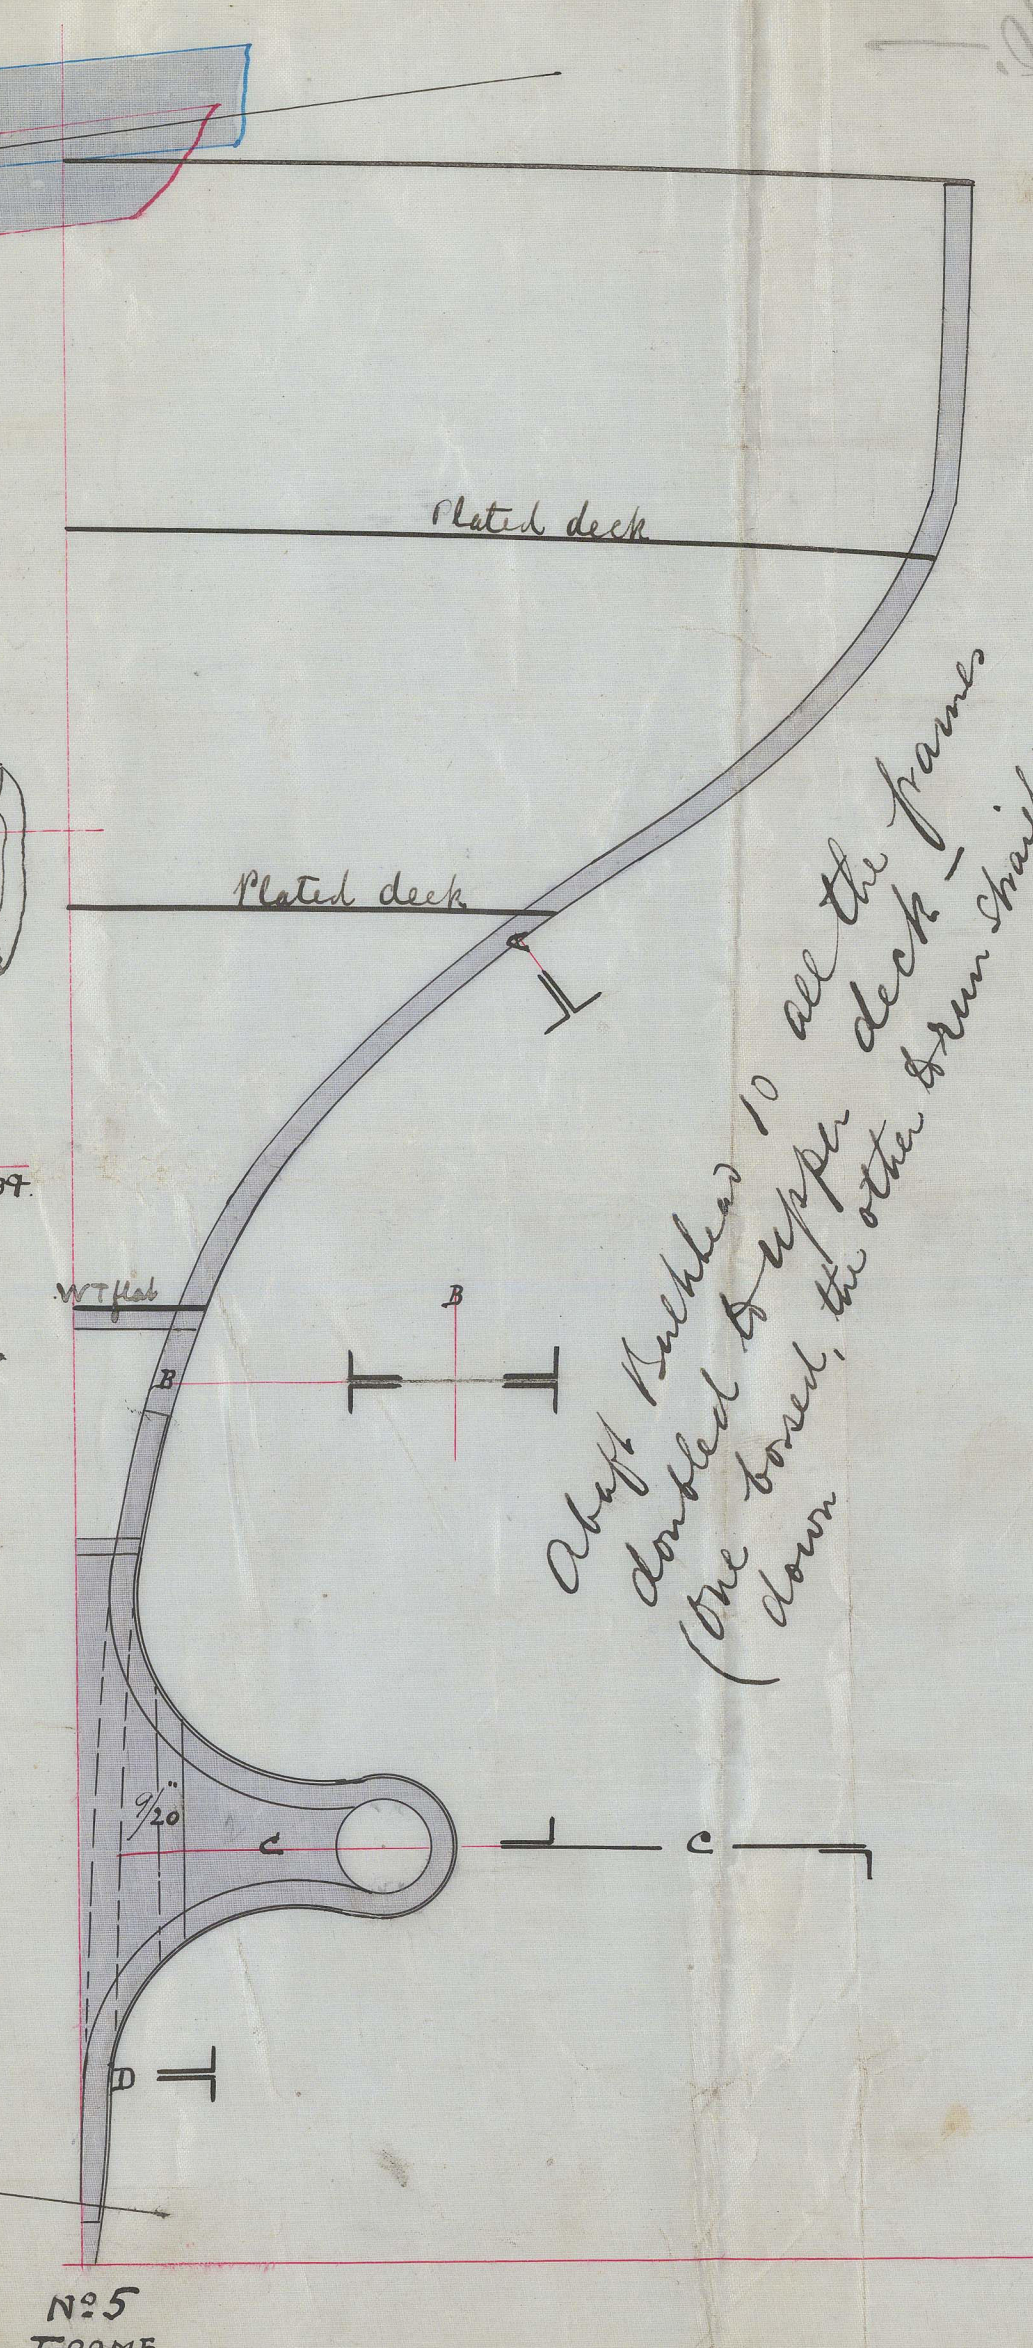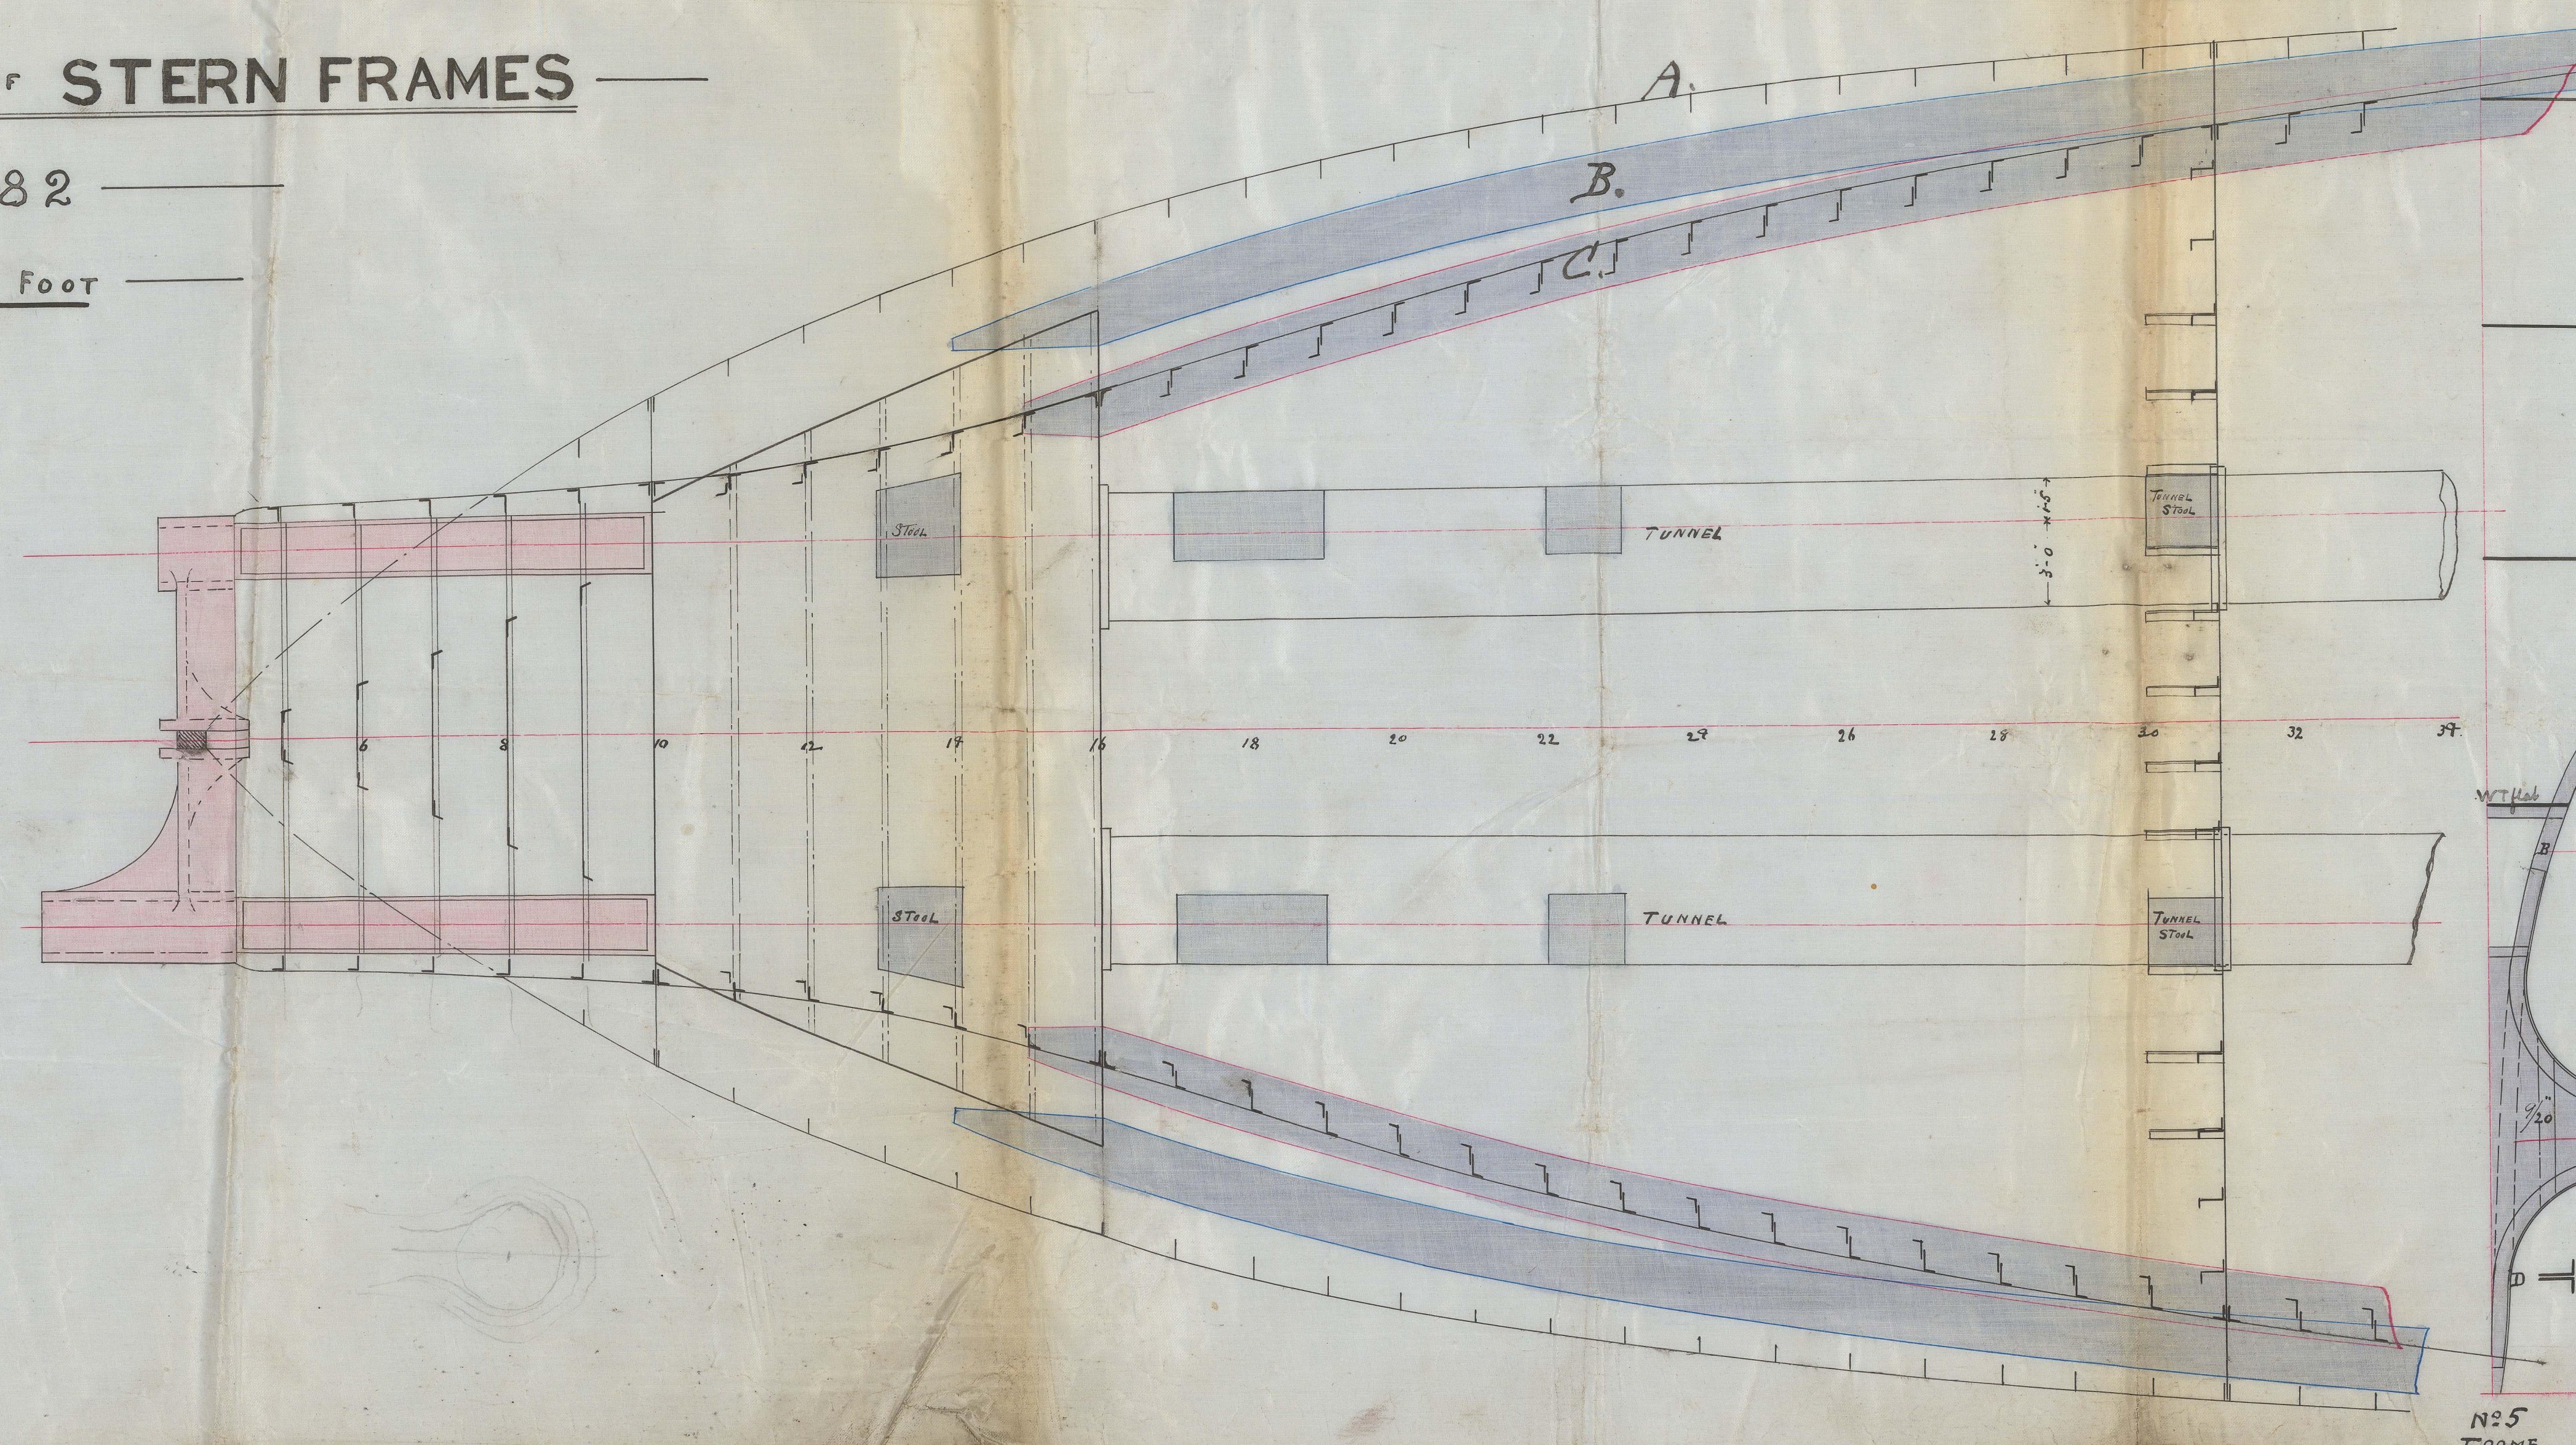




S.S. "Kawachi Maru" Glasgow Report No. 15122.  
 S.S. "Sanuki Maru" do "15296."

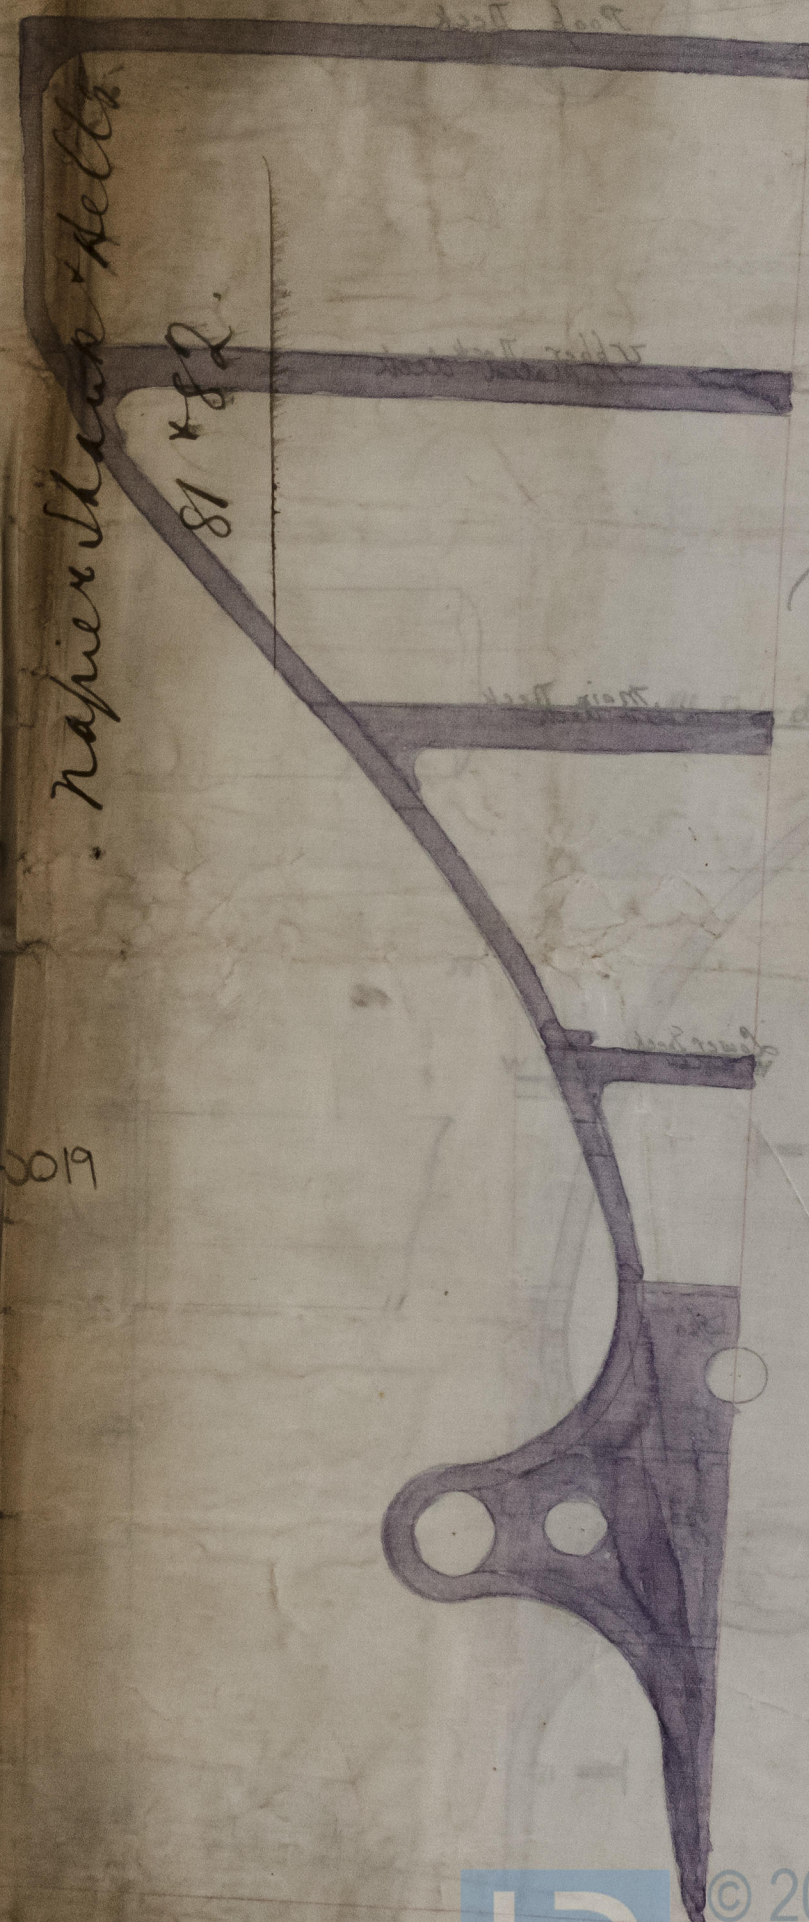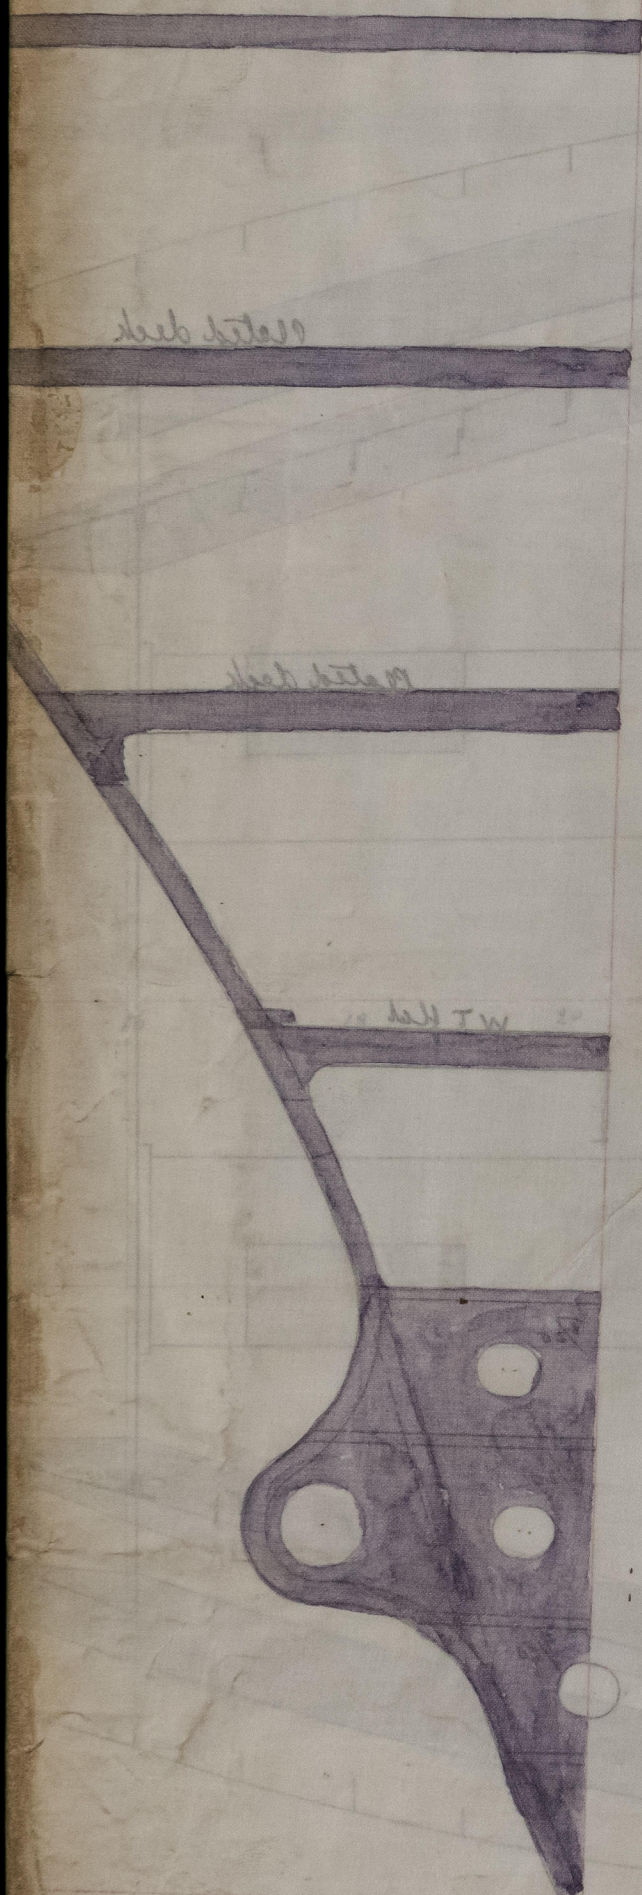

Napier & Shanks & Co.

81 x 82.

GLS2610019

