


6227

RECEIVED
ACKNOWLEDGED
ANSWERED

10 AUG 96


8.8.96
"L"

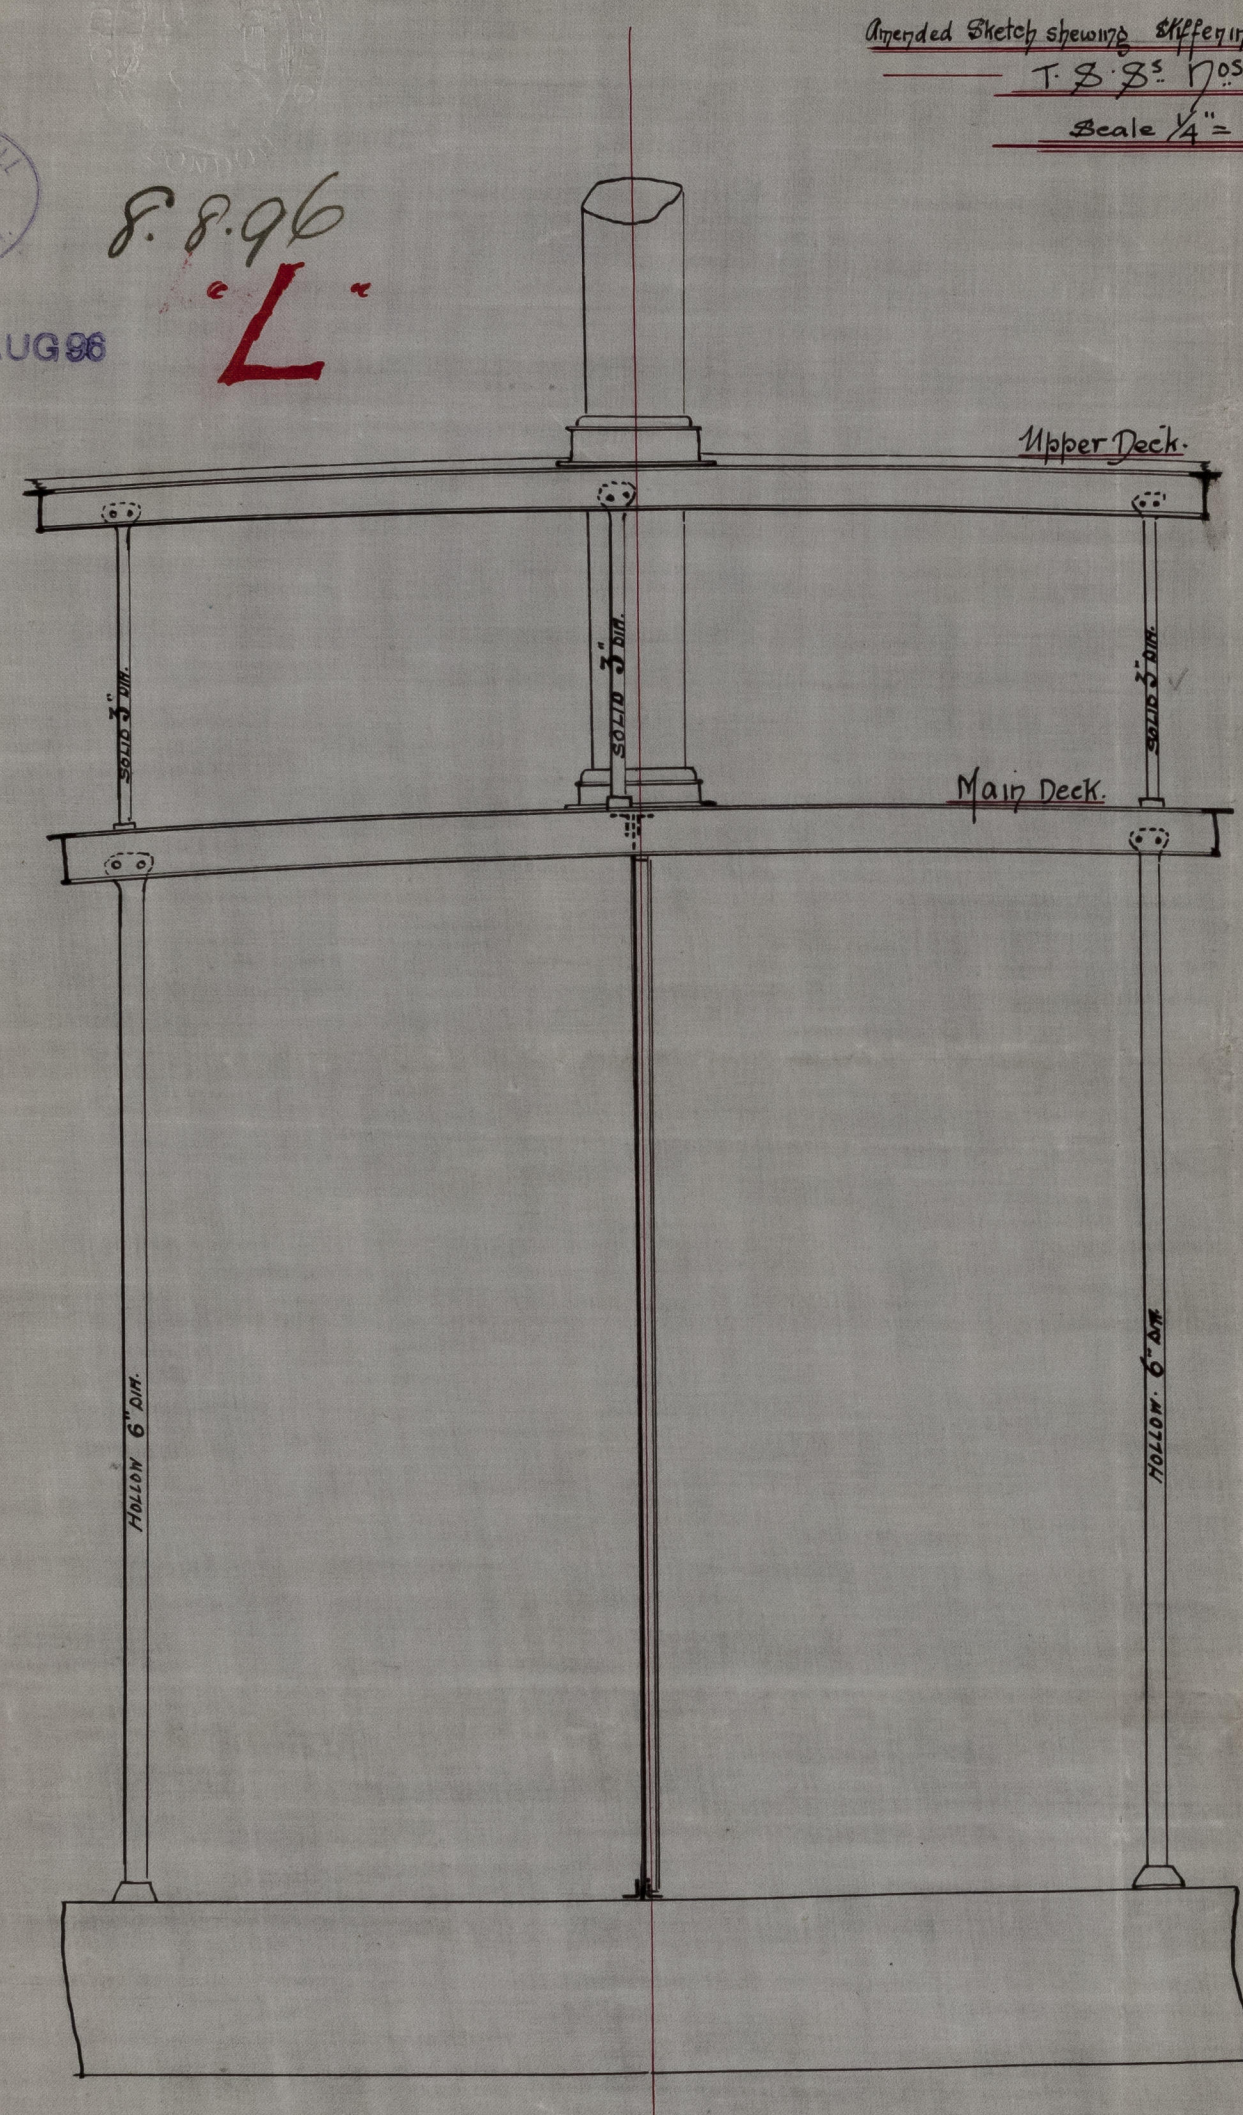

Amended sketch showing stiffening under Fore Mast step
T.S.S. Nos 81 & 82
Scale 1/4" = 1 Foot



RECEIVED
ACKNOWLEDGED
ANSWERED

8/16
web and
4 x 4 x 1/2" angles
in way of heavy
derrick:
(as approved
in sister vessel)

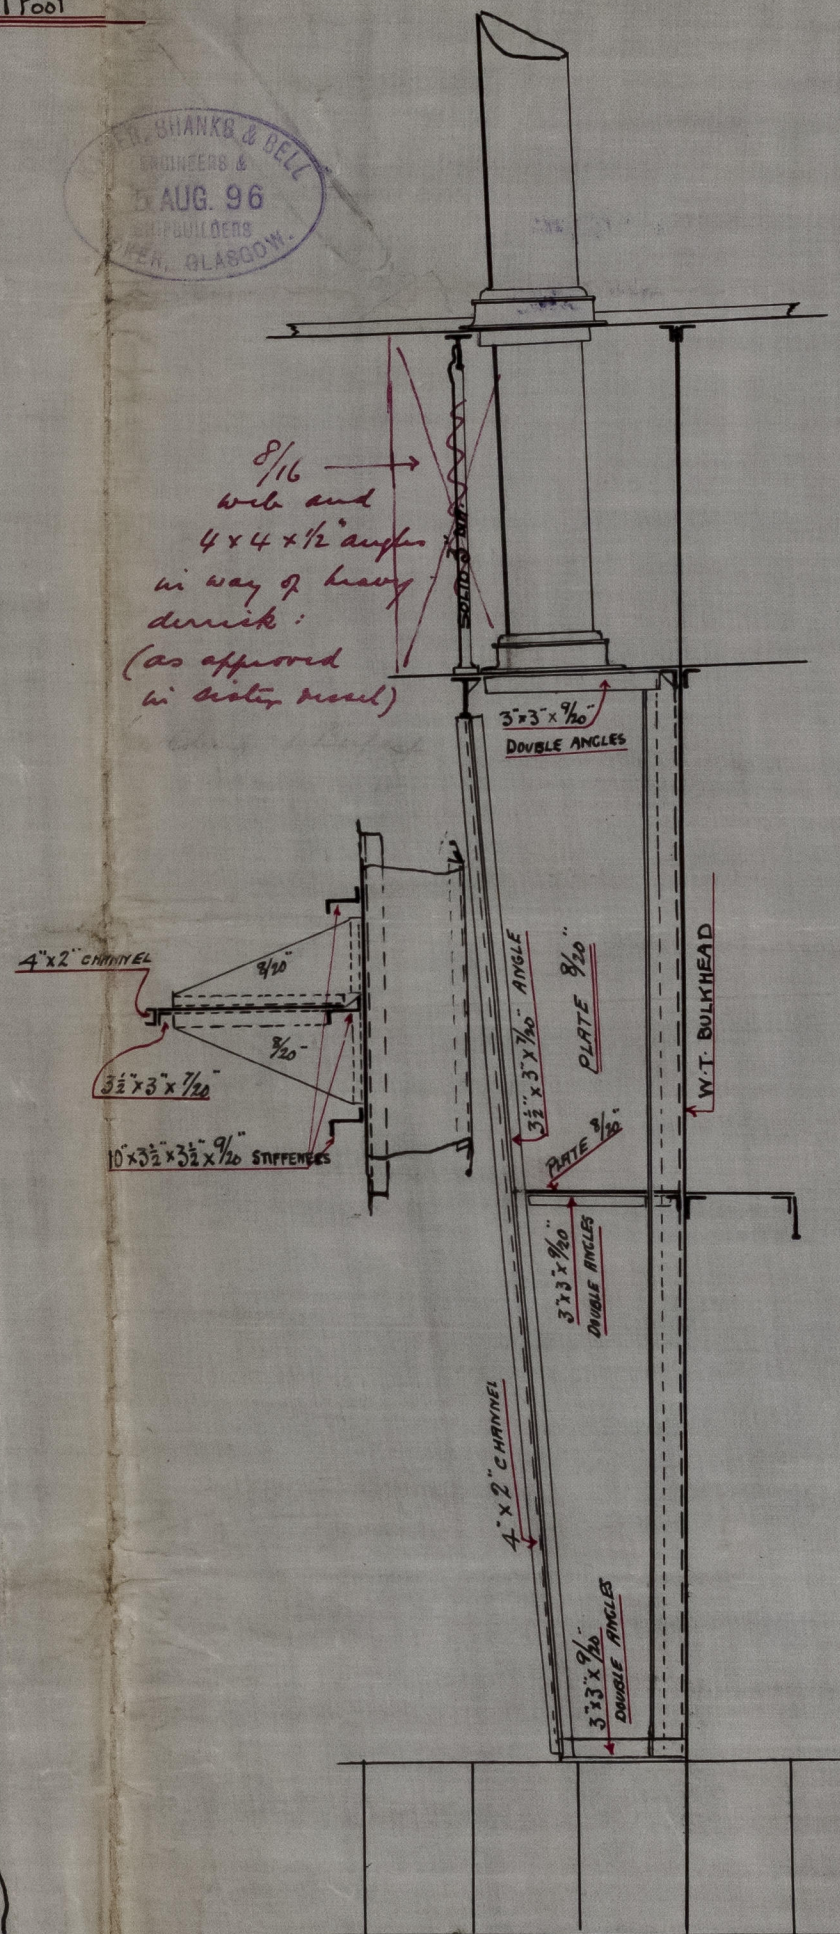


J.P.L.
8/8/96

S.S. "Kawachi Maru" Glasgow Report No. 15122
 S.S. "Sanuki Maru" — do — 13296.

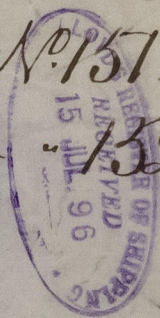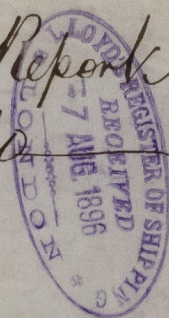

GLS261-0025

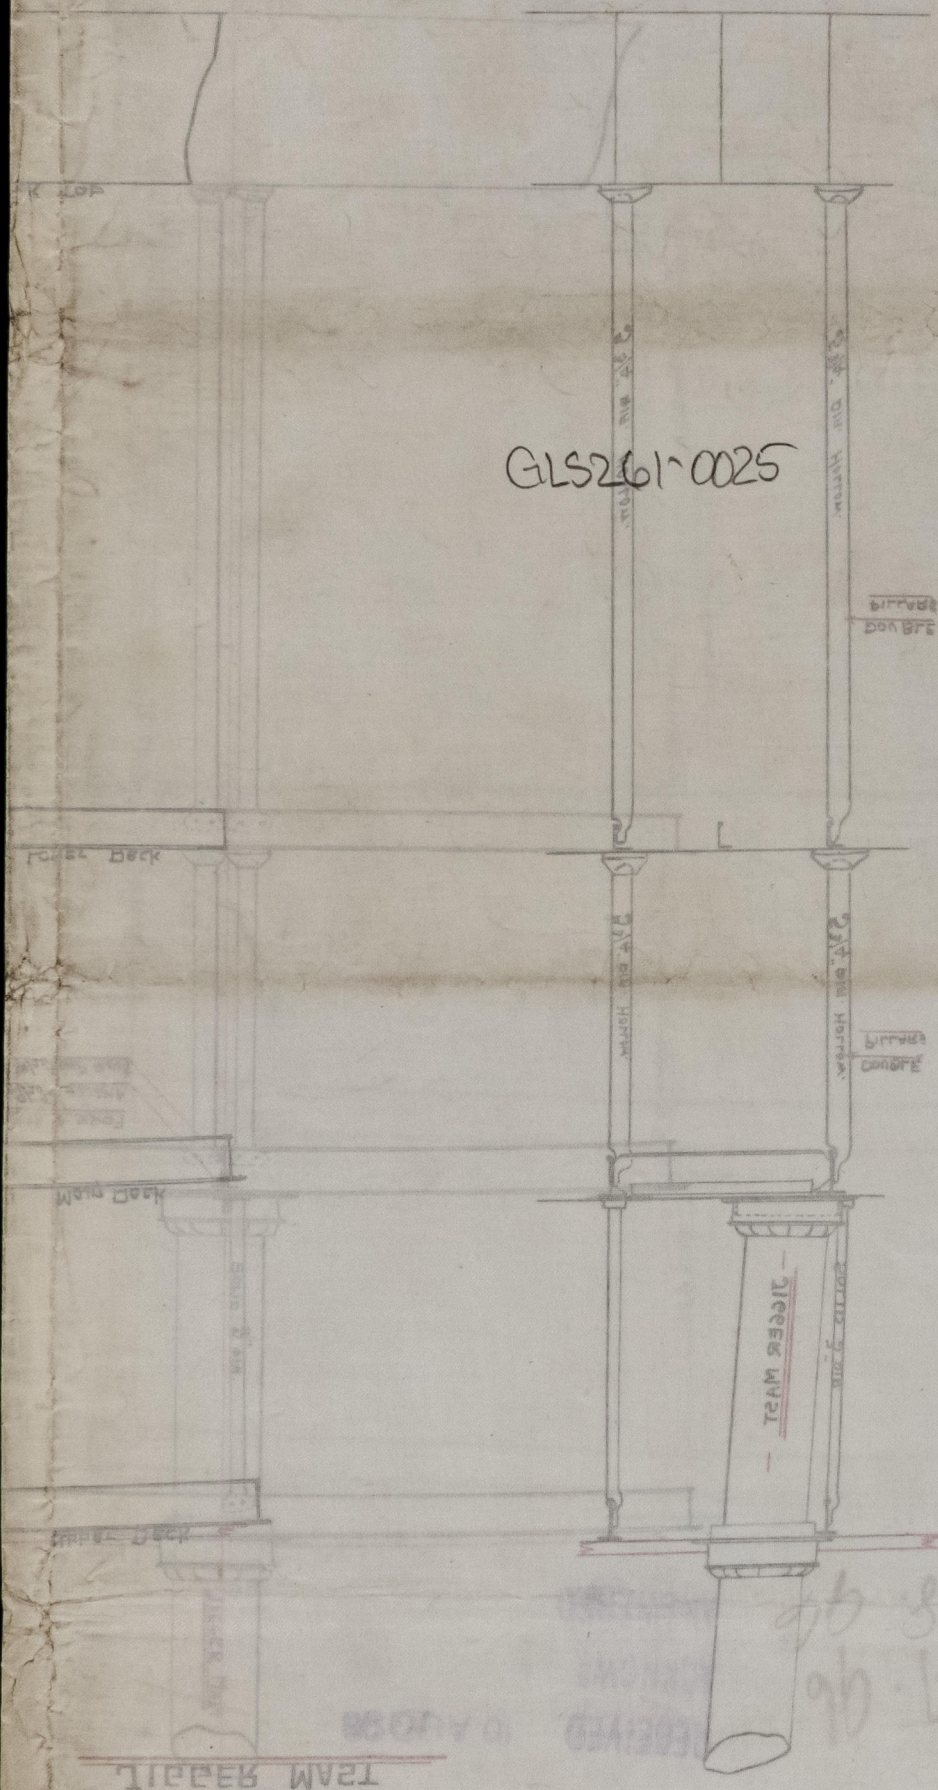

© 2021
 Lloyd's Register
 Foundation