


6097



9.5.96

MAIN DECK PLAN N^{os} 81 & 82

Scale $\frac{3}{8}$ in = 1 Foot

 

Handwritten note: 110'-0" length


Handwritten note: 110'-0" length



Handwritten signature: J.H.L. 9/5/96

GLS261-0029

S.S. Hawachi Maru "Glasgow Report 1529"
 S.S. Sanuki Maru "do" 1529

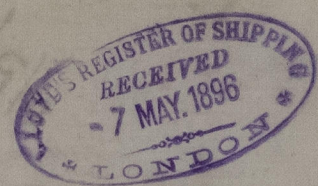

Hapier, Shanks
Hell's 87 + 82.

GL5261-0029

MAIN DECK PLAN