


19.11.96
4.12.96
15.12.96
21.12.96

S. S. "Oranmore"

Scale 1" = one foot

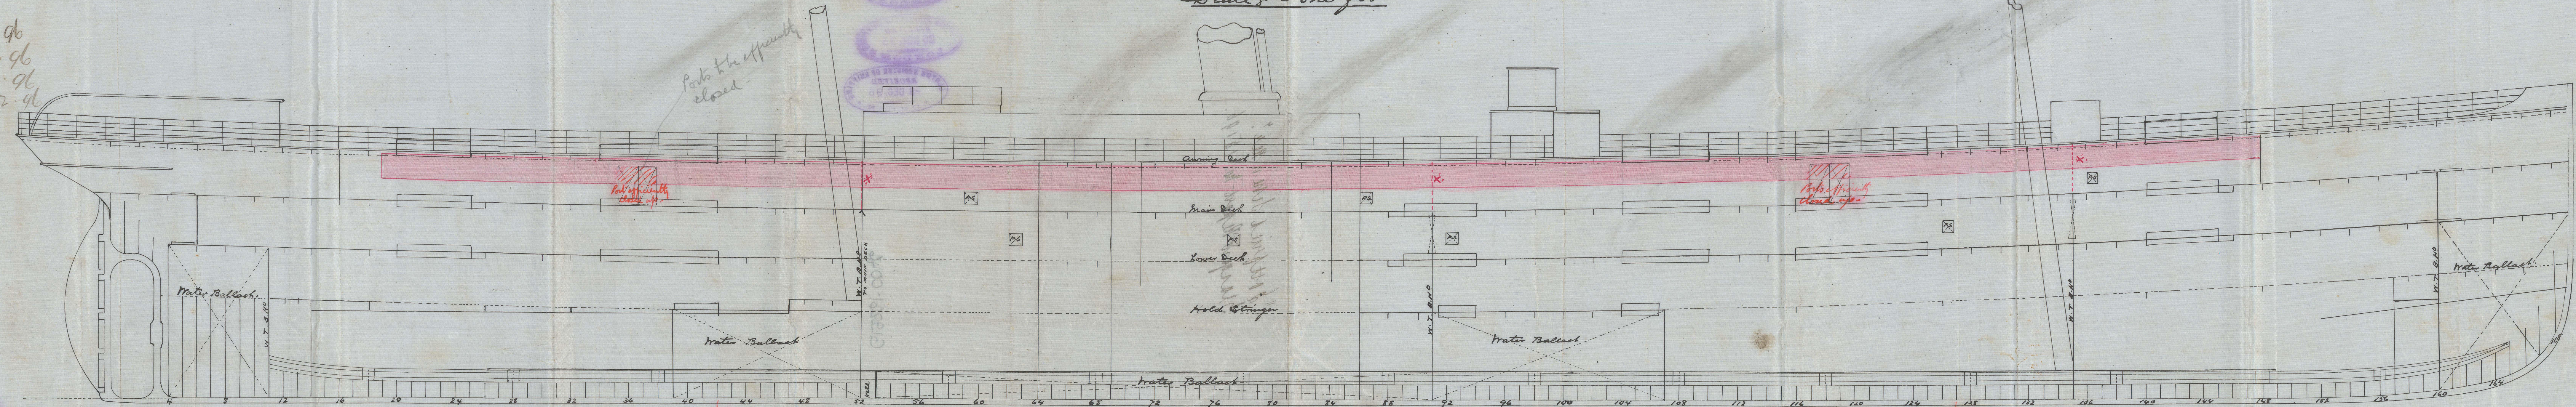

Proposed additions to scantlings with a view to reducing freeboard.
Airming 8" Sheerstrake to be ~~carried up~~ as tinted red, for scantlings see Section
Bulkheads at places marked * to be carried up to Airming Deck, for scantlings see Section
Taken off and renewed with $\frac{15-12}{16}$ plates for $\frac{3}{4}$ length of vessel.



© 2021


Lloyd's Register Foundation

"Gottfried Schenker"
Glasgow Report No. 15196.

Glasgow
18 Dec 96

[Faint red handwritten text, possibly a list or notes, partially obscured by a red vertical strip.]

GLS261-0046

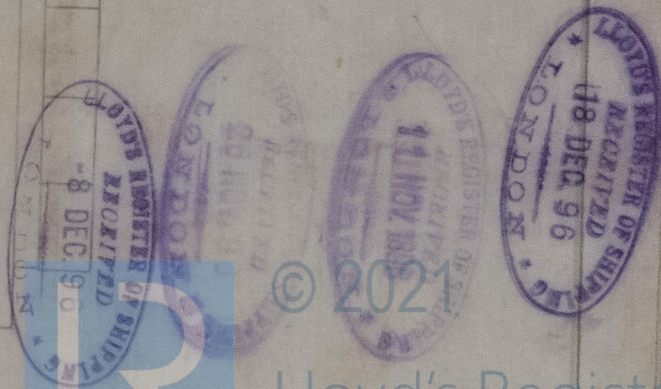

© 2021

Lloyd's Register
Foundation