

19.11.96
4.12.96
15.12.96
21.12.96


Midship Section

S. S. "Orammore"

To Class 100 A.I. at Lloyd's Register D. Rules
With Foreboard

Scale 1/2 inch = one foot

Dimensions Feet
Length as per Rule = 338.5
Half Moulded Breadth = 19.91
Depth Top of Keel to Main Deck = 26.41
Half Moulded Depth = 43.00

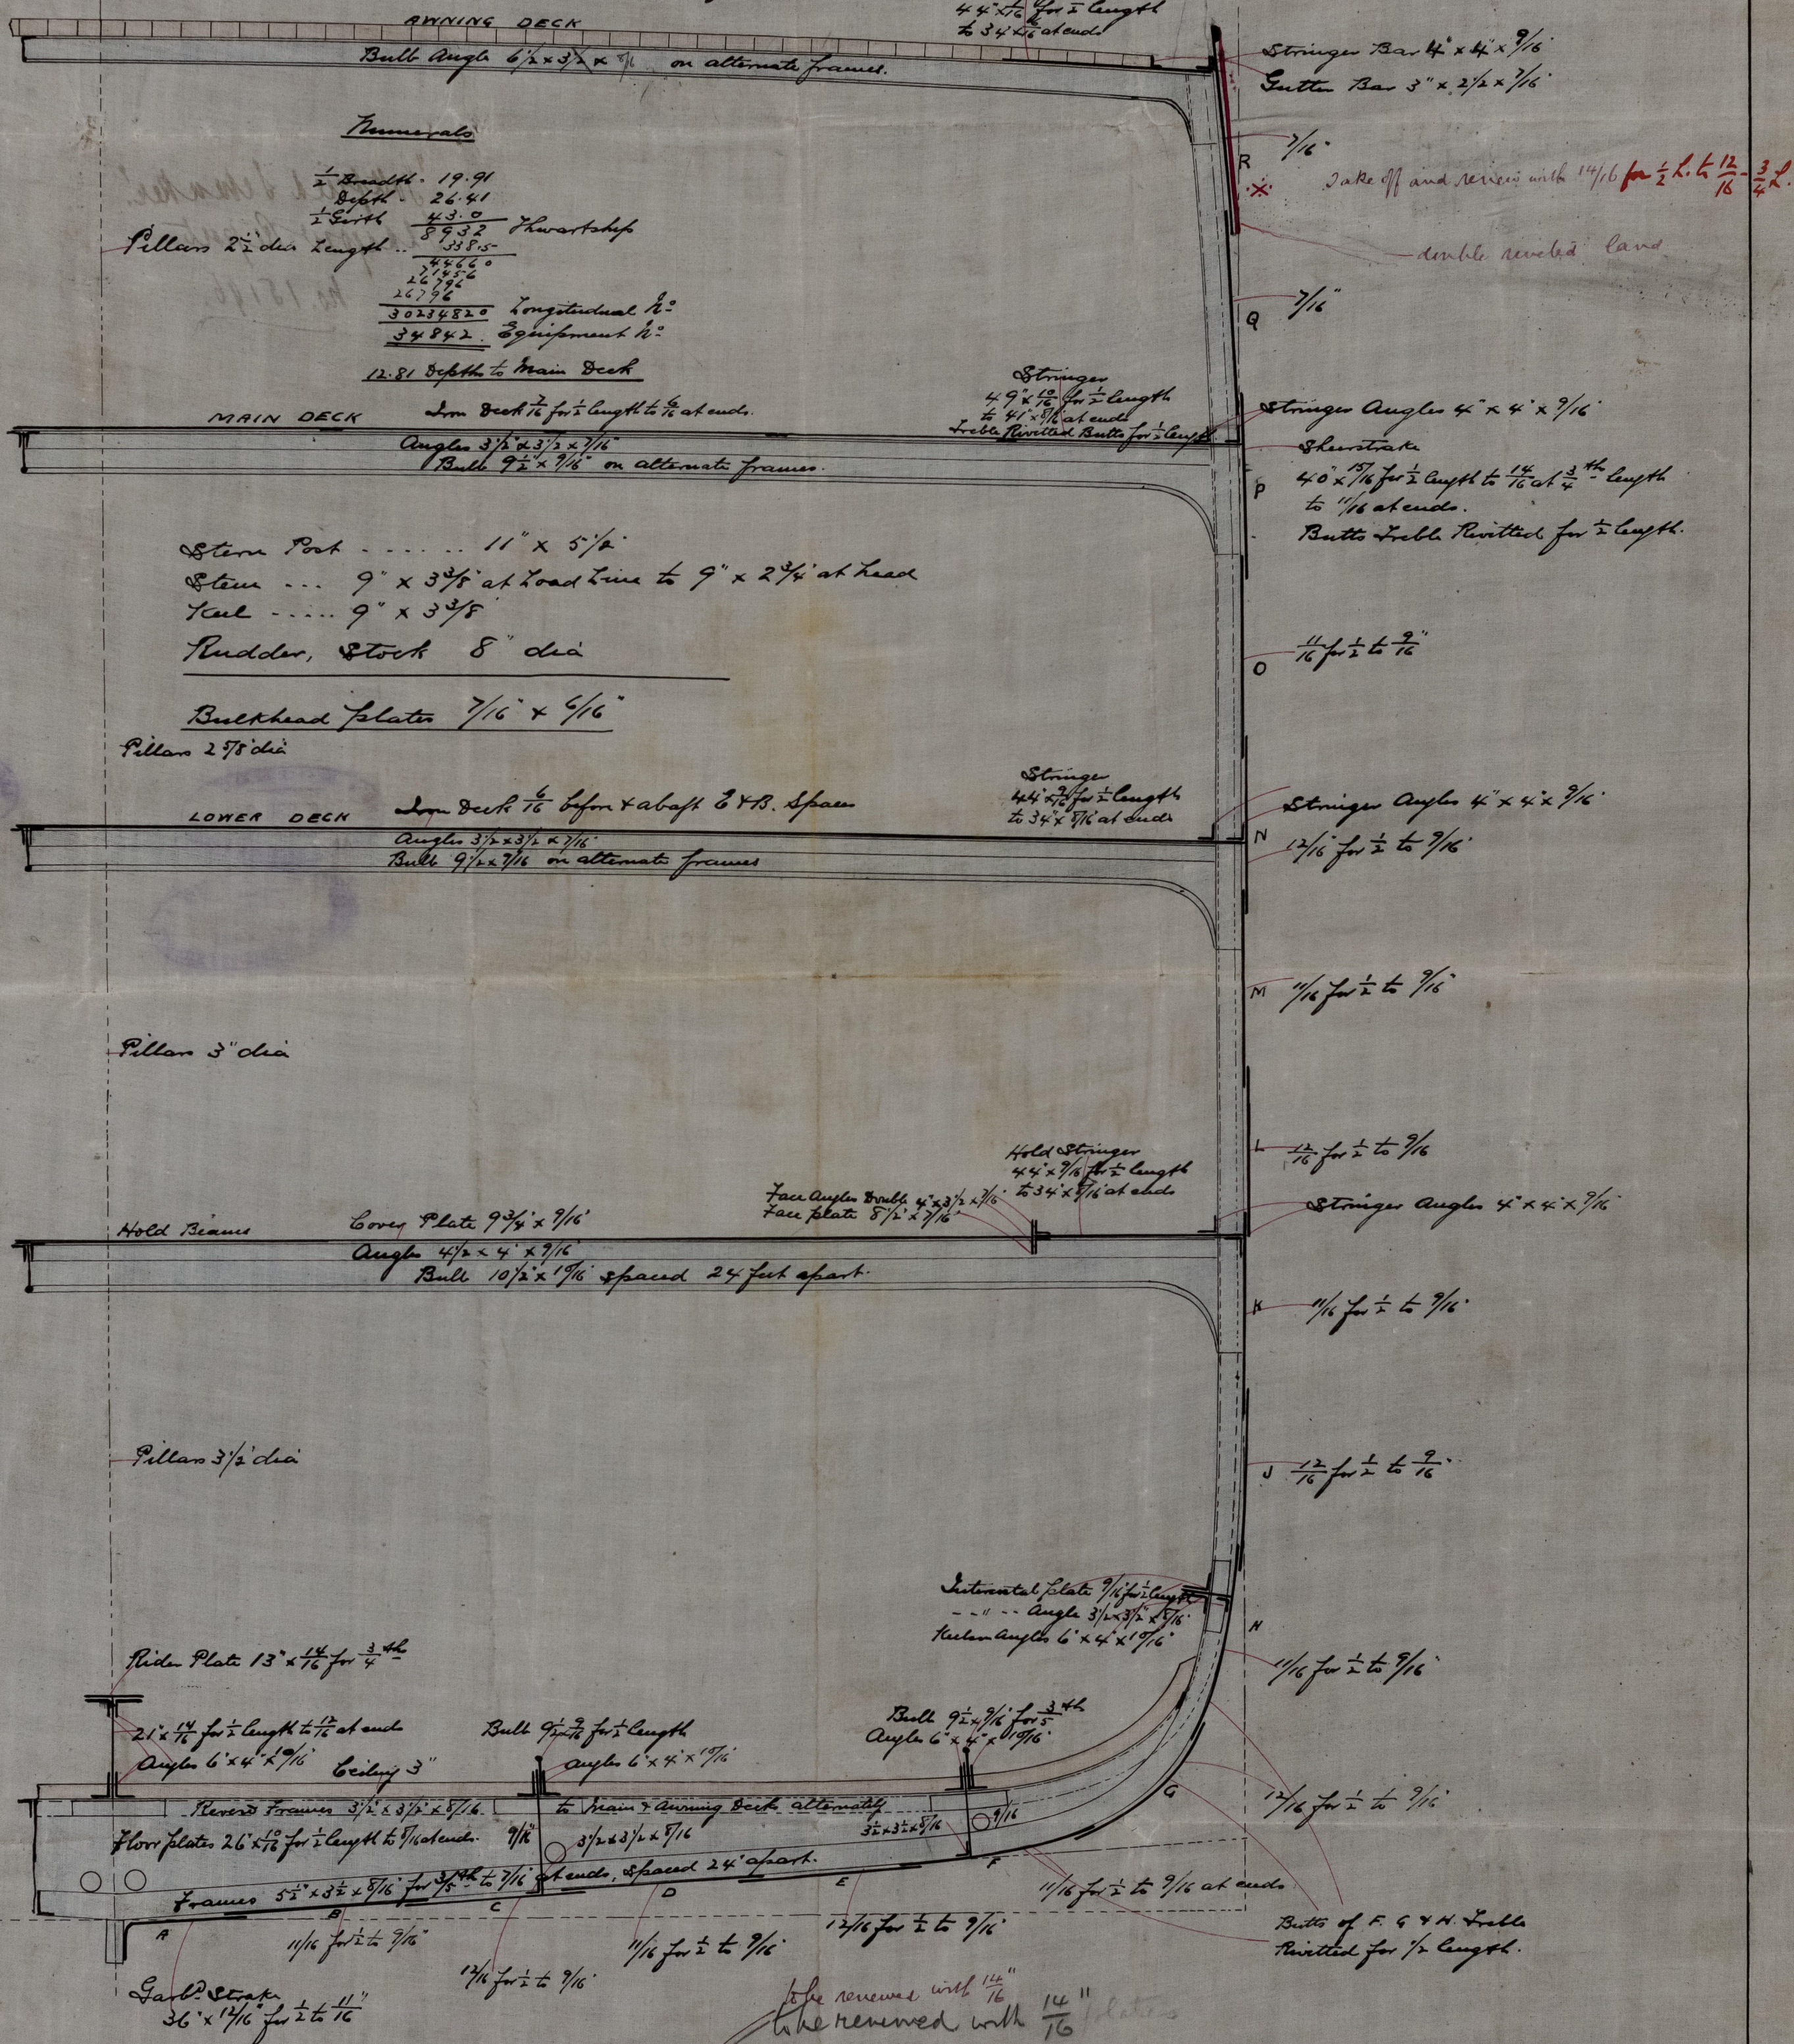

* Proposed additions to scantlings with a view to reducing Foreboard
R Strake marked * to be doubled with 3/4" x 3/4" steel plate for about 3/4" length, as shown in Section and Profile; Butts to be rivetted with straps 1/2" thick than plates.
The present Rivets through frame and plates to be cut out and re rivetted through both old and new plates and frame.
All Bulkheads to be carried up to Anning Deck, to be of 3/8" Steel Plate, with vertical stiffeners 3/2" x 3/2" x 5/16" spaced 30" apart.

Wichitk Section
2 & 3


MAIN DECK

"Gottfried Schenker"
 Glasgow Report
 no. 15196.


MAIN DECK

11" x 2 1/2"
 9" x 3 1/2"
 8" dia


MAIN DECK

RECEIVED
 18 DEC 96

LONDON
 18 DEC 96



© 2021
 Lloyd's Register
 Foundation

GLS261-0047