

3. 11. 96

MAST PLAN

S.S. N^o 396-7-8

SCALE 1/4" = 1 FOOT.



MAIN MAST.

Length from Centre Keelson to Topmast Head 143'-0"
 " " " " to Hounds 96'-0"
 " " Upper Deck to Hounds 65'-0"

Diameter & Thickness.



At Main deck	24 1/2" x 5/16"
" Upper "	25 1/2" x 5/16"
" Hounds "	19" x 5/16"
" Head "	8" x 5/16"

FORE MAST.

Length from Centre Keelson to Topmast Head 140'-6"
 " " " " to Hound 95'-6"
 " " Upper Deck to Hound 62'-0"

Diameter & Thickness.

At Main deck	26" x 5/16"
" Upper "	27" x 5/16"
" Hounds "	20" x 5/16"
" Head "	8" x 5/16"

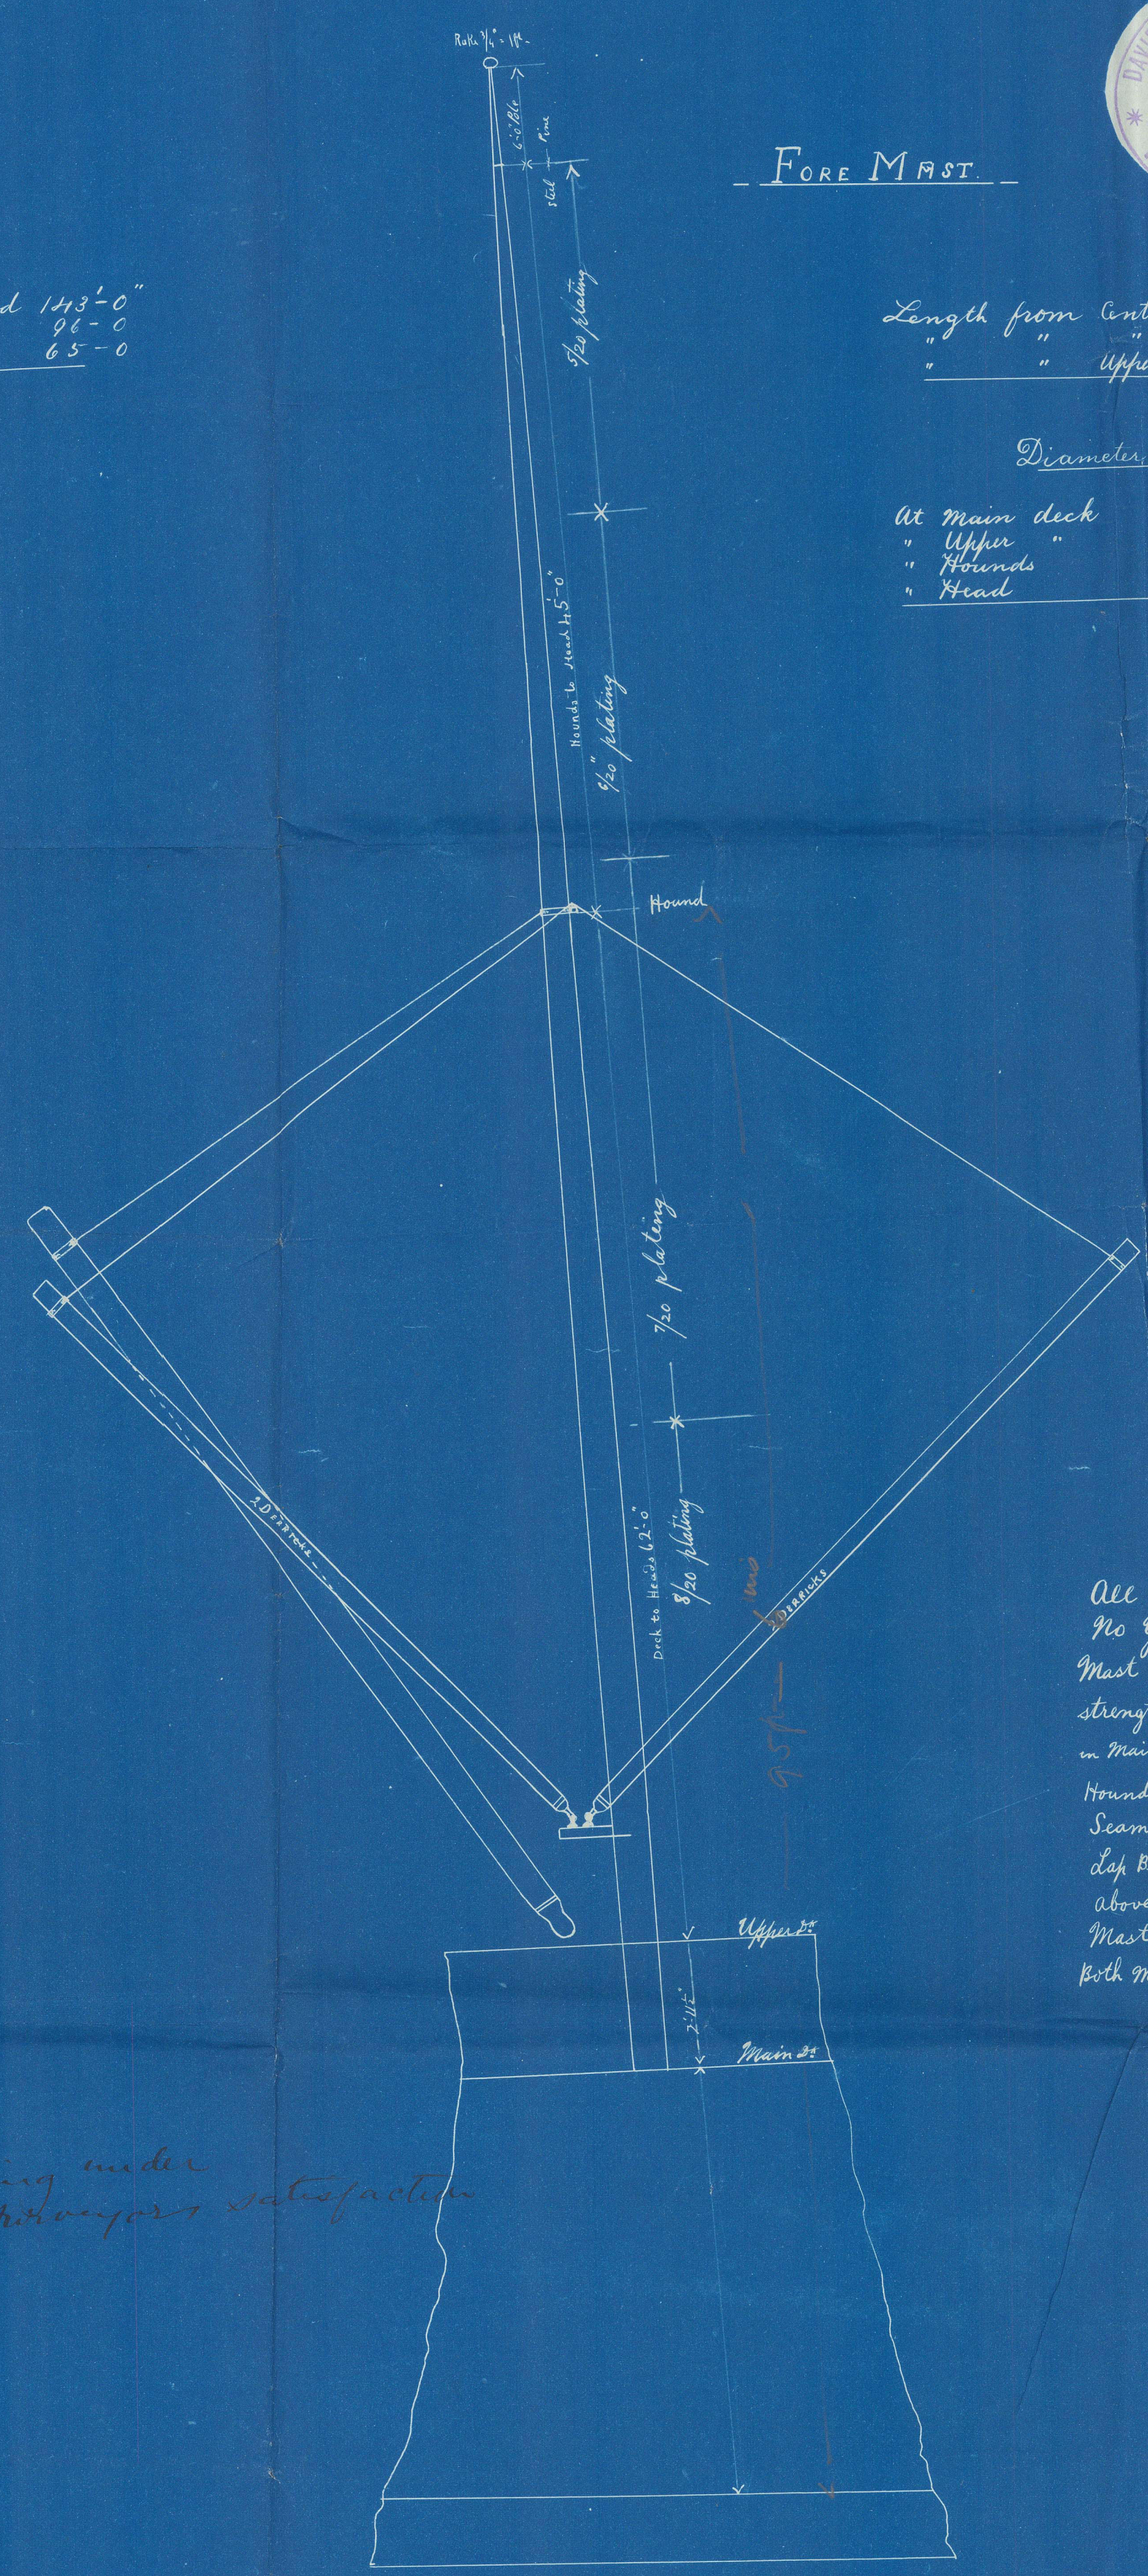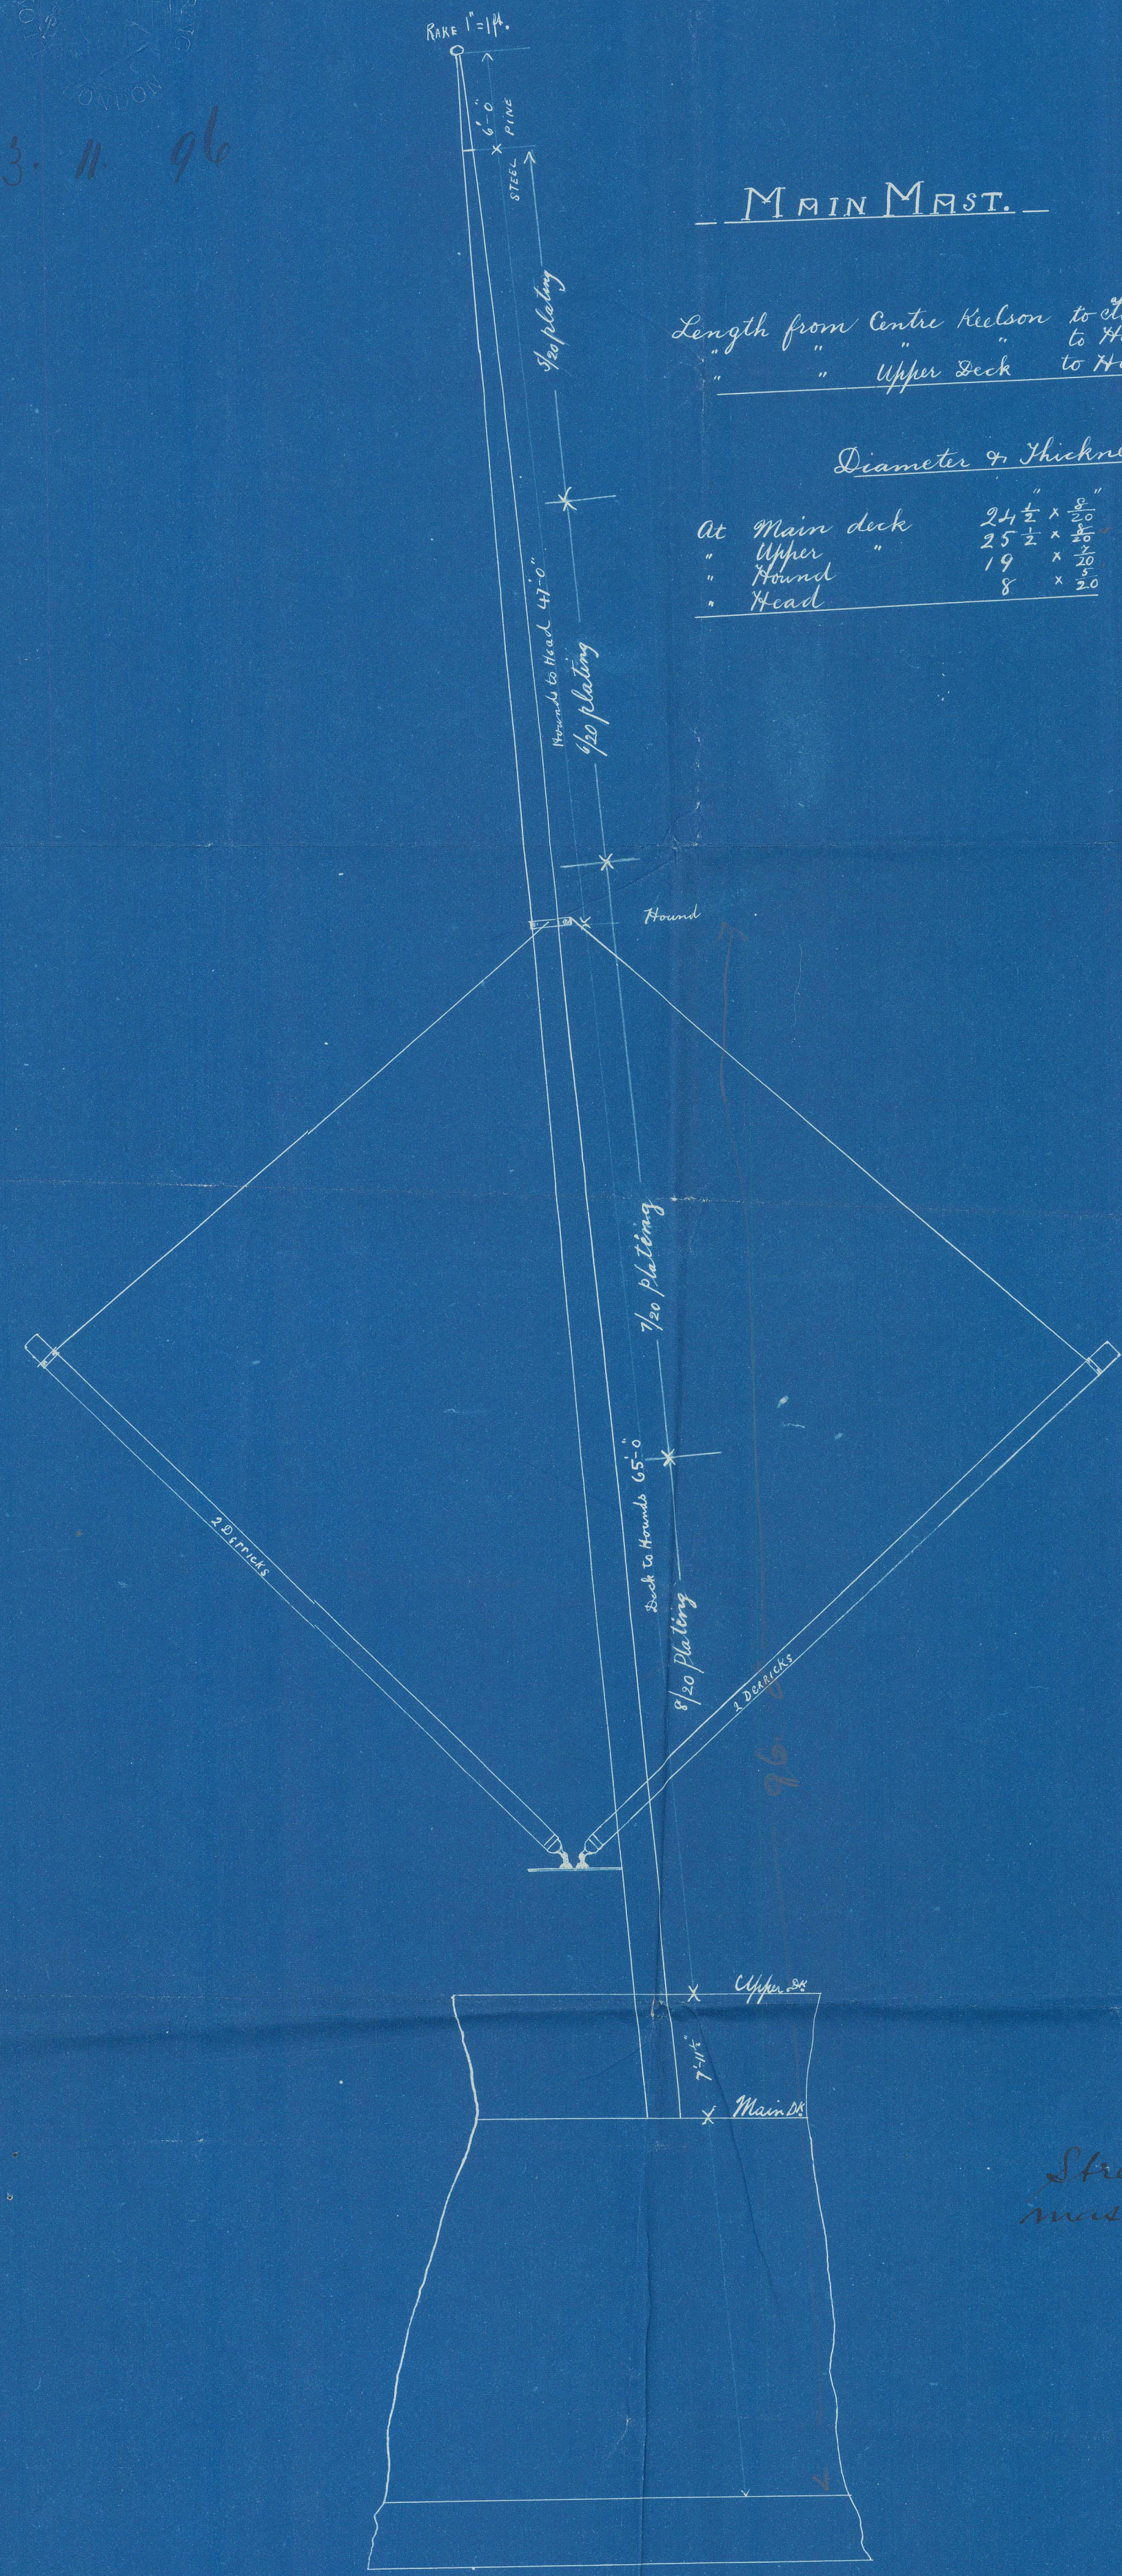

NOTES


All masts wedged at upper end.
 No grids on masts.
 Mast built with 2 plates in the circle and extra strengthened with 3 angles 3 x 3 x 1/2" in fore mast, and 3 x 3 x 2" in main mast, these angles extend from heel to 6'-0" above Hounds.
 Seams single riveted.
 Lap Butts Triple Riveted below Hounds and double Riveted above.
 Mast doubled for 6'-0" at parteners and 9' at Heel.
 Both masts stepped at Main deck.

Strengthening under masts to Portenors satisfaction

17/11/96

GLS261-0054

S.S. "Kanagawa Maru" Glasgow Report No. 14870.
 S.S. "Kakata Maru" — do — " 15019.
 S.S. "Wakasa Maru" — do — " 15163.
 S.S. "Inaba Maru" — do — " 15122.
 S.S. "Bingo Maru" 397. 398 do — " 15666

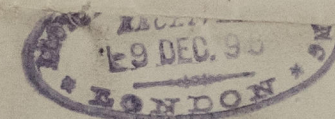

396, 7, 78
(masts)

GLS261-0054



© 2021

Lloyd's Register
Foundation