



SCALE $\frac{1}{2}$ INCH = 1 FOOT

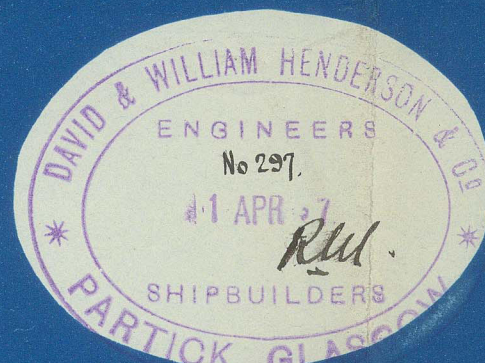

Erections.

$$\begin{array}{r} 113.01 \\ \underline{443} \\ 50063.43 \\ \underline{3178.40} \\ 53241.83 \end{array}$$
 Equipment Number

3" Holes for drainage

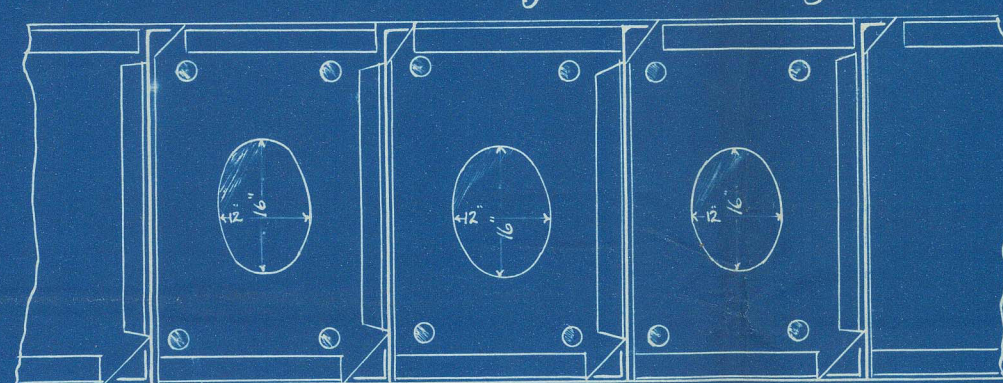

Centre Girders 18" x 20" to 30". Butts trouble
riveted overlaps all fore and aft. 1p Boiler
space $\frac{1}{2}$ 2 ir. p.
Centre Girders to be watertight in E & B.
space where shown on profile

Numerals

$\frac{1}{2}$ Breadth = 24.58
 $\frac{1}{2}$ Girth = 53.91
 Depth = 34.52

$$\begin{array}{r} 7.00 \\ 106.01 \\ \hline 443 \\ 46962.43 \end{array} \quad \begin{array}{l} \text{Frame No} \\ \text{Plating No} \end{array}$$


Pillars $5\frac{3}{4} \times 7\frac{1}{2}$ from Tank top to lower Deck. Pillars between main and lower Decks $3\frac{1}{2}$ solid.

Frames $6\frac{1}{2} \times 3\frac{1}{2} \times \frac{110}{100}$ to form 10 $\frac{1}{2}$ Binder with reverse frames, all frames doubled to Upper Deck abaft after Peak Bulkhead. Frames up both peaks $6\frac{1}{2} \times 3\frac{1}{2}$ only. Frames on web frames to lap 5" only. Rib frames $4\frac{1}{2} \times 3\frac{1}{2}$. Frames with cellular bottom $3\frac{1}{2} \times 3\frac{1}{2} \times \frac{120}{100}$. Frames spaced 3" apart except in fore, and after Peaks which are spaced 2" apart. Frames from 10 to 21 are 158-170 are $6\frac{1}{2} \times 3\frac{1}{2} \times \frac{150}{100}$. Reverse frames of 7' 8 $\frac{1}{2}$ x $\frac{110}{100}$ extending to Upper Deck on every frame with $\frac{1}{2}$ length amidships. Before, and abaft the 4' length to extend to main, and Upper Deck alternately except in way of Torcible where they extend to peak and main Deck alternately. Reverse frames from 10-21, and from 158-179 are $6\frac{1}{2} \times 3\frac{1}{2}$ also in Torcible.

Bulkheads $\frac{8\frac{1}{2}}{20}$, bottom plate $\frac{10}{20}$ instead of brackets to Tank Top. Stiffened vertically by angles $6\frac{1}{2} \times \frac{3}{4}$ spaced 3" apart.

Stiffened horizontally in bulk angles, or collision bulkhead, and all bulkheads exceeding 4'-0" in width, of $8\frac{1}{2} \times 3\frac{1}{2}$ all attached to vessel's sides with brackets. All bulkheads exceeding 5' and under 4'-0" additionally stiffened by a central, vertical, web from Tank Top to top of lower Deck, and BHS, exceeding 4'-0" in width to have 2 vertical webs, stiffened by semi Box Beams.

Connections to Tank Top of $4\frac{1}{2} \times 8\frac{1}{2} \times \frac{10\frac{1}{2}}{20}$ double.

Floors at ends of Vessel $\frac{9\frac{1}{2}}{20}$. Transom $4\frac{1}{2} \times 8\frac{1}{2}$.

Pop, Bridge, and Fore'sie Decks of Tank 5' x 5' Tie Plate 15' x 7' 20"


Bridge Beams of Bulb Tee 8' x 1/2" on alternate frames. Tie Beams of 7' x 3' x 1/2" Bulb Tee Angle on every frame. Pop Beams of Bulb Tee 8' x 1/2" on alternate frames.

Under 40 Feet

Stringer Plate 67' x 1/2" for 1/2 length reduced to 1/2 length for 1/2 length further reduced to 1/2 length for 1/2 length. Butts double overlapped for 1/2 length. Remainder treble Angle 5' x 5' 10' x 1/2" 10' x 1/2" 10' x 1/2"

Double straps treble riveted double riveted landing edge

1/2" in way of Pop, Bridge, + Fore'sie Double Riveted Butts 7/20 Thick

Bulwark 5' steel Butts single riveted.

3' lap

Sh. Strake 6' x 1/2" in place of doubling for 1/2 length, 1/2 for 1/2 length + further reduced to 1/2 at ends. Double Butts treble riveted fore and aft with rivets. Butts outside 1/2, inside 1/2 for 1/2 length remainder per table doubled at ends of Bridge

5' x 1/2" for 1/2 length reduced to 1/2 for 1/2 length, + further reduced to 1/2 at ends. Double Butts treble riveted outer straps 1/2, + inner straps 1/2 with rivets for 1/2 length, remainder per table

15' x 1/2" Butts treble riveted fore, + aft, + 1/2 thicker for 1/2 + 1/2 at ends.

11' x 1/2" Butts treble overlapped

6' lap

Butts treble overlapped

14' x 1/2" Butts treble overlapped

15' x 1/2" Butts treble overlapped

183'

S.S. "Wakasa Maru" Glasgow Report No. 15163

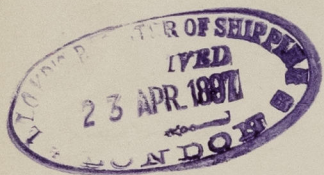

~~For~~ sister vessel to the S.S. "Kanagawa Maru" Gl. 14870

and S.S. "Wakata Maru" Gl. 15019.



© 2021

Lloyd's Register
Foundation

GLS261-0058