



Nº 454

*Ed. 11.96.
14.11.96.
25.11.96.*

Pumping Arrangement
Scale 1/8" = 1' foot

Approximate Under D^g Tonnage 1790

R. NAPIER & SONS, Limited.
Ed. Napier
5/11/96


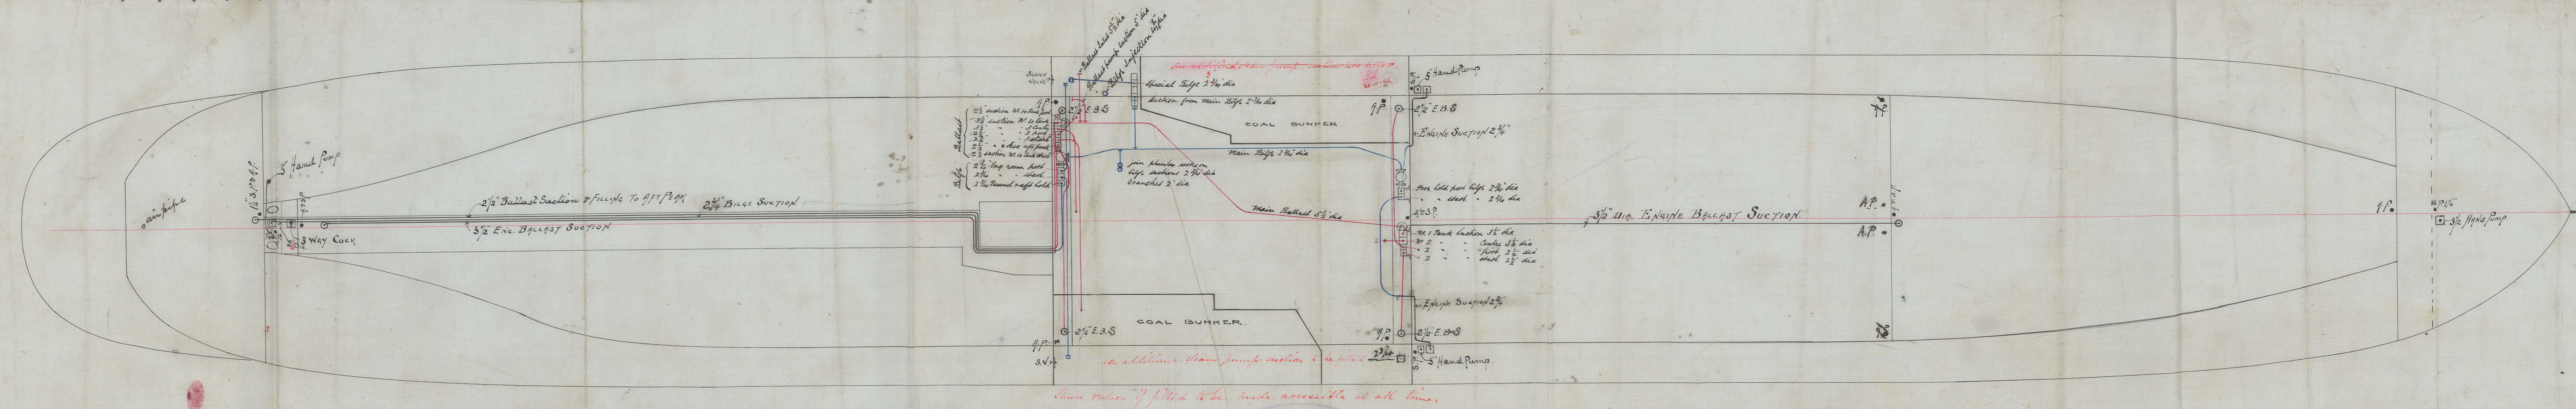
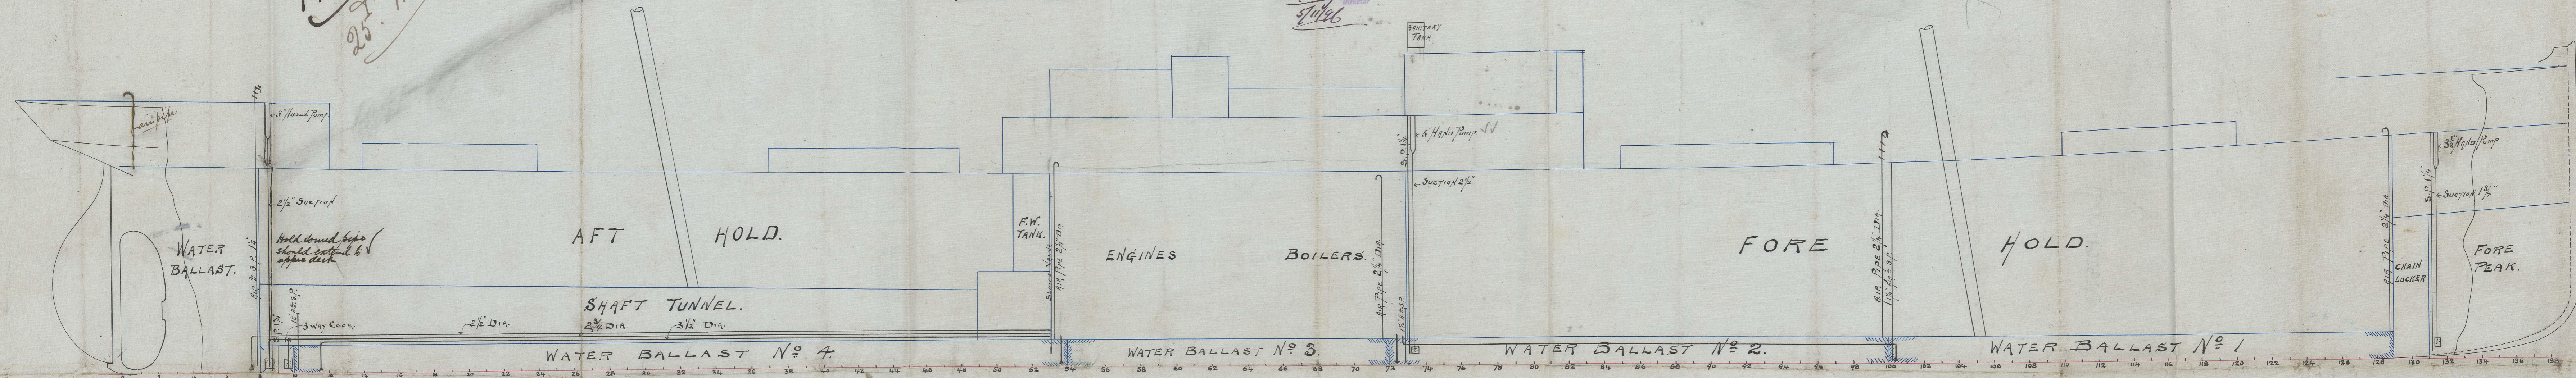


Since valves of fitted to be made accessible at all times.


9

Ed. Napier & Sons, Limited.

S. S. "Nile" Glasgow Report N^o 15265.

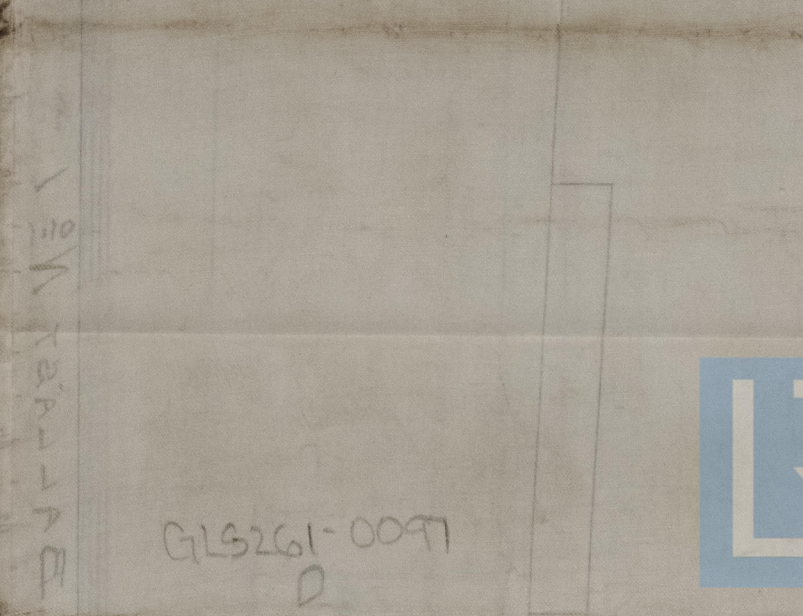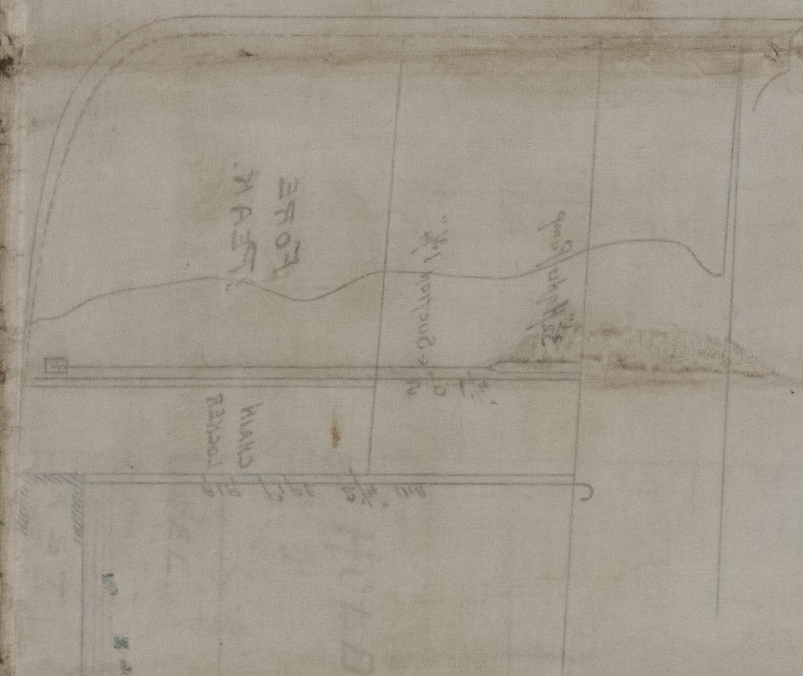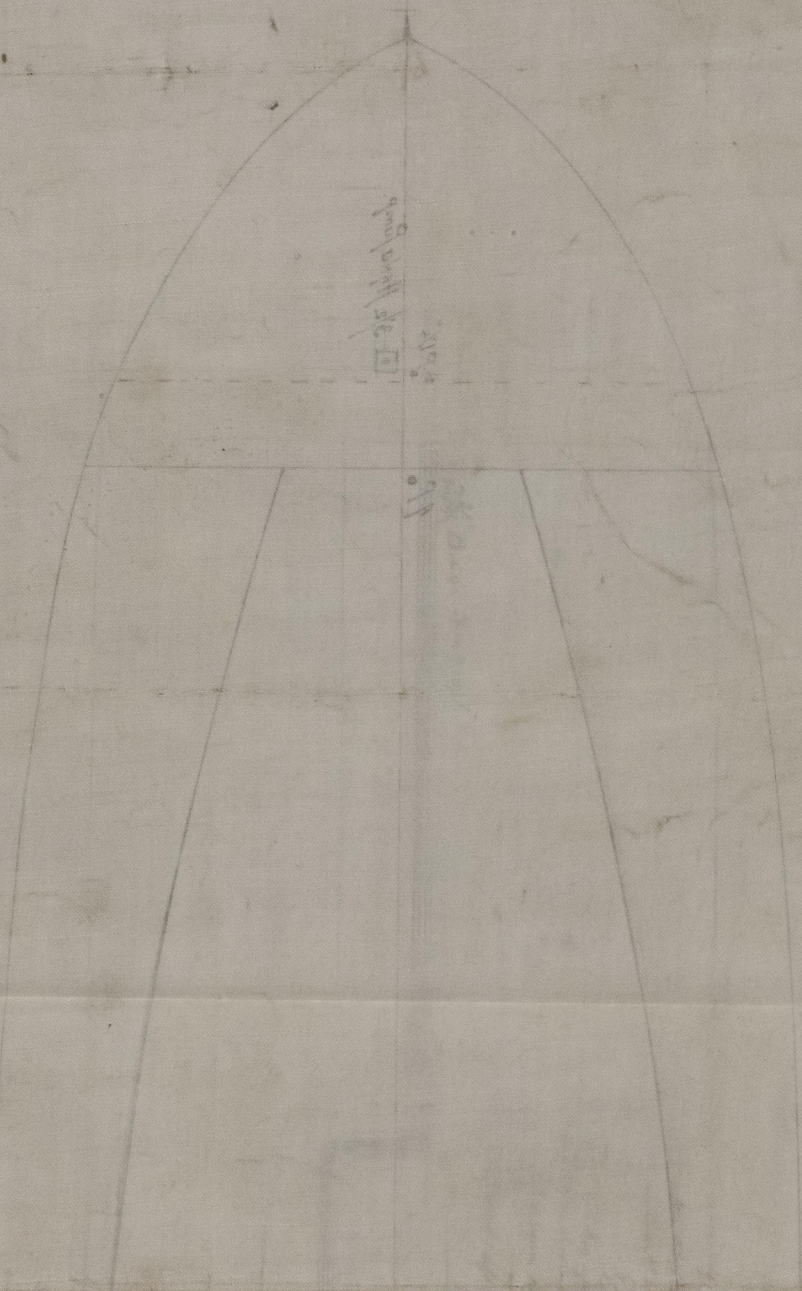

GLS261-0091
D

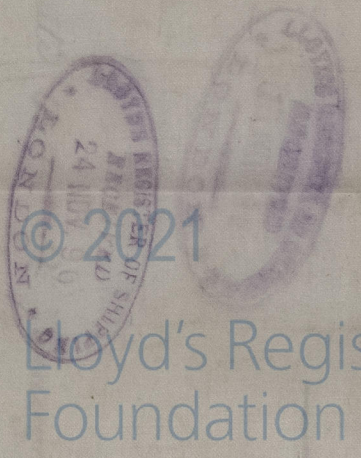

Lloyd's Register
Foundation