

28035  
**No 4-54**


17.10.96

DIMENSIONS OF MASTS.

SCALE  $\frac{1}{16}$ " = ONE FOOT.

R. NAPIER & SONS, Limited.

*W. Napier*  
13/10/96

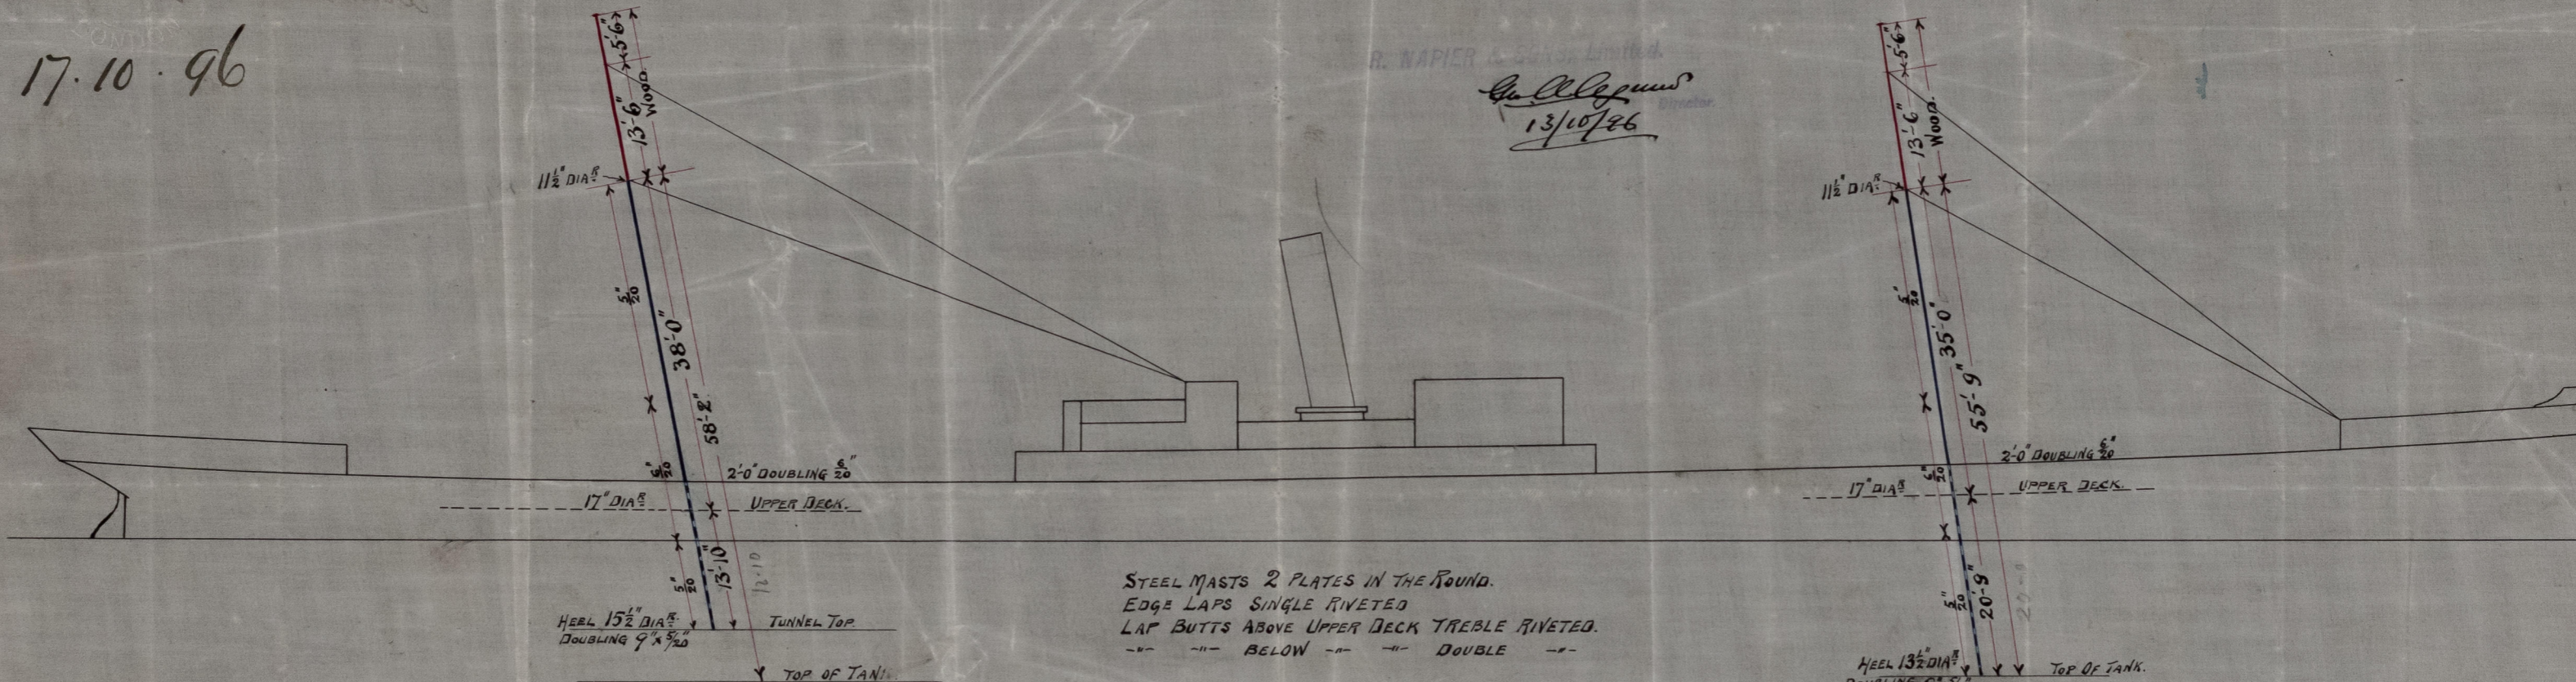

*J.H.*  
17/10/96

GLS261-0098




© 2021

Lloyd's Register  
Foundation

*W. Napier*  
15/10/96

S. S. Nile Glasgow Report No 15265.

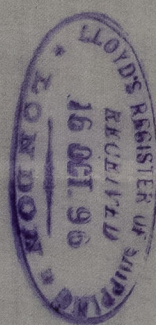


© 2021  
Lloyd's Register  
Foundation

