


GLS261- 0100

S.S. "Vile" Glasgow Report 1892


Midship Section
Reports

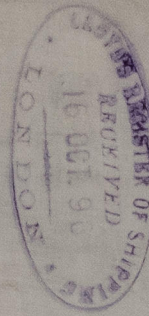

No. 1-2-1

— MIDSHIP SECTION —
— OF A —
STEEL SINGLE SCREW STEAMER
TO CLASS 100A BY LLOYD'S SPECIAL SURVEY
DIMENSIONS 280 x 40 x 21-6

GL261-0100

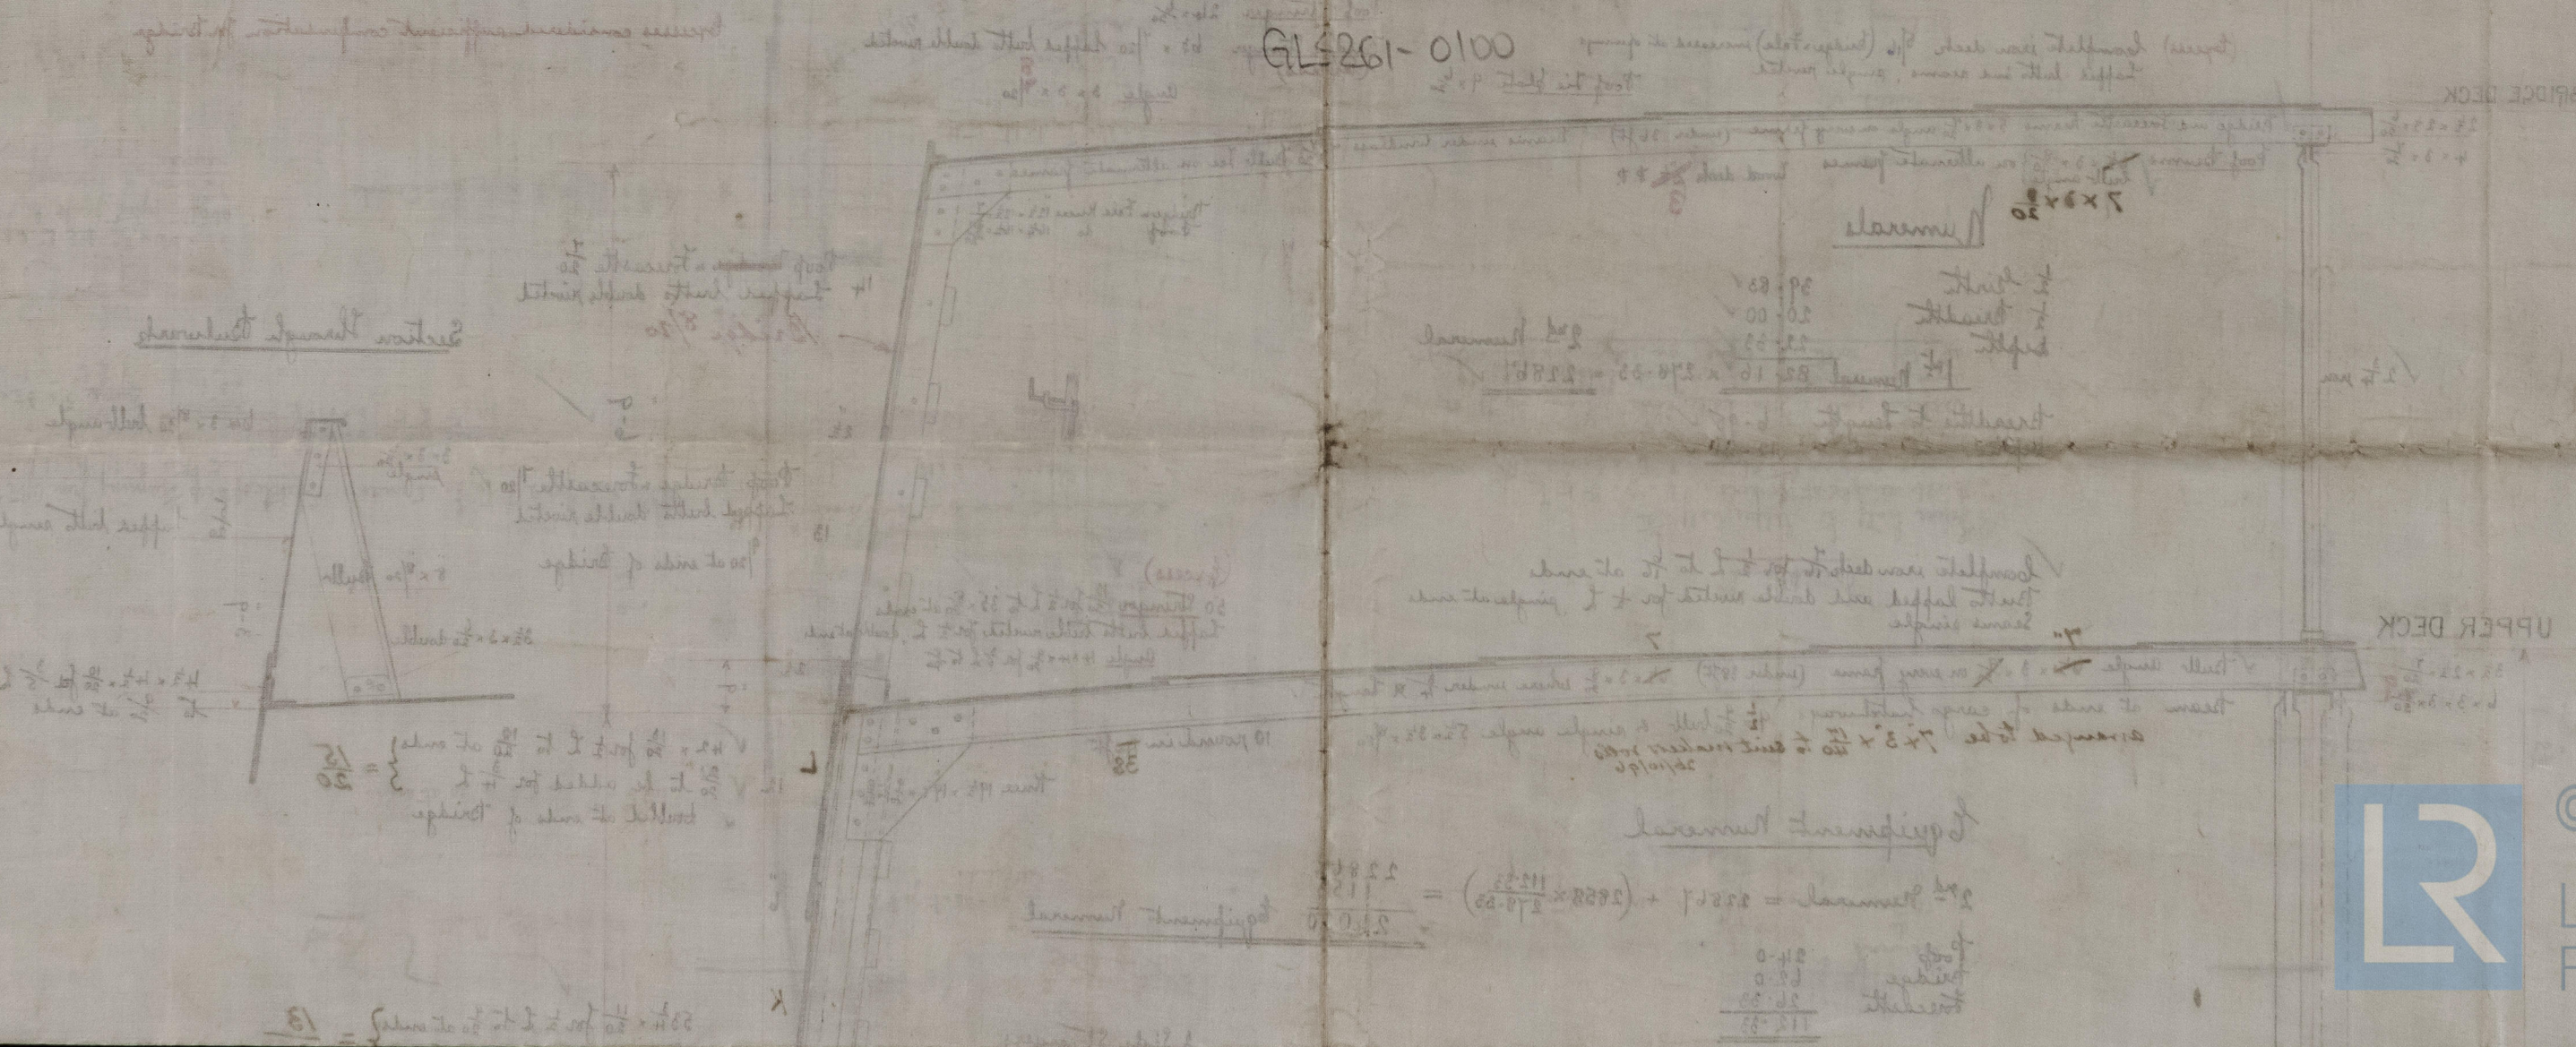

© 2021
Lloyd's Register
Foundation