
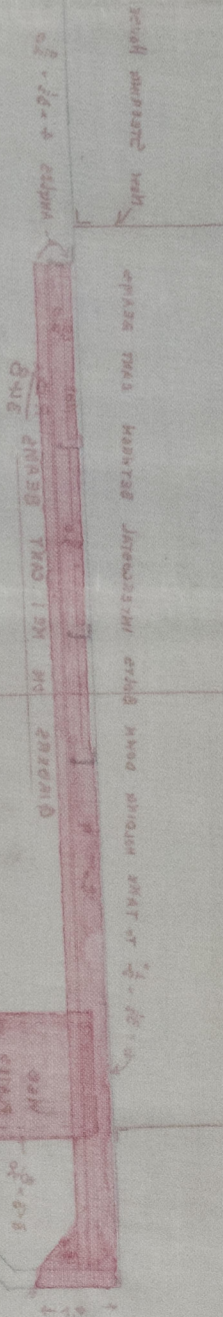
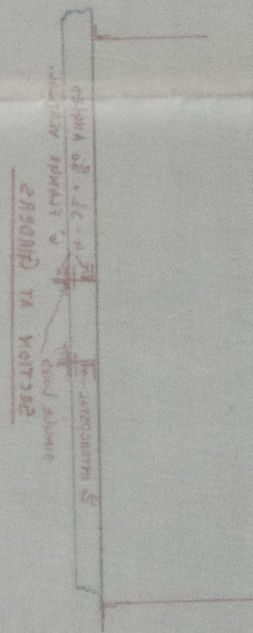


J. J. Maclean
24/5/24

See plan of bridge deck and stern section of ship

S.S. "Dunottar Castle" Glasgow Report 1853 86.

8400-72674

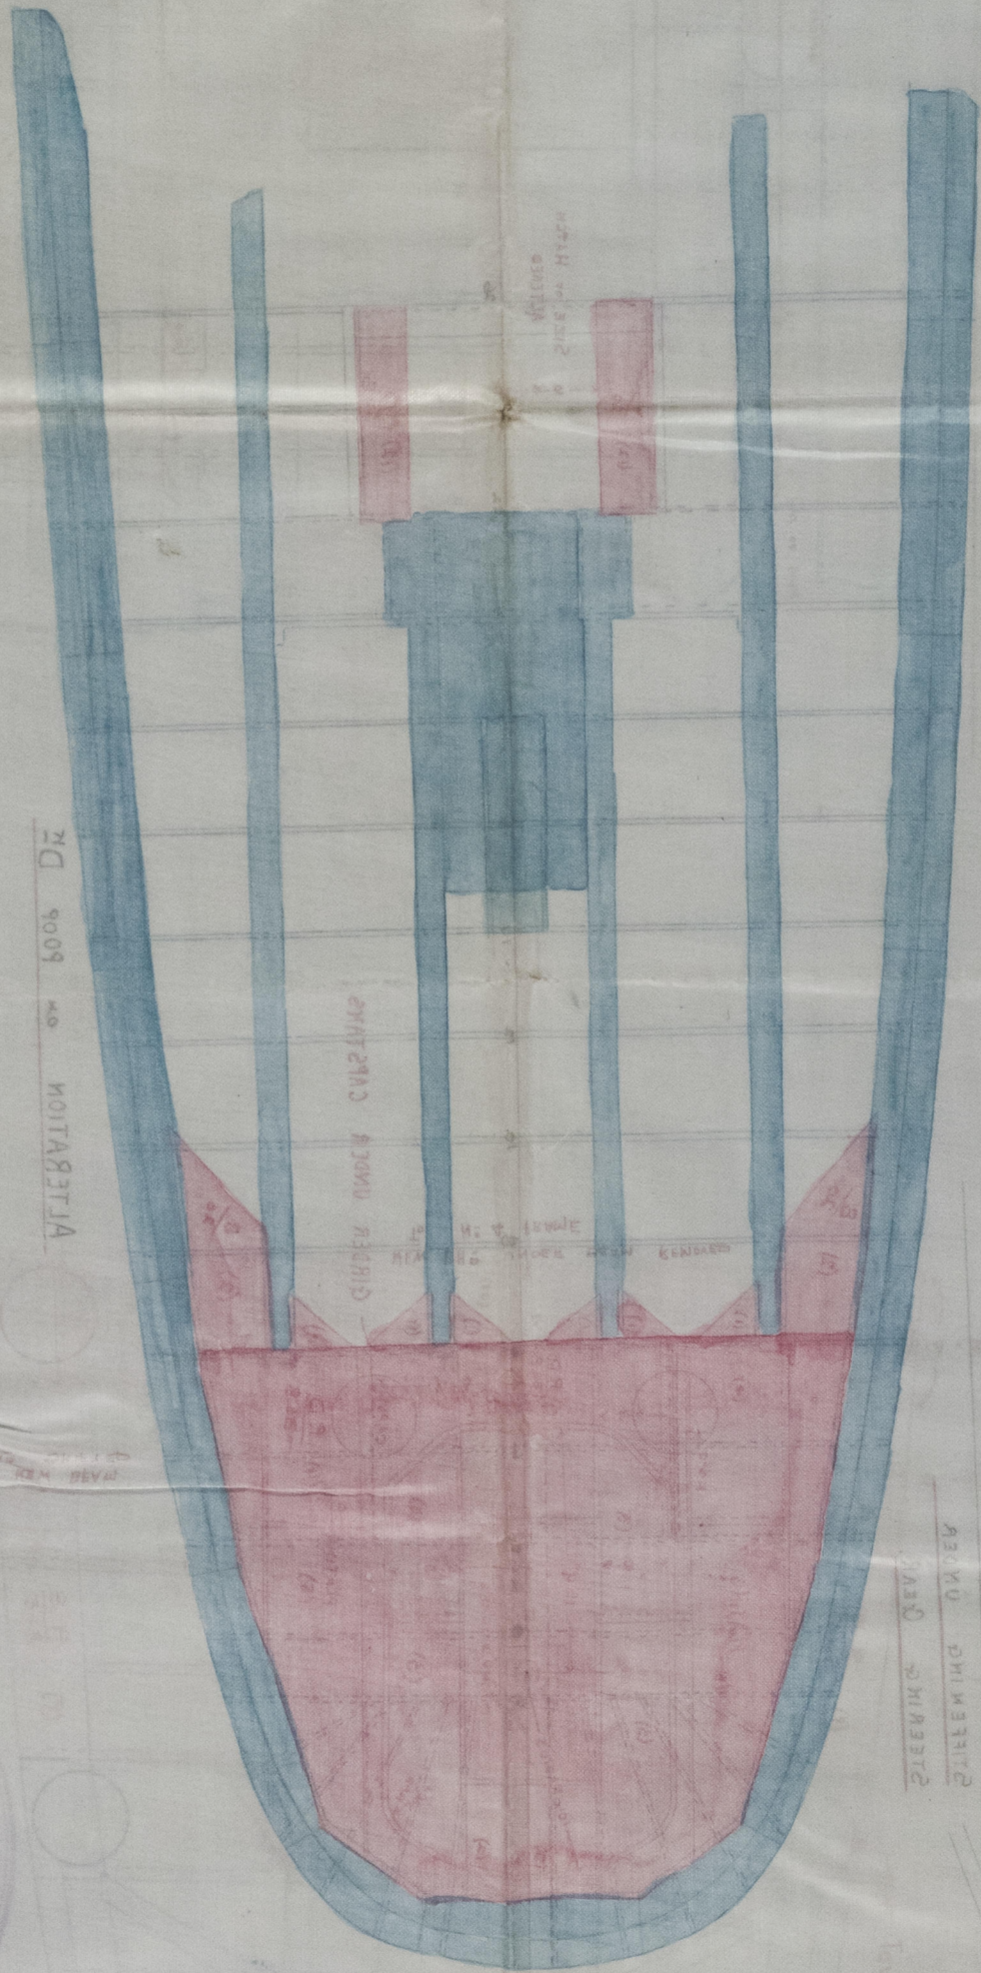

1853
8400-72674