

See R.H.
25:2:97.

D.D. Repairs - Report No. 108 & 9.



SHAFTING ENGS NO 108 & 9.

Scale 1/2" = 1 foot

W.A.D. 25/2/97

J.M. 25/2/97


Ref. 22
25.2.97

 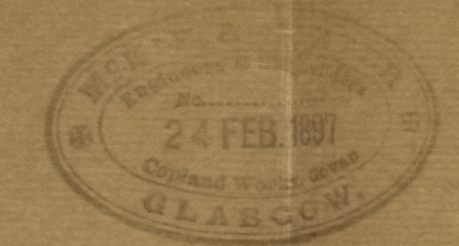

22.2.97. Report 11.11.97


SHAFTING ENGS No 108 & 9.

SCALE 1/2" = 1' 0"

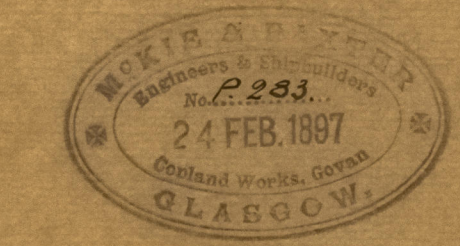


W.L.H. 24.2.97

J.M. 29.2.97

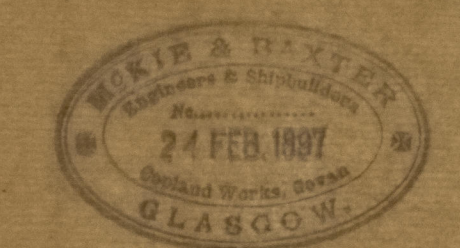

4.5.11.1-1121

Handwritten signature and initials

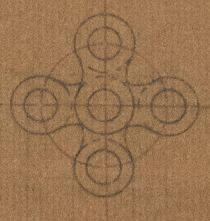

S.S. "Chelucto" - Report N° 15424.

