

Lloyd's Register of British and Foreign Shipping.

(Report on Vessel No. 15427 Port Glasgow)

S.S. "Chebucto"

No. 3647

SHIP FORGINGS OR CASTINGS.

I have to report that the undermentioned Iron or Steel Forgings or Castings, manufactured by Messrs. Emerson Walker & Thompson of Dunston for the Vessel No. 22, being built by Messrs. John Shearer & Sons of Glasgow have been inspected by me as set forth below, and found to be, so far as can be seen, sound

Mark on Forgings.

Lloyd's

No. 6308B

JK

John C Craig

Newcastle

20.5.97

2 ft

2 ft

STERN FRAME.

RUDDER FRAME.

STEM.

Material*

How made

Dimensions

Progress on Inspection

Date when Inspected

Scrap

Forged

6 1/2 - 3 1/4

Forged & Smithed

February 2 to

March 3/97

Scrap

Forged


As per Drawing Attached

Forged & Smithed

March 24 to

April 30/97

SKETCHES OF FRAMES SHOWING POSITION AND DESCRIPTION OF WELDS OF FORGINGS, OR PARTICULARS OF TESTS APPLIED TO CASTINGS.

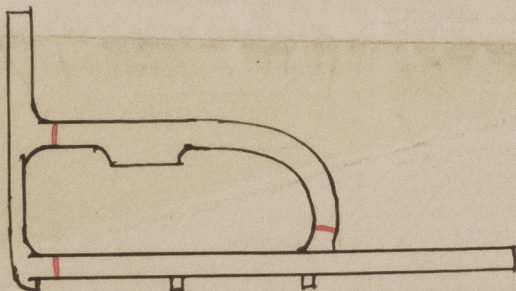

welds

Fee (if any chargeable) £

To be paid at



© 2021

Lloyd's Register
Foundation

* If of Iron, state whether scrap or puddled Iron.