


JOHN SHEARER & SON
SHIPBUILDERS
17/ April/97
Pmc
GLASGOW

*Copy
27.4.97*

JOHN SHEARER & SON
SHIPBUILDERS
DATE
GLASGOW

PUMPING ARRANGEMENT.

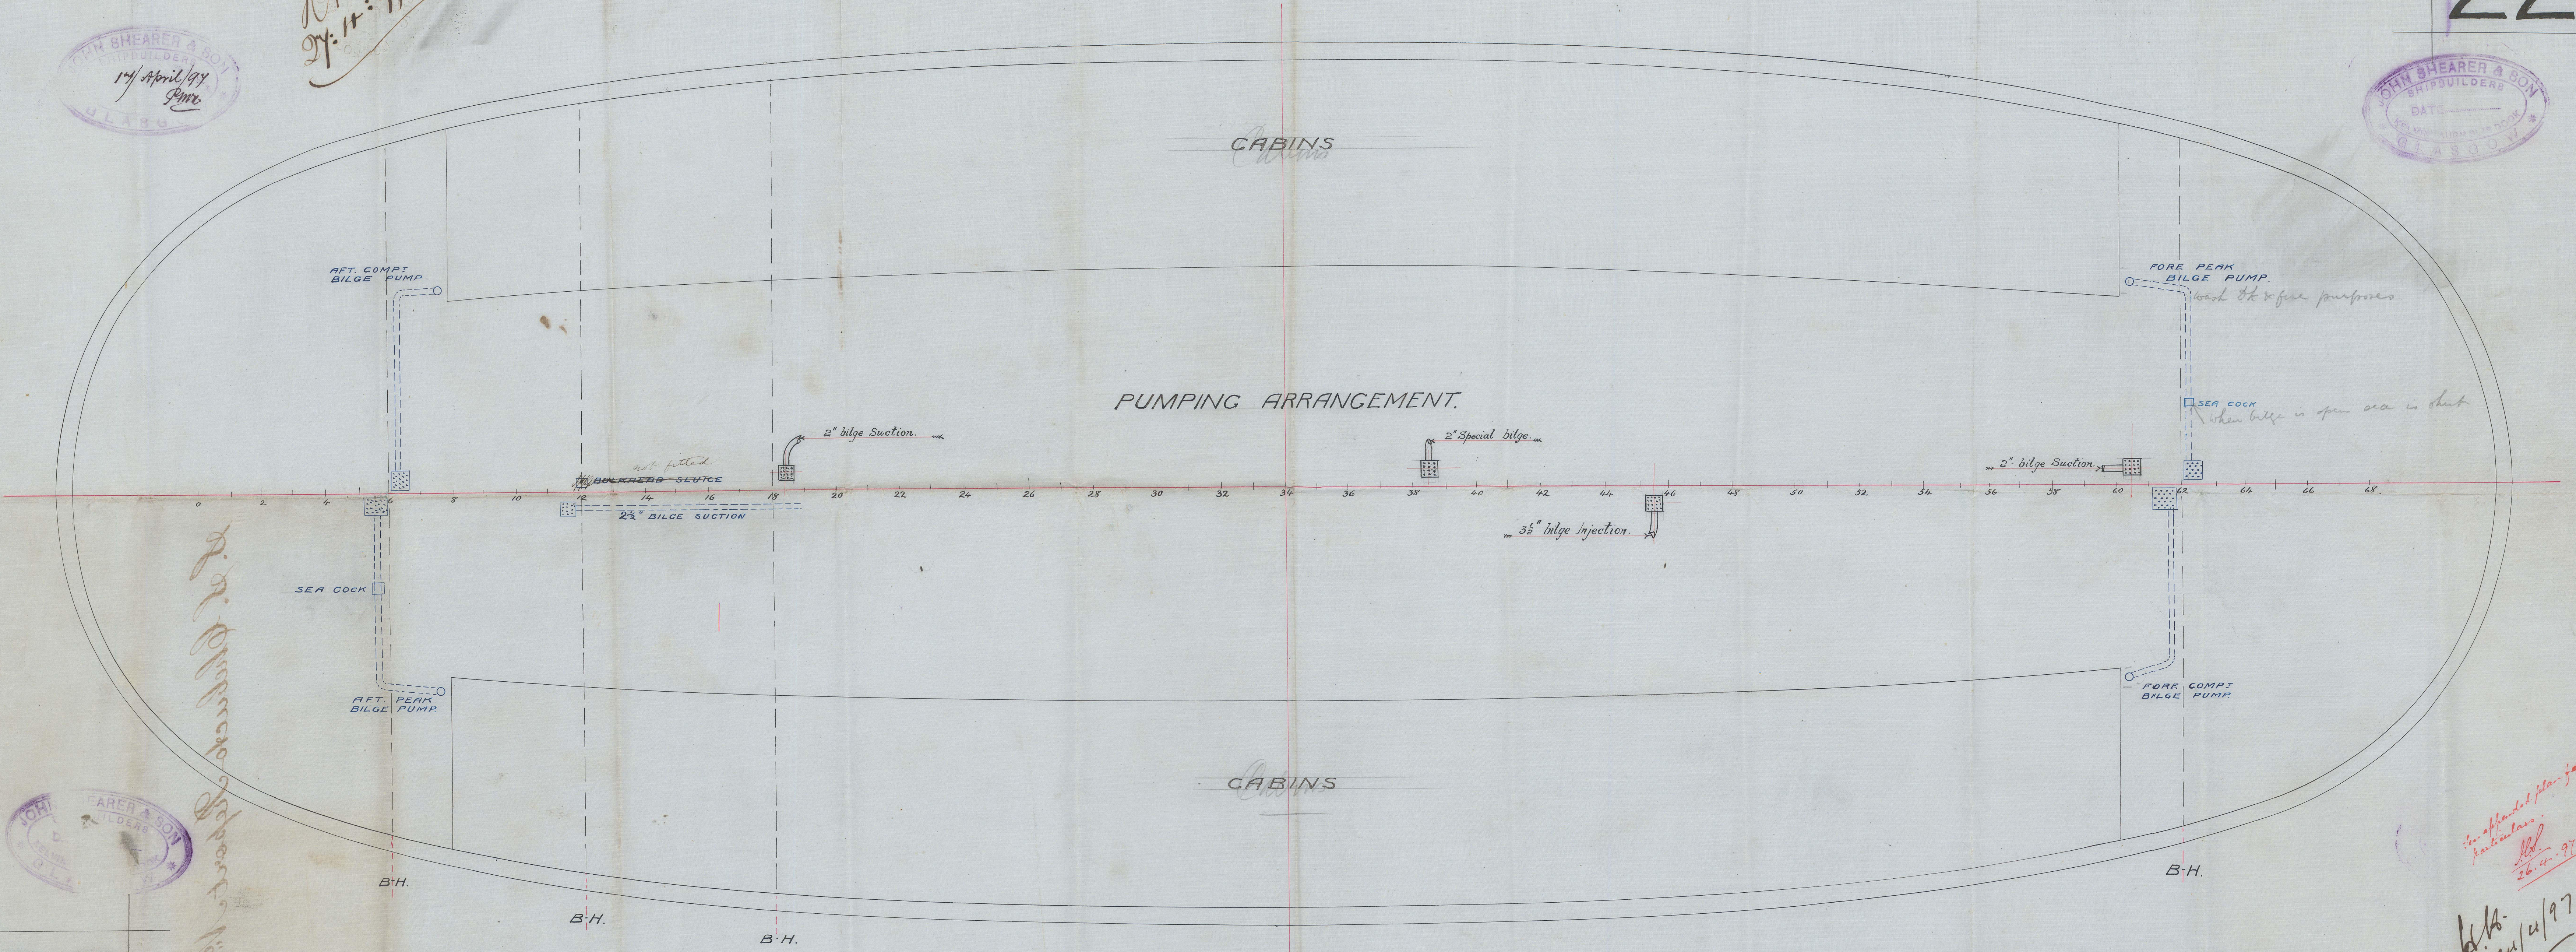

JOHN SHEARER & SON
SHIPBUILDERS
GLASGOW

P.D. Shearer Report 10/1/97

*See appended plan for further
particulars.
26.4.97*

22/4/97

SS



S. S. Chebucto Report No. 15427

NEW COCK

BIG BOMB
BIG BOMB
BIG BOMB

B.I.B



© 2021

Lloyd's Register
Foundation