

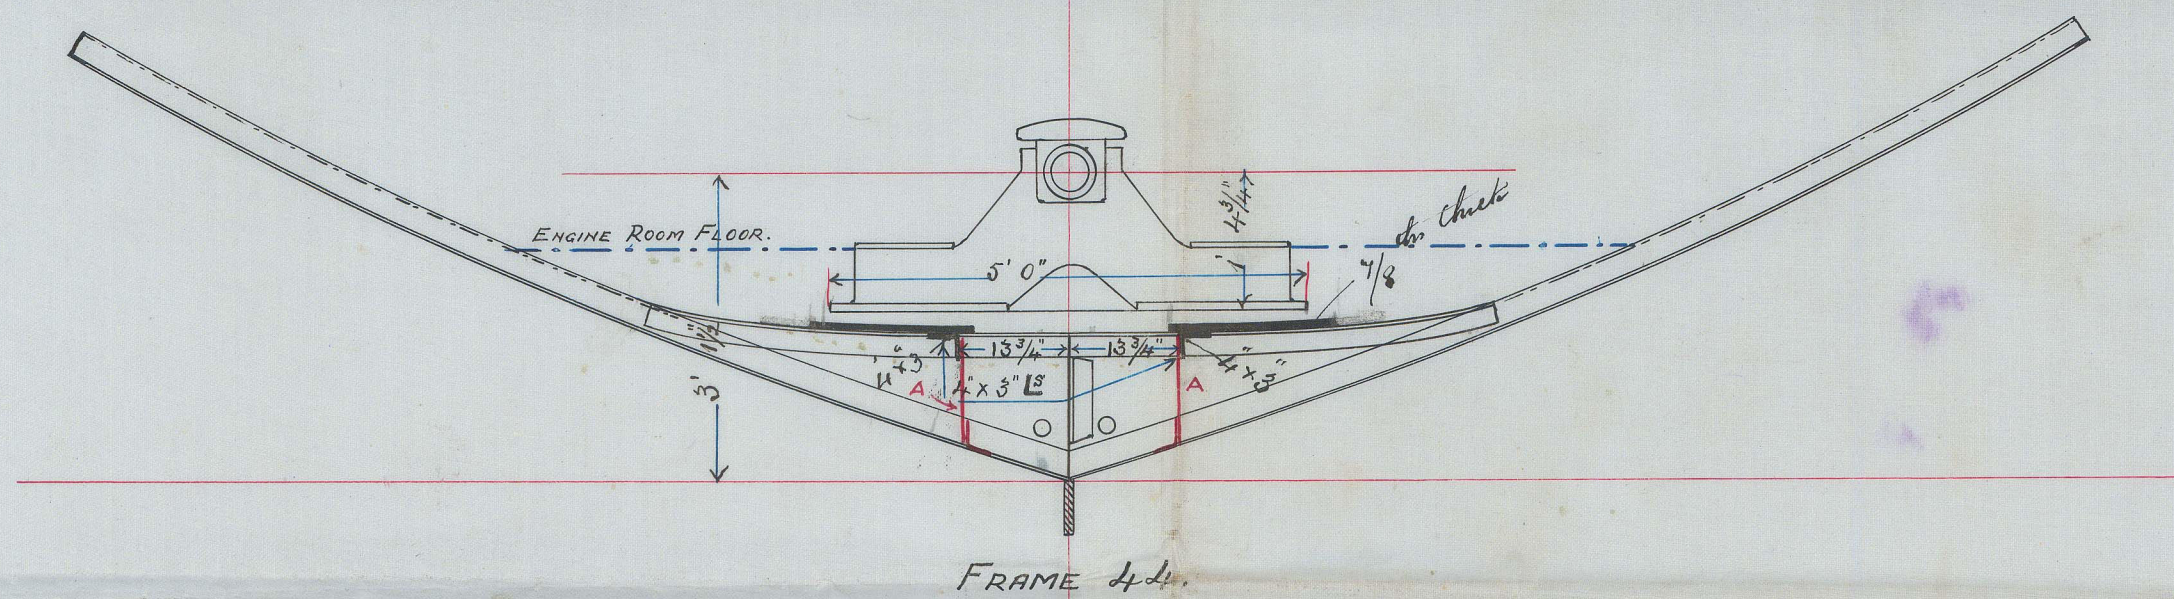
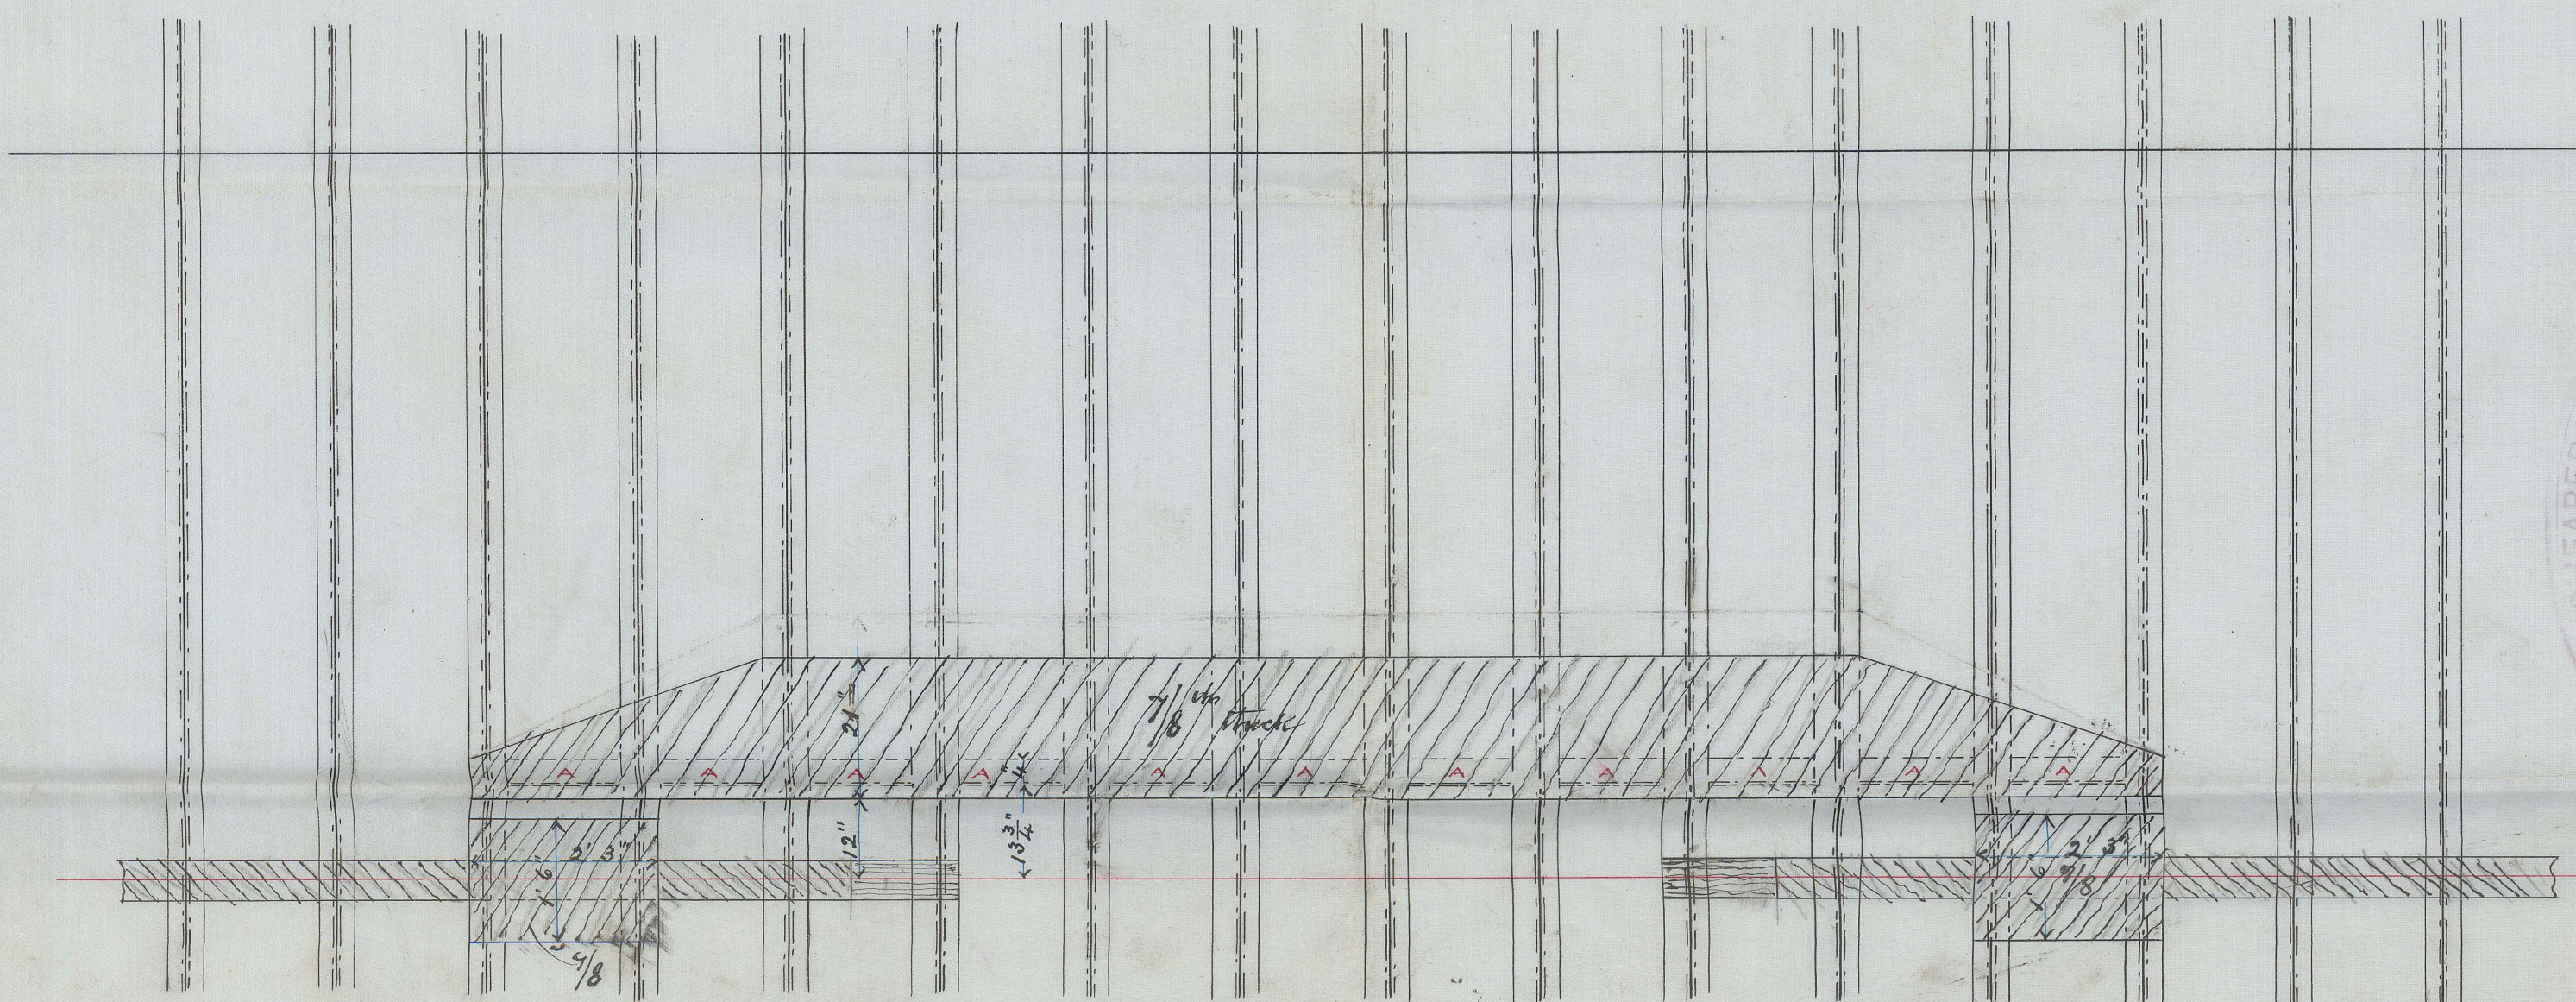


*Proposed Arrangement of Engine Seating - "Standard" &c.*

PROPOSED ARRANGEMENT OF ENGINE SEATING,  
AND  
KEELSON IN WAY OF SAME.  
S.S. N<sup>o</sup> 22.

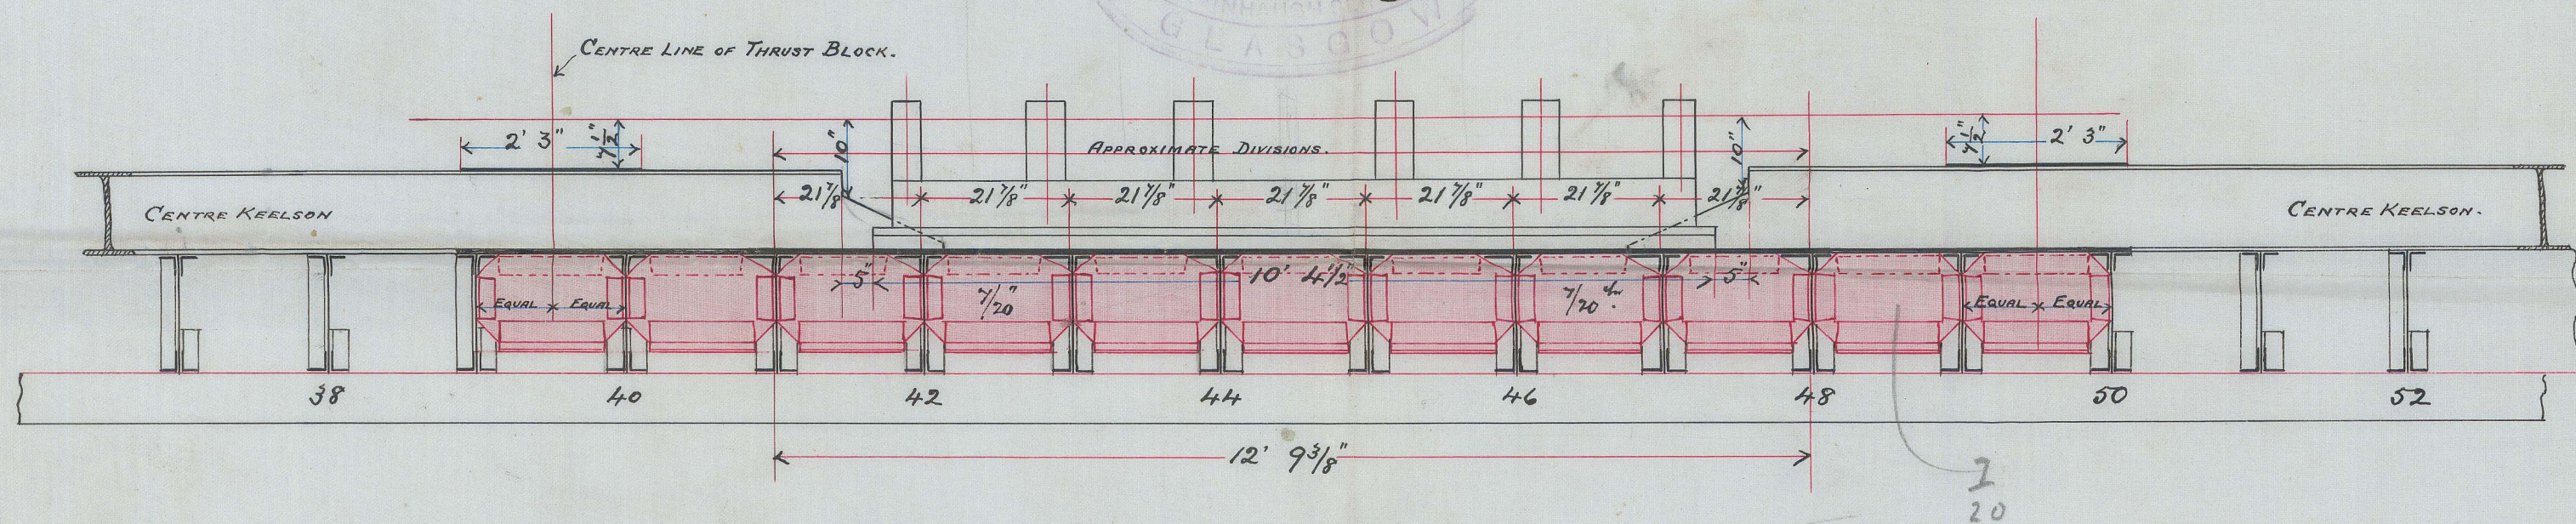

SCALE :  $\frac{1}{2}$  INCH = 1 FOOT.

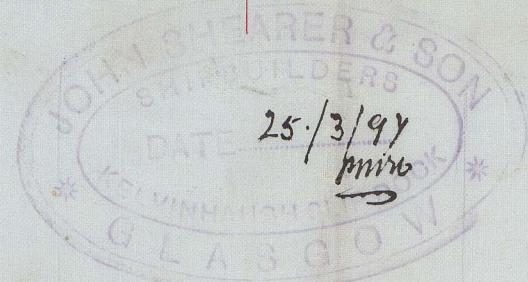


© 2021 Lloyd's Register Foundation



S.S. Chebucto - Report No. 15427

PROPOSED ARRANGEMENT  
AND  
KEELSON

S.S. 22

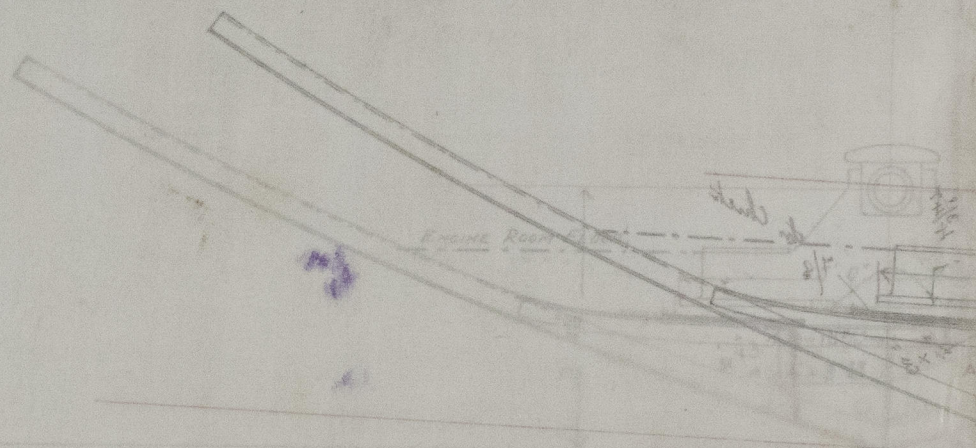



2' 8"

Centre Keelson



© 2021

Lloyd's Register  
Foundation