

# PROFILE & PLAN OF FERRY BOAT FOR DARTMOUTH.


## DIMENSIONS.

LENGTH OVER ALL	140' 0"
DO. B.P.	125' 0"
BREADTH OVER ALL	50' 0"
DO. MOULDED	33' 0"
DEPTH DO.	13' 7"

FOR FERRY SERVICE BETWEEN DARTMOUTH & HALIFAX. - NOVA SCOTIA. -

SCALE: 1/4 INCH = 1 FOOT.

ENGINE & BOILER CASING.

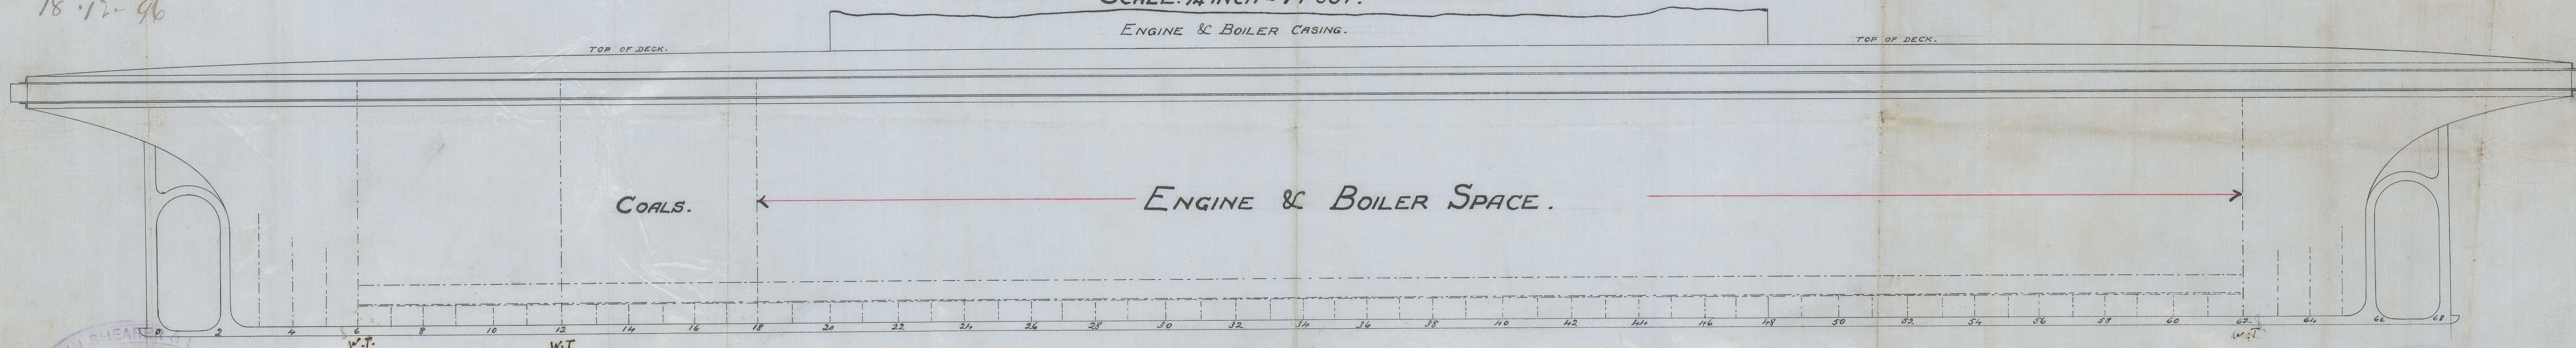

OPEN HOUSES.


ENGINE & BOILER CASING.

All beams where practicable to be carried whole from side to side across opening.  
Funnel only where interfere - plan will rest. when Engineer arrangements complete.  
J.S.T. - R.M.

18/12/96

18/12/96



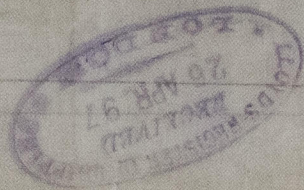

S.S. "Chebucto" - Report - N<sup>o</sup> 15427  
J. Shearer & Sons N<sup>o</sup> 22






ENGINE ROOM



© 2021

Lloyd's Register  
Foundation

465262-0132