


FERRY SERVICE BETWEEN DARTMOUTH AND HALIFAX. NOVA-SCOTIA

TO CLASS 100 A.1

SCALE:  $\frac{1}{2}$  INCH = 1 FOOT.

Ferrisville Dartmouth & Halifax. N.S.

18.12.96

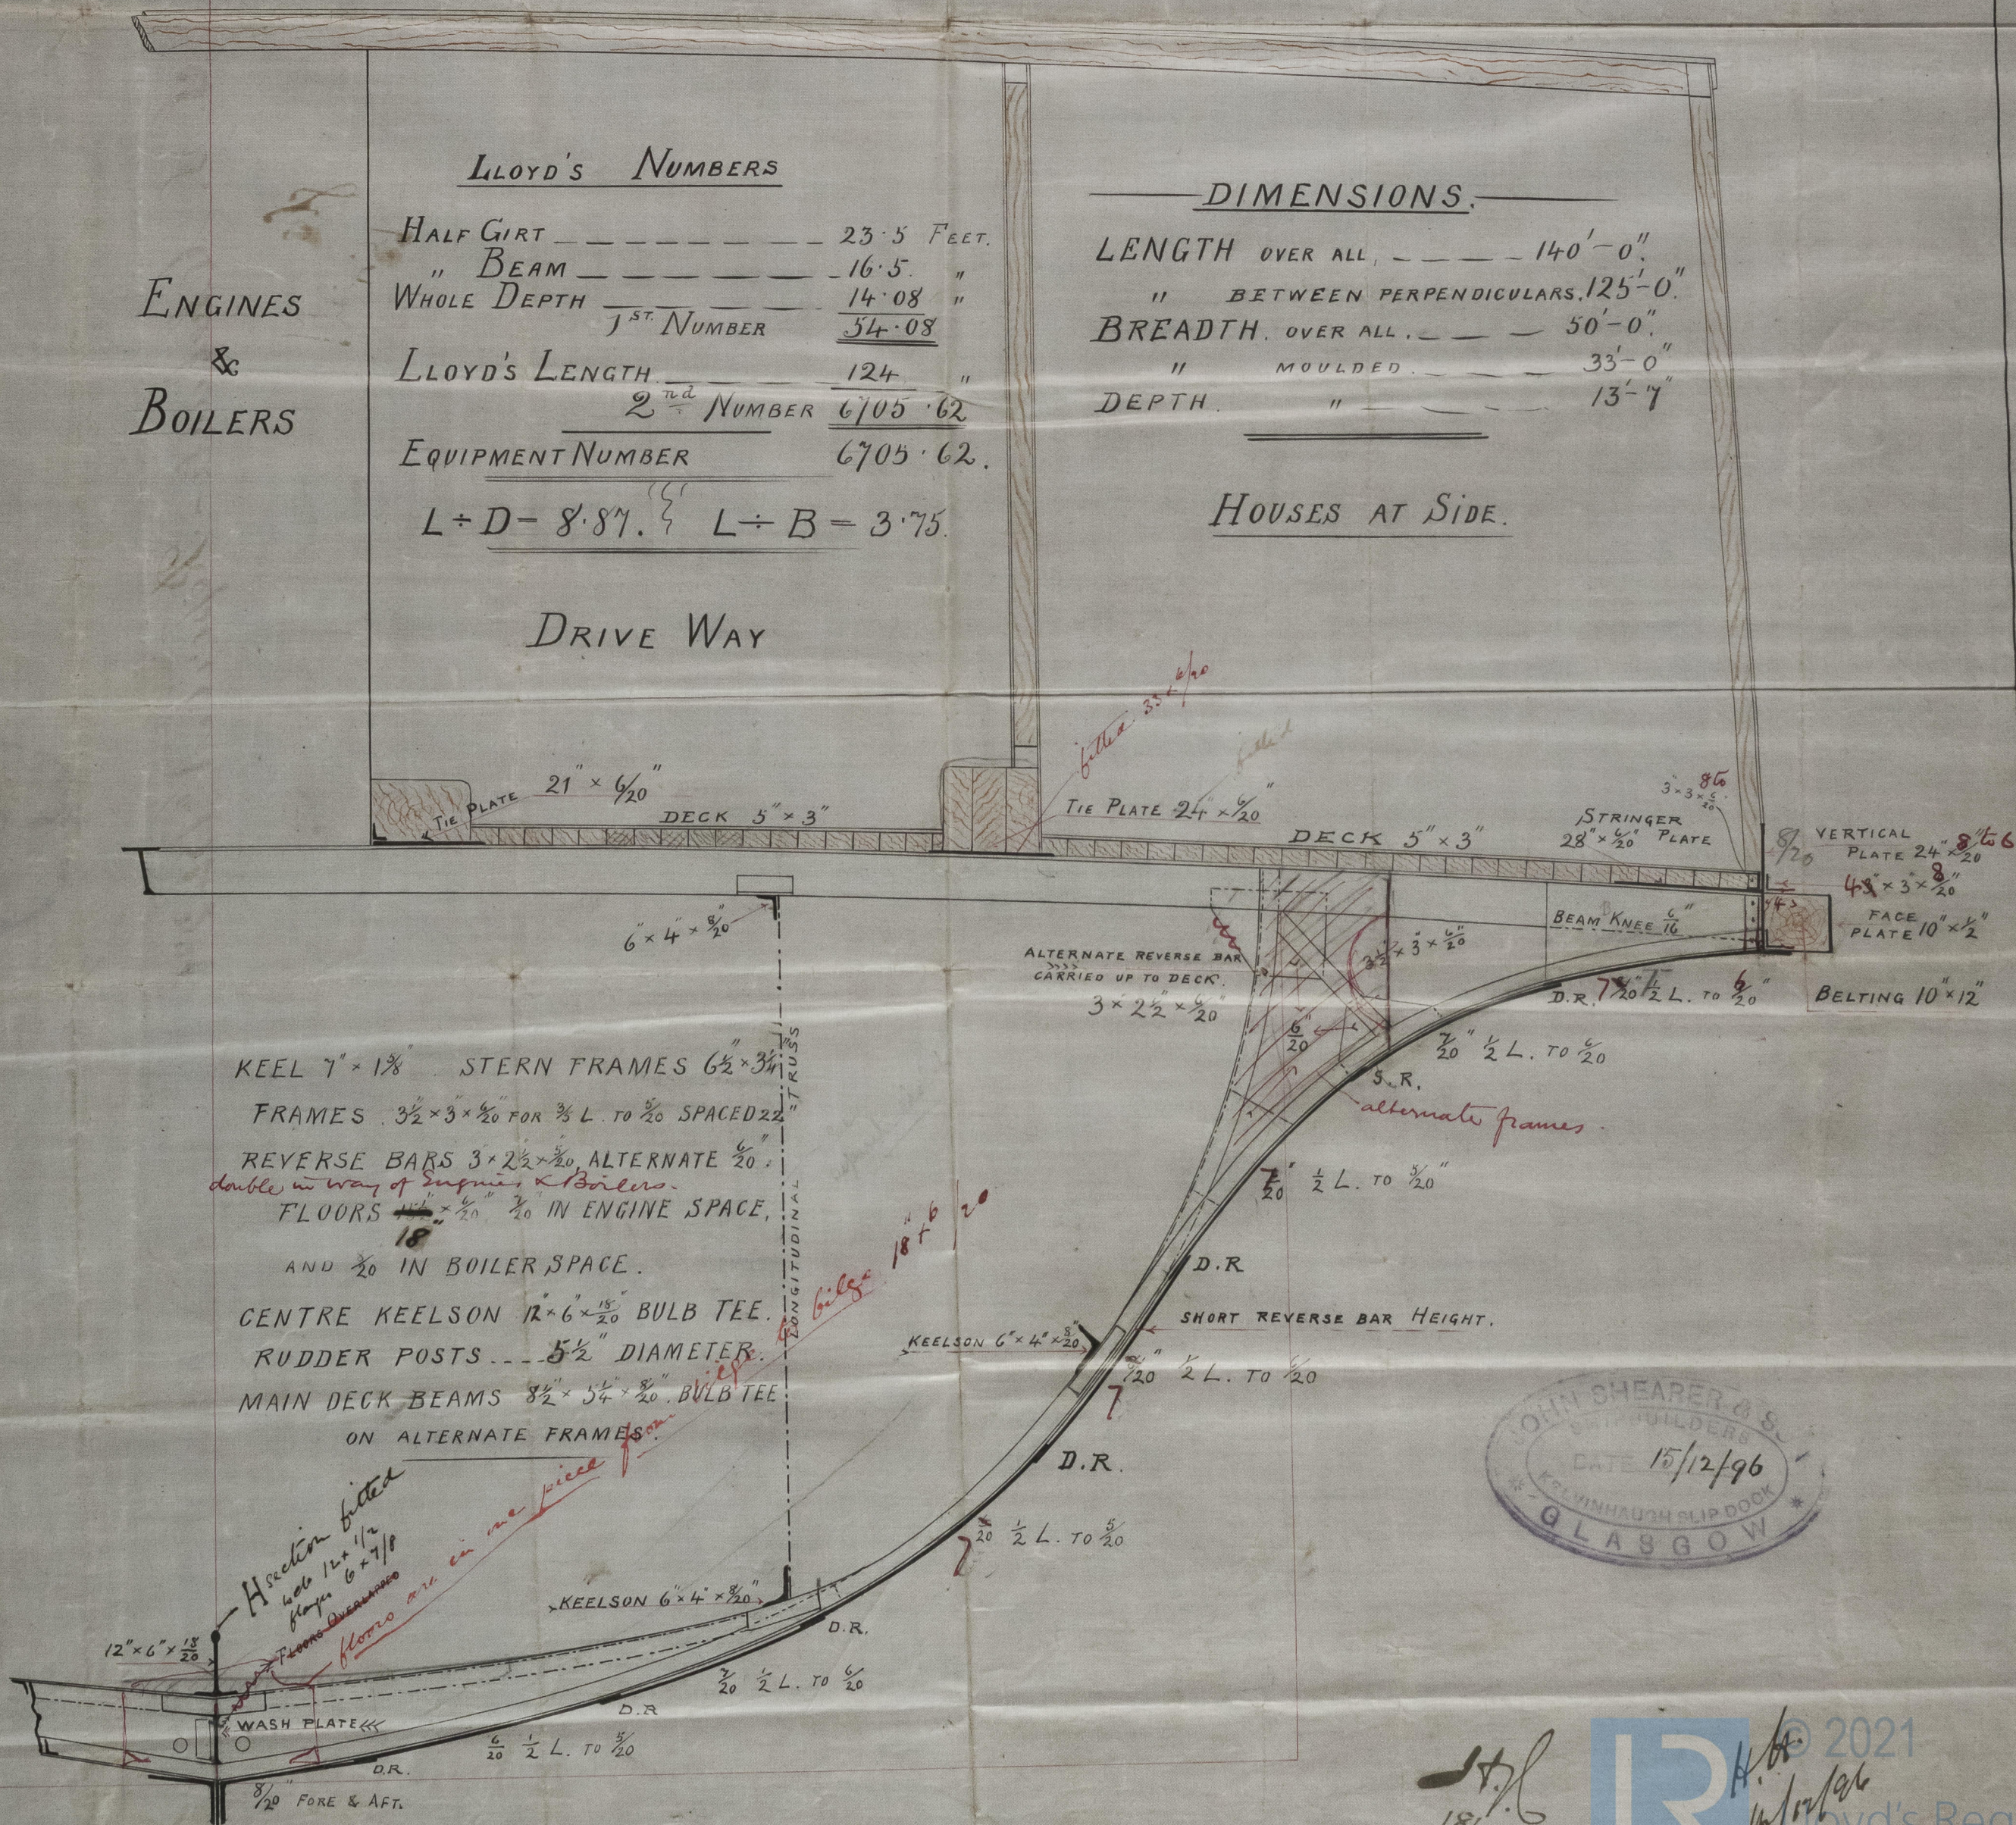

JOHN SHEARER & SONS  
SHIPBUILDERS  
GLASGOW  
KELVINHAUGH SLIP DOCK  
DATE 15/12/96


18/12/96

© 2021  
Lloyd's Register  
Foundation

6LS262-0135



J. Shearer's No 22

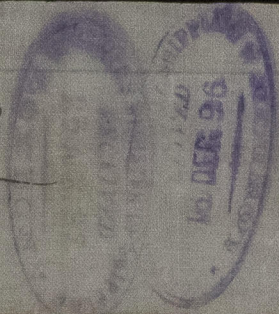

S. S. Chelucto-Report No 15424

gls  
15/12/96

DRIVE WAY  
T+D 21.1 L+B 9.1  
EQUILIBRIUM NUMBER  
CLIP  
15/12/96  
14.01  
13.9  
13.9

15/12/96  
13.9  
13.9  
13.9



Handwritten notes in red ink, possibly 'H. 15/12/96'.



45262-0135