


23. 11. 96

2. 2. 97

S.S. No 290  
Proposed Re-Arrangement of Beams in F+B Space  
Scale 1/8" = 1 Foot.

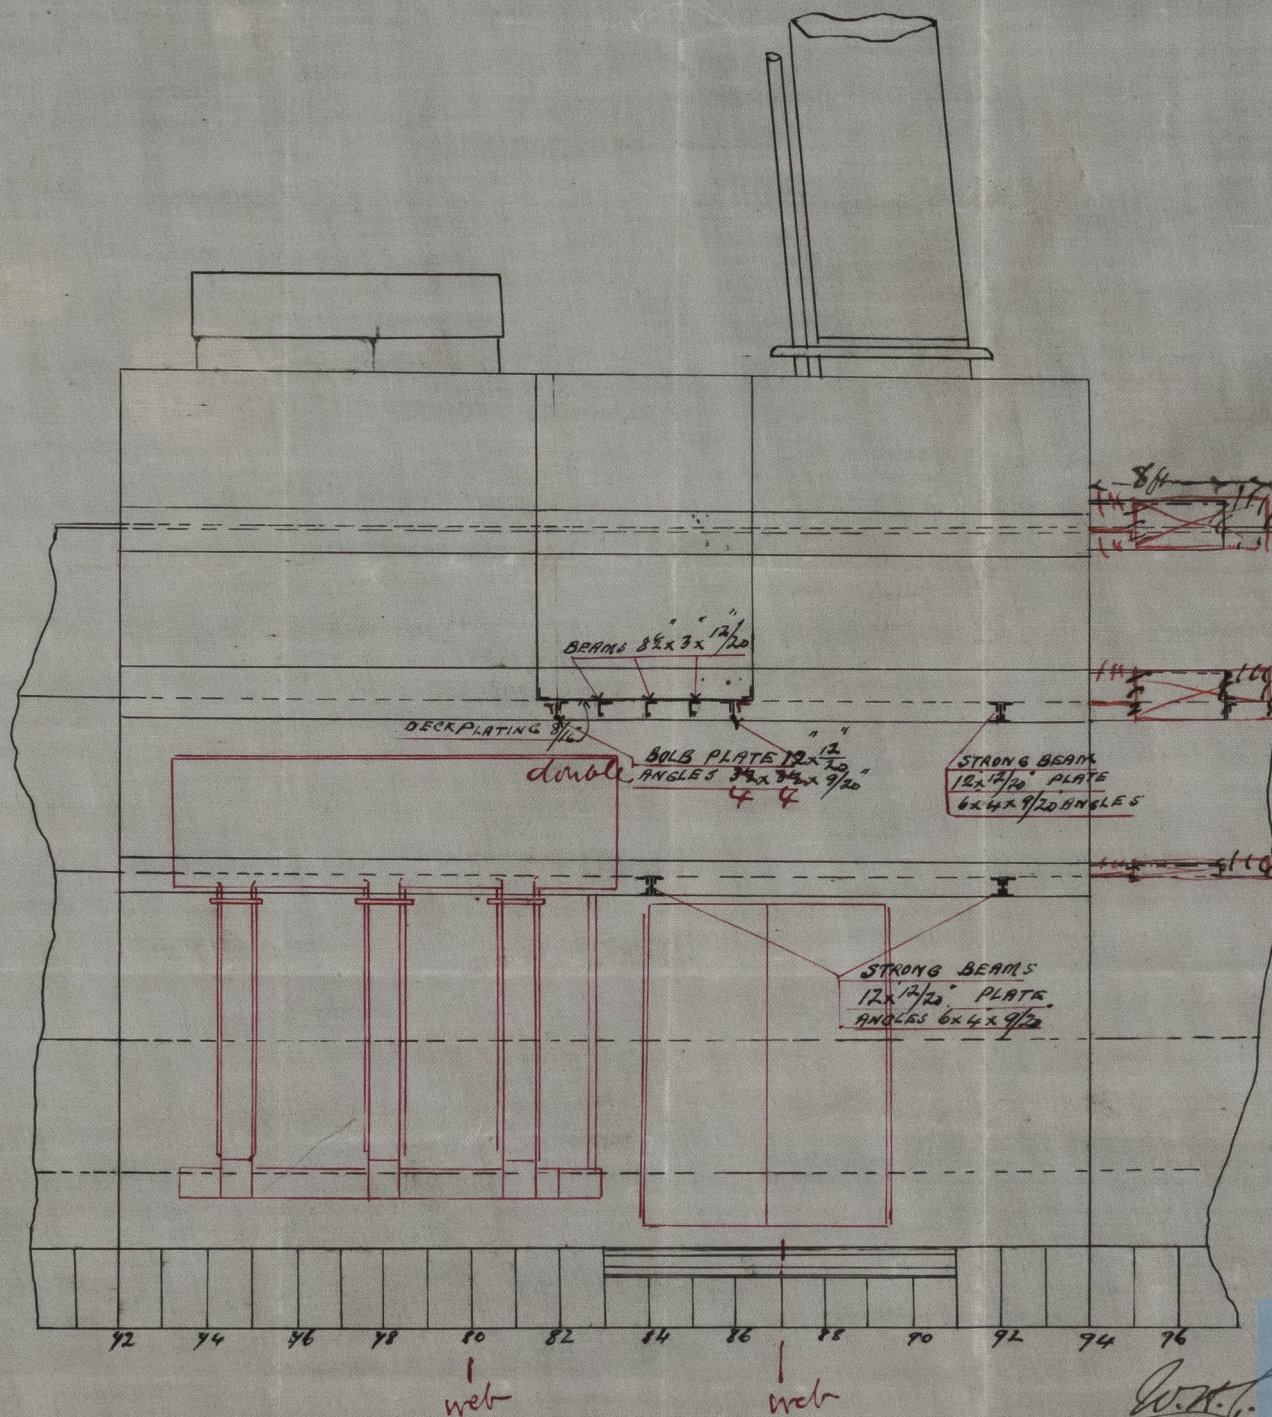

14/11/96  
Reg. No. 2919.  
Lloyd's Register  
Foundation  
GLS263-0120



23.11.96  
2.2.97

290

GLS263-0120



© 2021  
Lloyd's Register  
Foundation

GLS263-0150

*[Handwritten notes and signatures in the bottom left corner, including '2.2.97' and '2.2.96']*