
 


*SS No 290*  
Re-arrangement of Boiler Hatch shewing  
Compensation in way of opening. Main Deck  
Scale  $\frac{1}{8} = 1$  Foot.

2. 2. 97

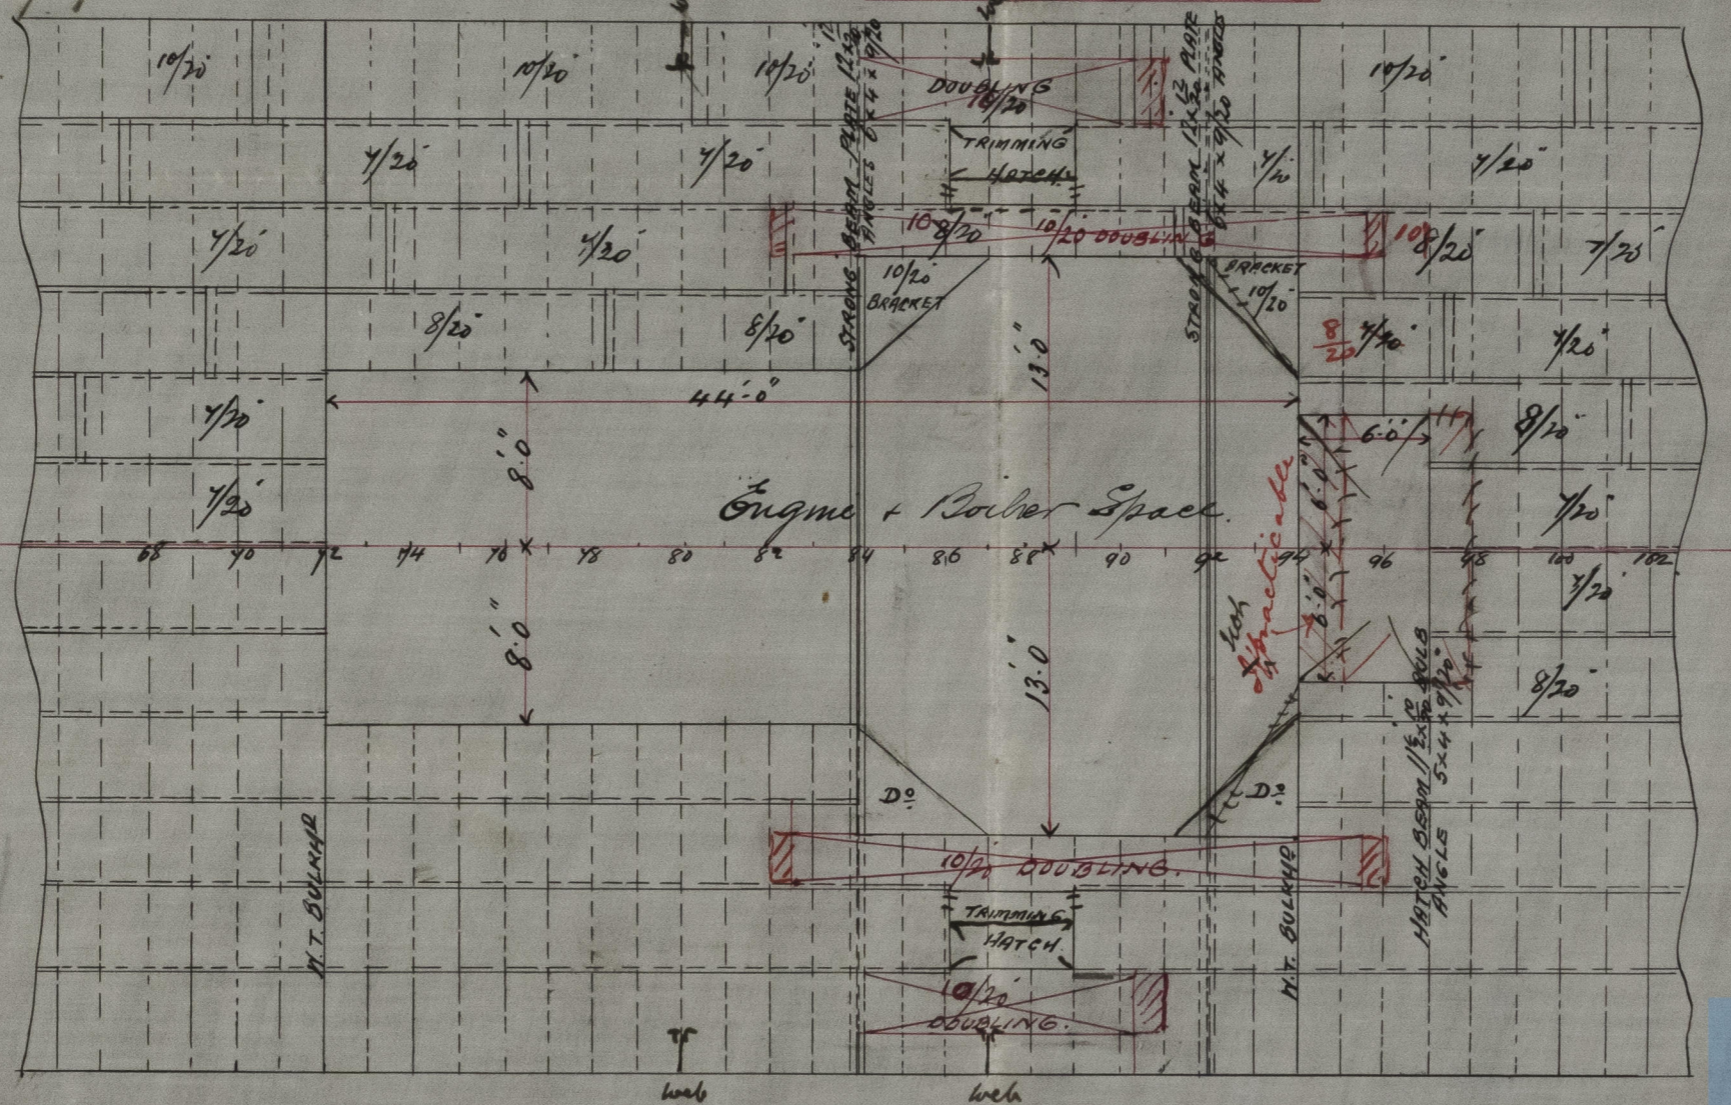

© 2012  
 Lloyd's Register  
 Foundation

GLS263-0125

for 29/1/97

S. S. Kassala, Glasgow Report  
 Ex Bopung.  
 No 15334.

