



As made

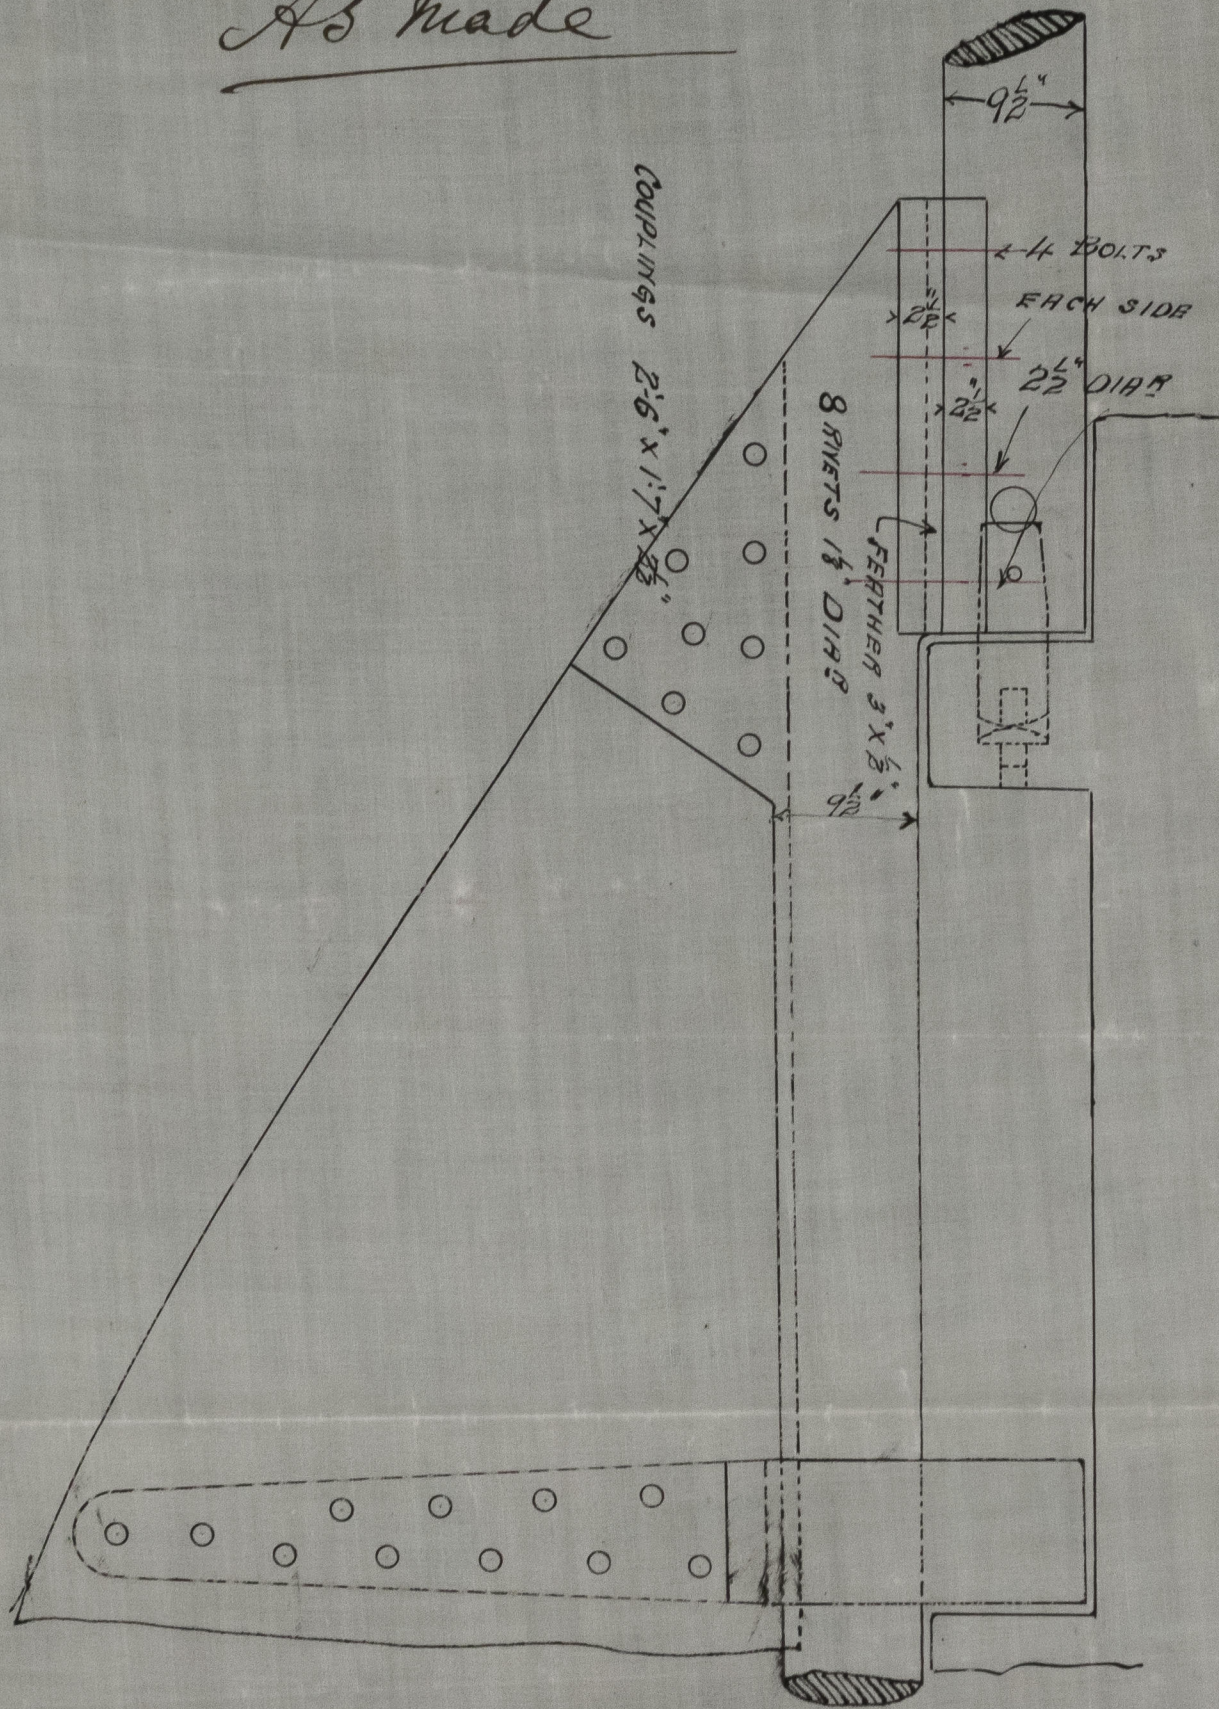

S.S. No. 290

Sketch of Rudder Coupling (Modified)

Scale 1" = One Foot

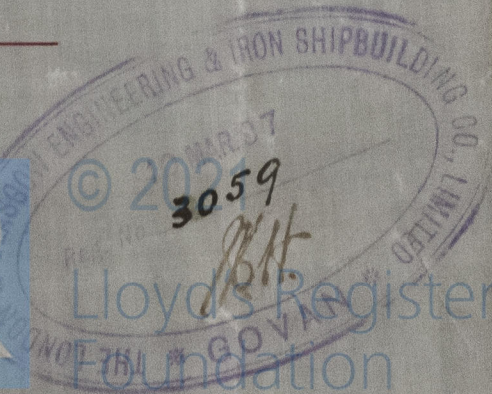

GLS263-0129