



Handwritten notes:
 "Amended Plan as built"
 1883

Amended Plan as built

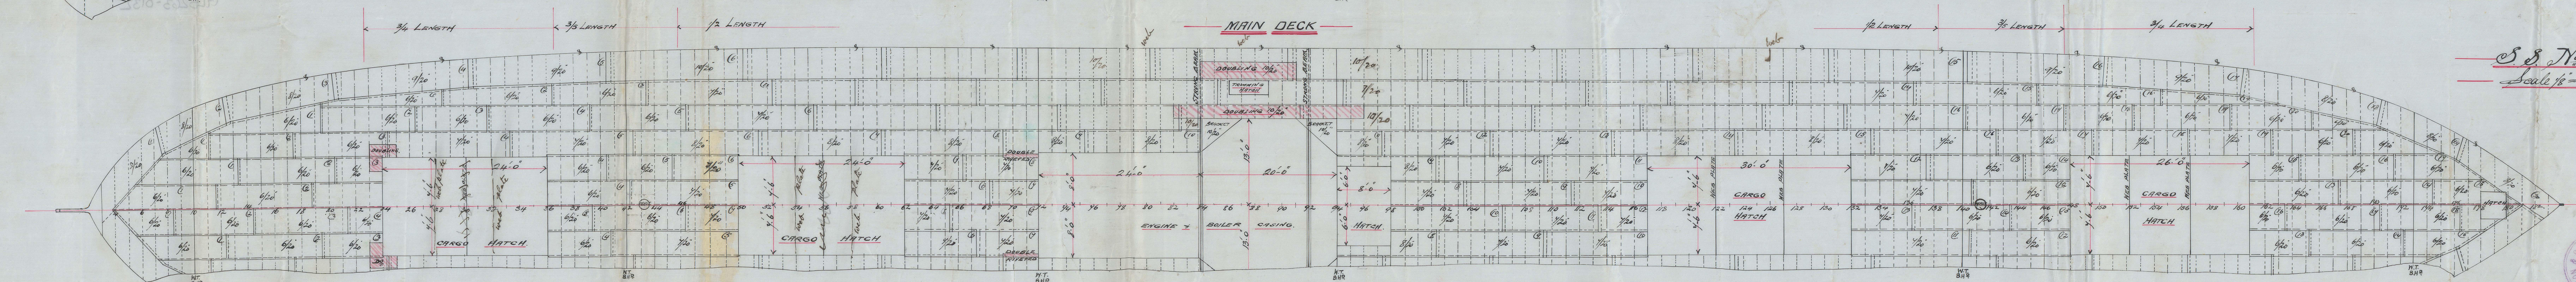

S.S. No 290
 Scale 1/8" = 1 Foot.

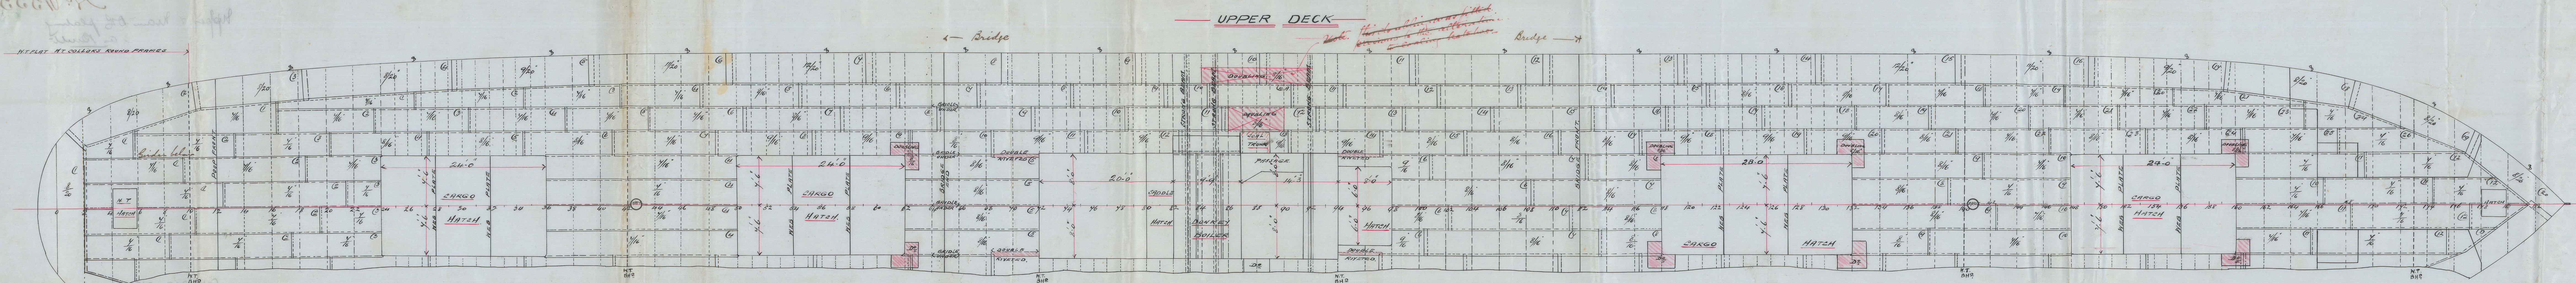

S.S. "Kassala" Glasgow Report

No. 11553/1.

Upper & main DB plating
as Built

